




EAST ELEVATION
Scale 1:120

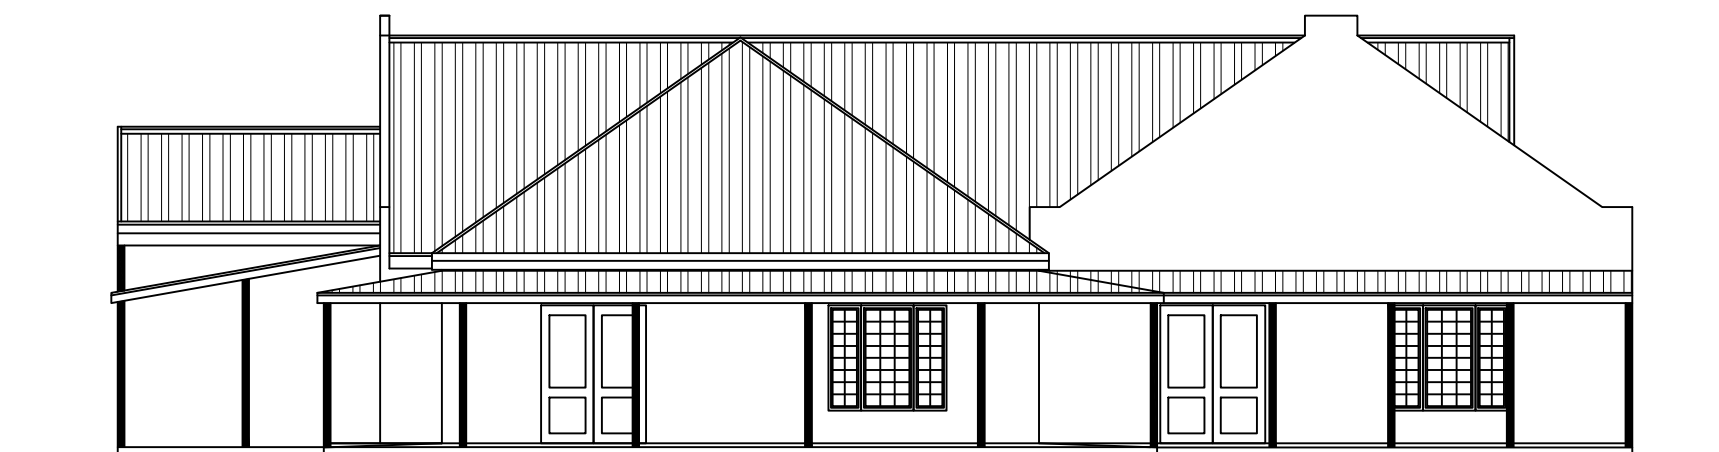

NORTH ELEVATION
Scale 1:120

**N.GENADE
 ARCHITECTURAL
 DRAUGHTING & DESIGN
 SERVICES**

PO BOX 346
 KNYSNA 6570
 CELL : 082 215 7709
 TEL : 044-3822673
 FAX : 044-3825086
 E.MAIL : ngenade@gmail.com

PROJECT
**AS BUILT STRUCTURES
 ERF 4308
 SCARAB MARKET
 SEDGEFIELD**

CLIENT
GRIBBON TRADING 39cc

TITLE
MAIN BUILDING - ELEVATIONS

SCALE
1:120

DRAWINGS: N.GENADE

<small>DRW. NO.</small>	<small>REV.</small>	<small>DATE</small>
N005/03/2019	00	11-03-2019