


WEST ELEVATION
Scale 1:120

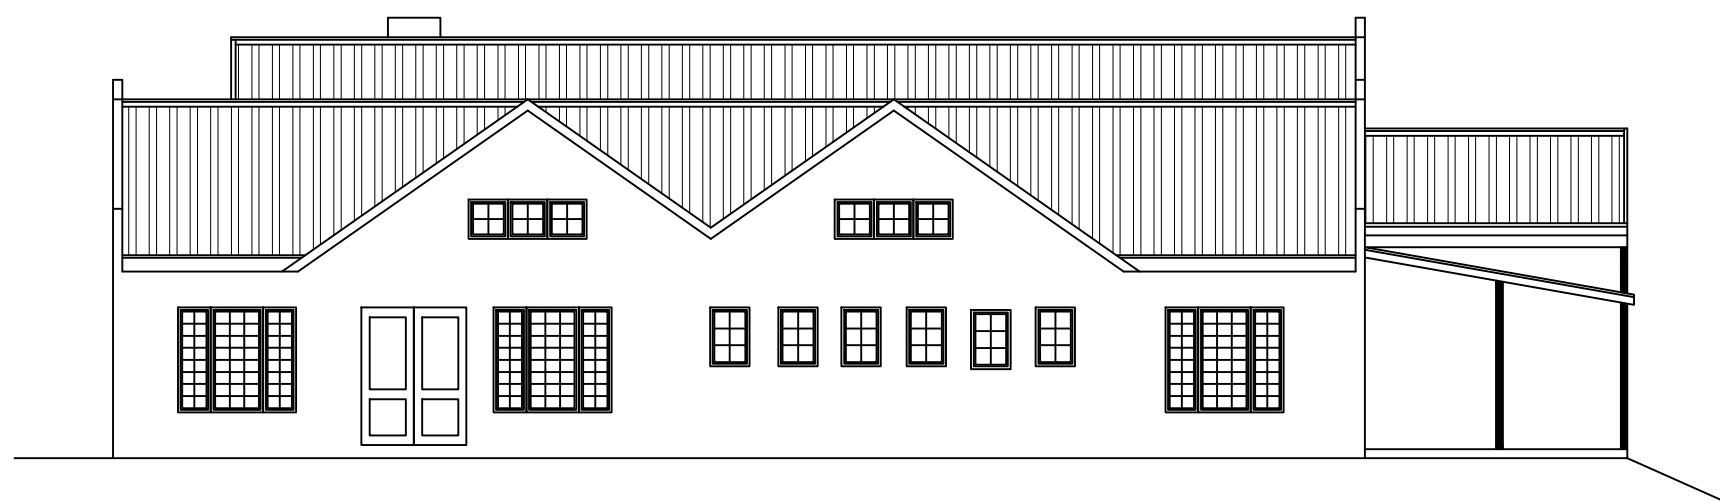

SOUTH ELEVATION
Scale 1:120

**N.GENADE
 ARCHITECTURAL
 DRAUGHTING & DESIGN
 SERVICES**

PO BOX 346
 KNYSNA 6570
 CELL : 082 215 7709
 TEL : 044-3822673
 FAX : 044-3825086
 E.MAIL : ngenade@gmail.com

PROJECT
 AS BUILT STRUCTURES
 ERF 4308
 SCARAB MARKET
 SEDGEFIELD

CLIENT
 GRIBBON TRADING 39cc

TITLE
 MAIN BUILDING - ELEVATIONS

SCALE
 1:120

DRAWINGS: N.GENADE

DRW. NO.	REV.	DATE
N005/03/2019	00	11-03-2019