



NOTES:

	Existing floor area under roof (sq m)	AS BUILT DECK >1m above NGL (sq m)	Total floor area (sq m)	Coverage Actual vs. Permissible areas (sq m)	Area of site (sq m)
First Floor	177	18	195	Permissible = 261 (50% of site area)	522
Ground Floor	182	0	182		
Totals	359	18	377	Actual = 200 (38% of site area)	

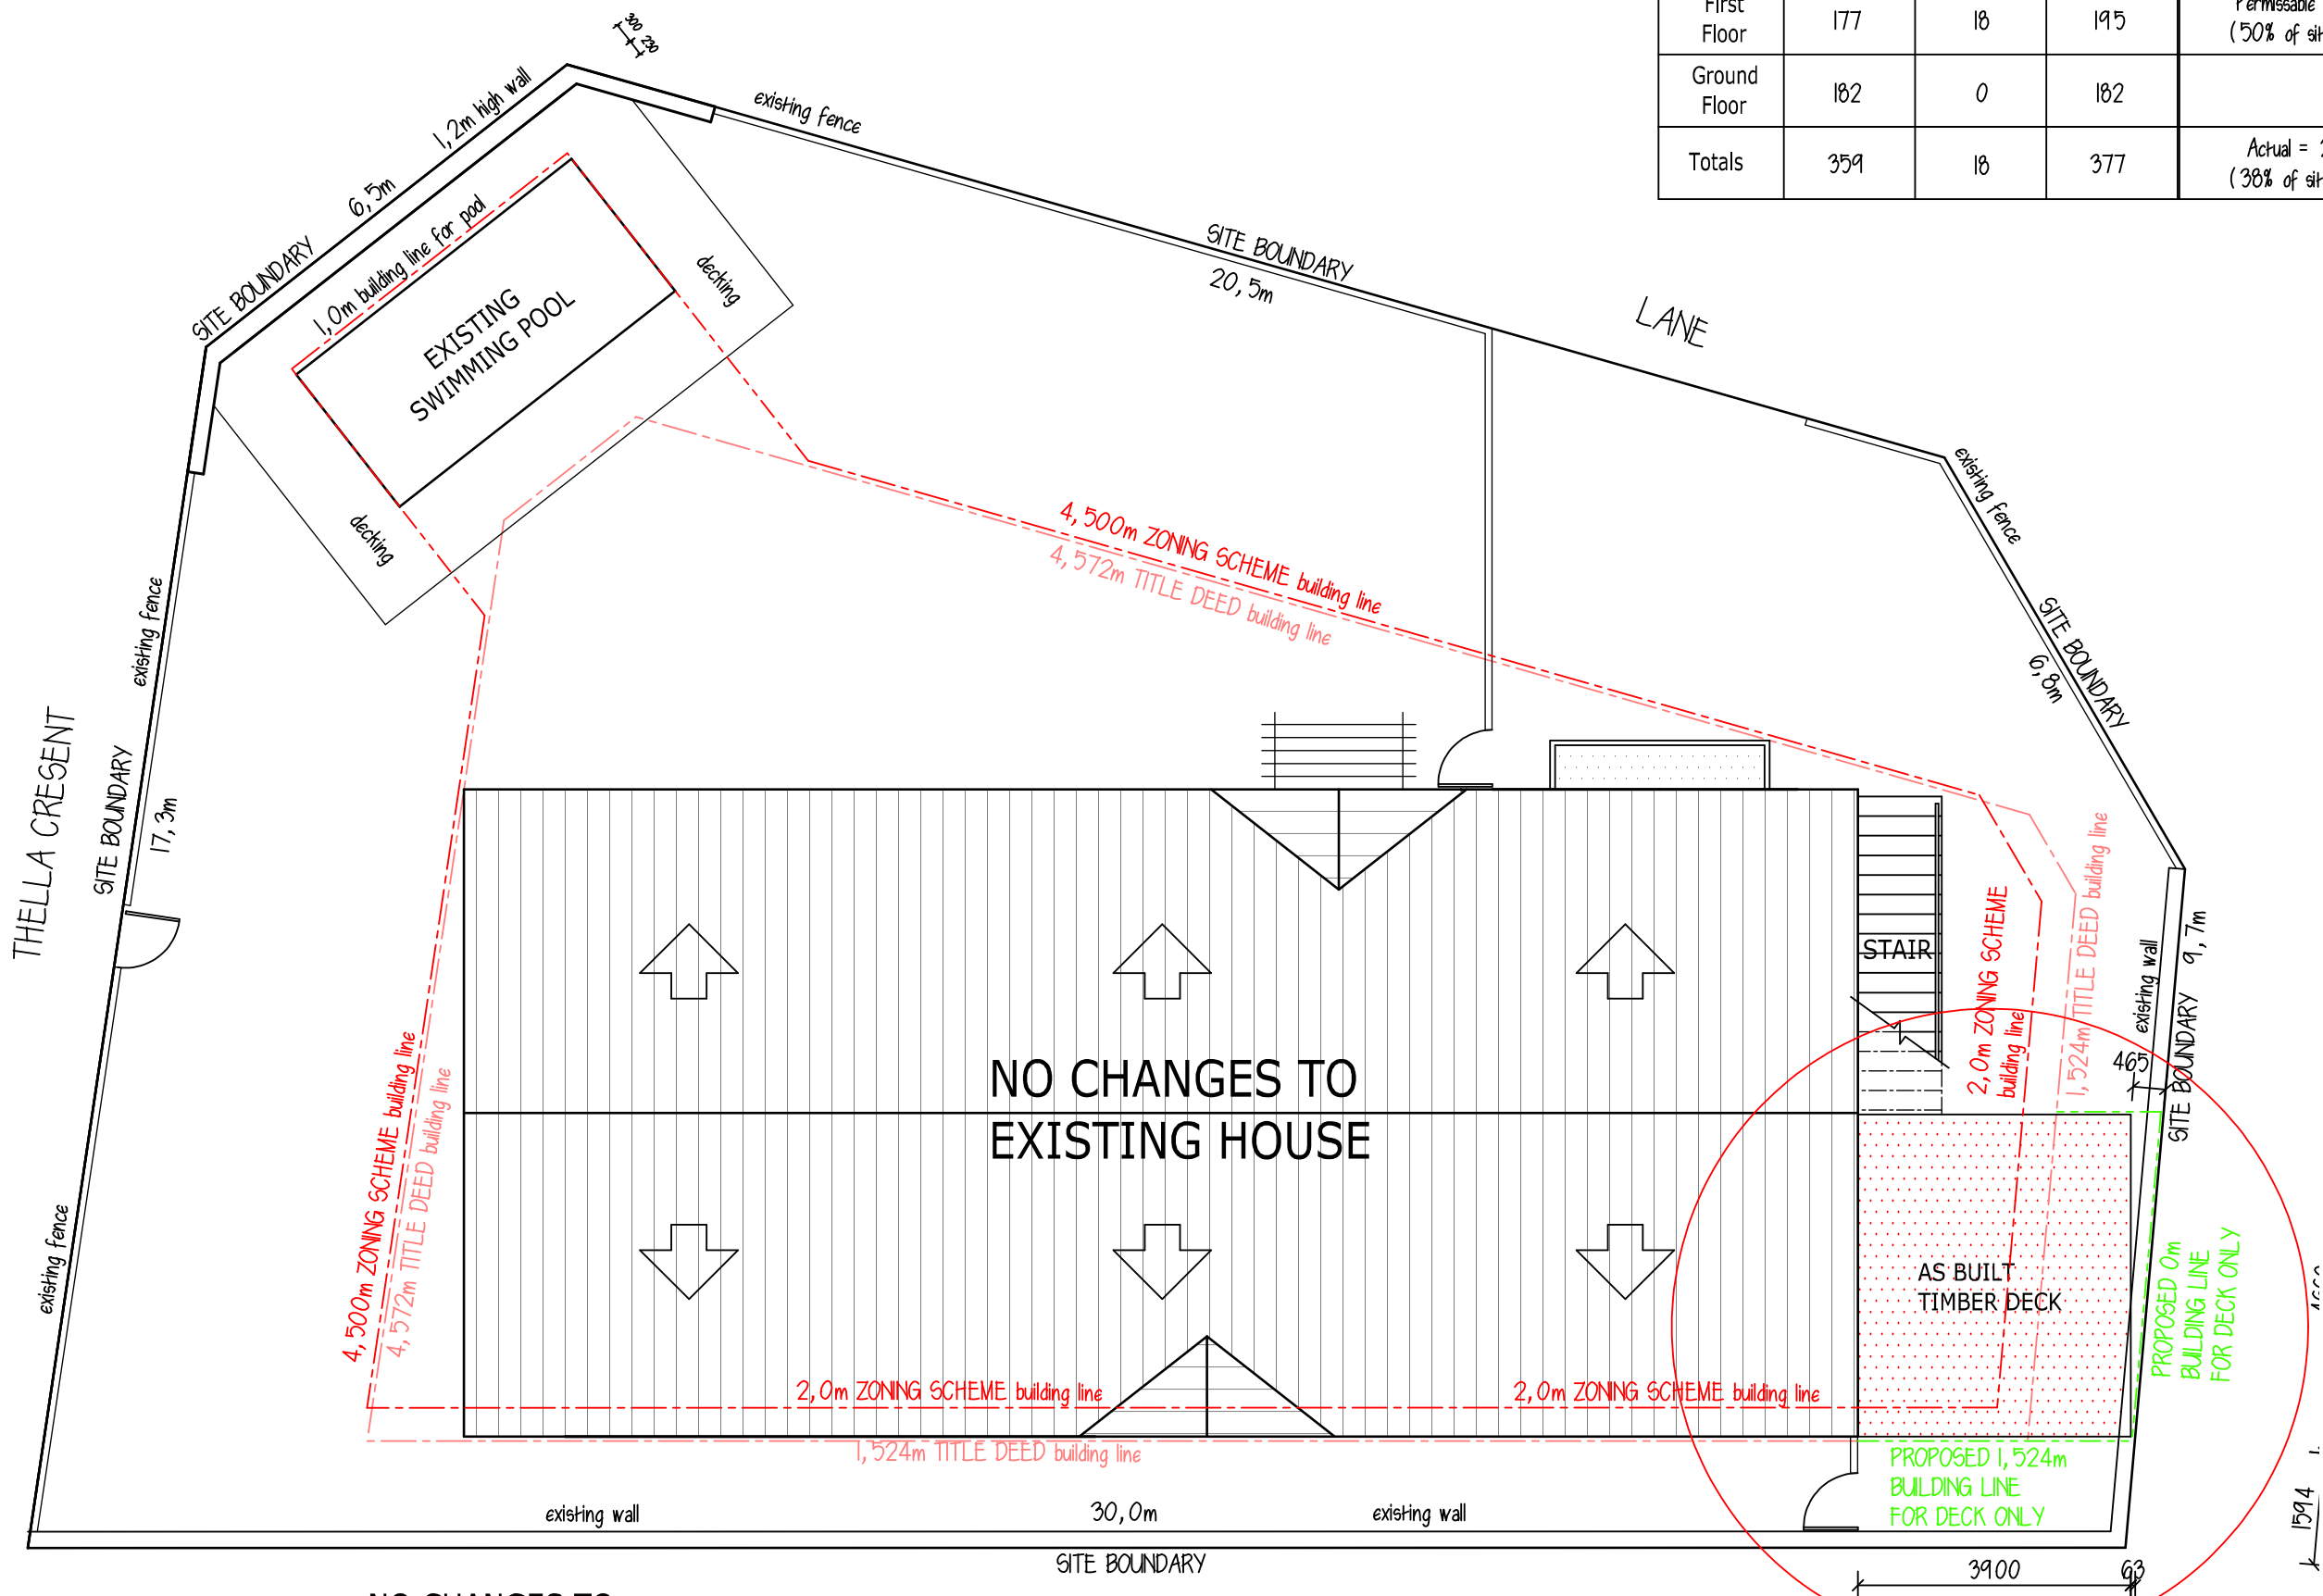

NO CHANGES TO ELECTRICAL OR PLUMBING

ROOF & DRAINAGE PLAN
SCALE 1:100

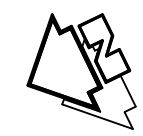

Frankenfeld & King
ARCHITECTS

The Art Centre Montagu St PO Box 3472 Knysna 6570
tel/fax: 044 382 7905 cell: 082 338 9210
email: andrew@fkarchitects.co.za

HOUSE STEENKAMP
AS BUILT DECK
ERF 1918 LEISURE ISLE
KNYSNA

PROJECT No.: 1477 REVISION
DWG No.: 100 - DEPARTURE
SCALE: 1:100
DATE: APR 2022

This drawing and design is copyright and must not be reproduced in part or in whole without prior written consent. Contractors must verify all dimensions on site before commencing work or preparing shop drawings.