


Site Development Plan

Area of concern – refer to Annexure H

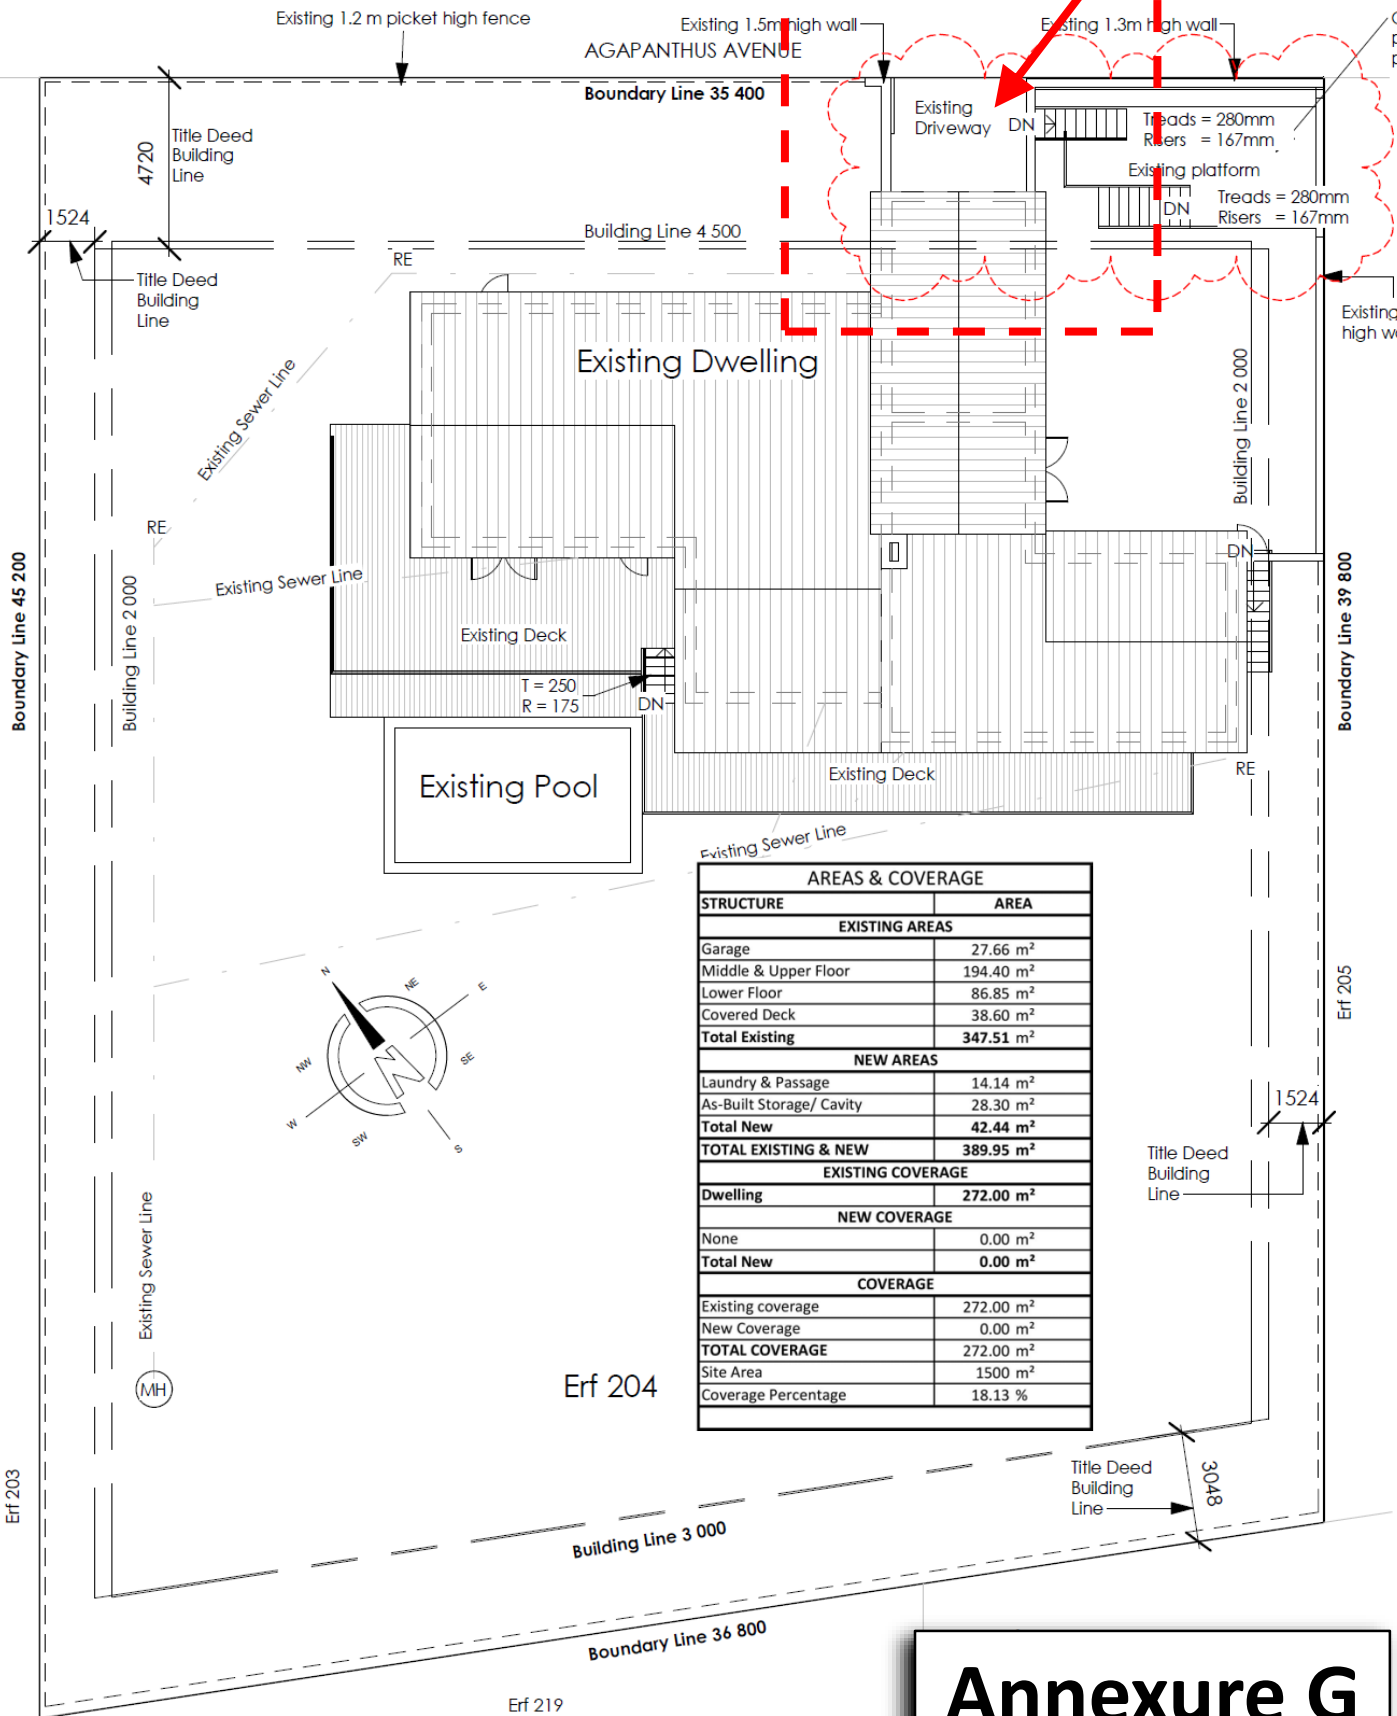

AREAS & COVERAGE	
STRUCTURE	AREA
EXISTING AREAS	
Garage	27.66 m ²
Middle & Upper Floor	194.40 m ²
Lower Floor	86.85 m ²
Covered Deck	38.60 m ²
Total Existing	347.51 m²
NEW AREAS	
Laundry & Passage	14.14 m ²
As-Built Storage/ Cavity	28.30 m ²
Total New	42.44 m²
TOTAL EXISTING & NEW	389.95 m²
EXISTING COVERAGE	
Dwelling	272.00 m ²
NEW COVERAGE	
None	0.00 m ²
Total New	0.00 m²
COVERAGE	
Existing coverage	272.00 m ²
New Coverage	0.00 m ²
TOTAL COVERAGE	272.00 m²
Site Area	1500 m ²
Coverage Percentage	18.13 %

Annexure G