

first floor plan

House EYE
Erf 4849, Coney Glen Drive
The Heads, Knysna

Drawing for 3rd storey departure application

Trevor Griffin
Architect

SCALE 1:200 DATE Nov 2022



PO Box 693

Knysna 6570

Tel: 044-3820673

Cell: 082-4476886

E-mail: trevgriff@mweb.co.za

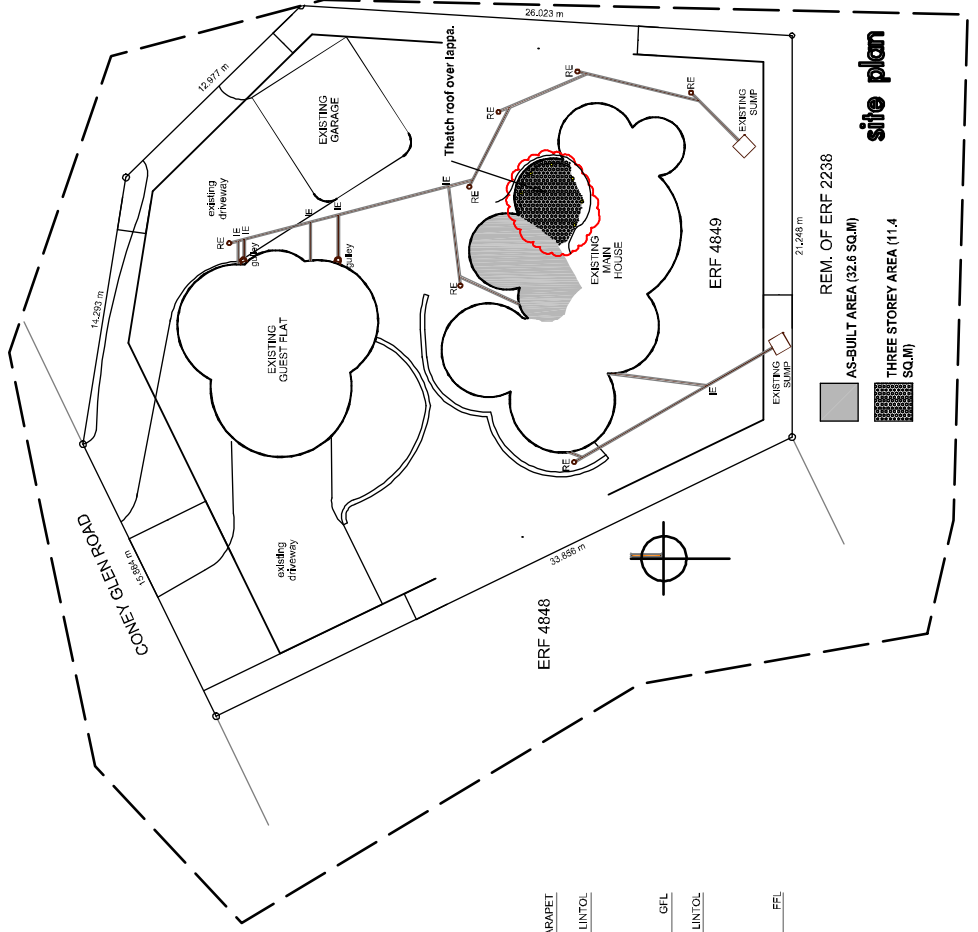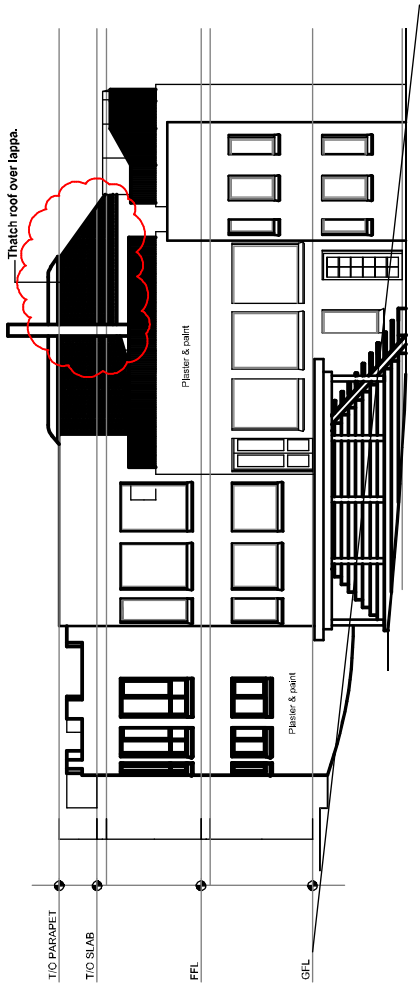


site plan

REM. OF ERF 2238

AS-BUILT AREA (32.6 SQ.M)

THREE STOREY AREA (11.4 SQ.M)

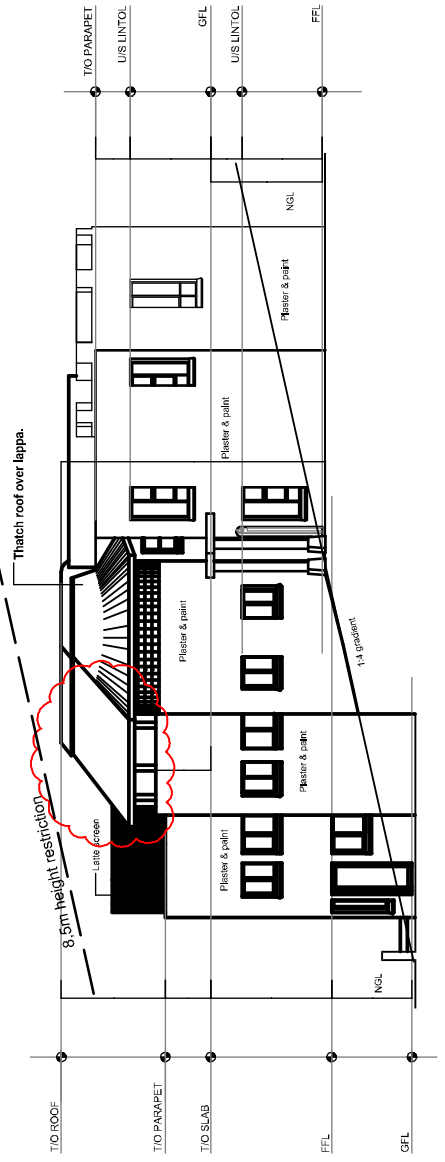

north elevation