


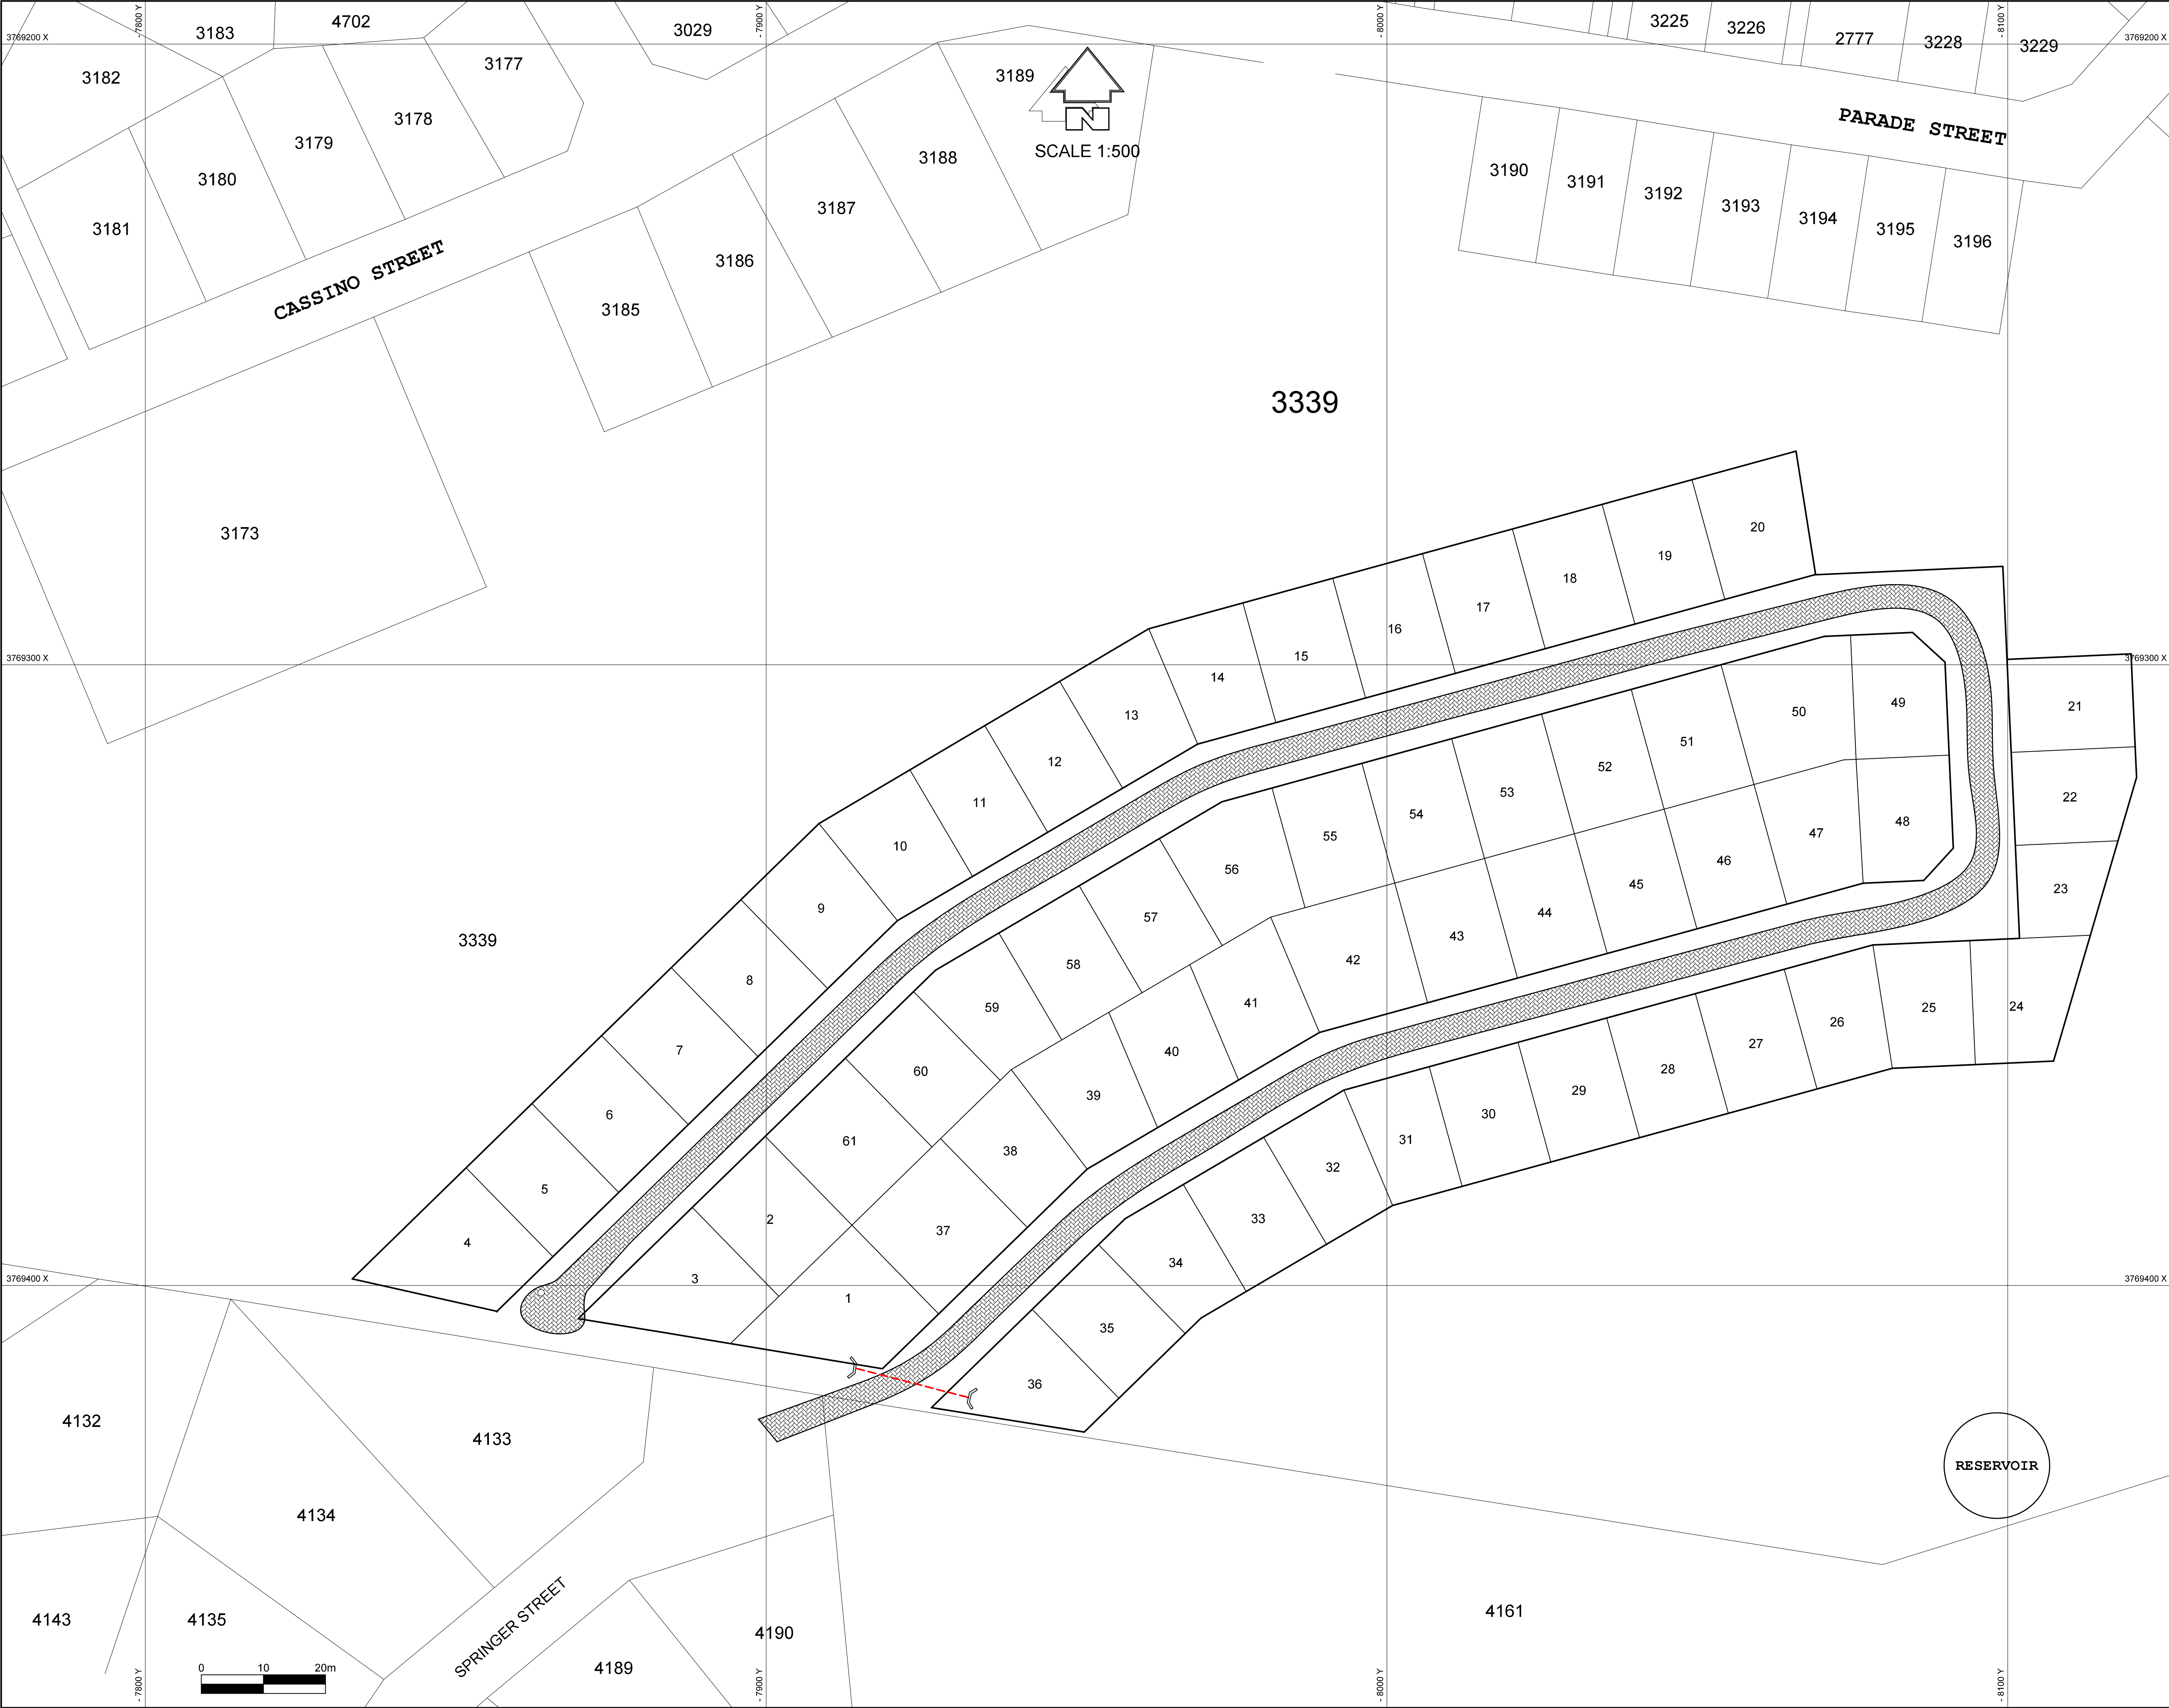

LEGEND:

- Paved Road (3.6m - 4.5m)
- 450mm Ø Concrete Pipe
- Concrete V-Drain Channel
- Catchpit
- Existing Stormwater pipe
- Direction of Flow
- Brick Headwall

NOTES:

1: Paved Access Road ties into the Municipal road in Springer Street.

0	Aug 2018	AS BUILT DRAWING	JDV
Rev.	Date	Description	Signed



SINTEC
CONSULTING ENGINEERS
innovative service delivery

26 High Street Knysna
Phone 044 382 7680
Fax 044 382 5396

P.O.Box 3694
Knysna
6570

Project :

**KAHP/CIVIL/01/2015/2016 -
AFFORDABLE HOUSING PROJECT
HORNLEE, KNYSNA**



Knysna
Municipality

Client :

KNYSNA MUNICIPALITY

Drawing Title :

**AS-BUILT
ROADS & STORMWATER
ERF 3339 - HORNLEE**

Engineer : JDV		Date :	
Designed : JDV		Checked : JDV	
Drawn: RM	Scale: 1 : 500	Paper Size: A1	

DWG. NUMBER.	REV.
207-3339-AB-ROADS-01	0