



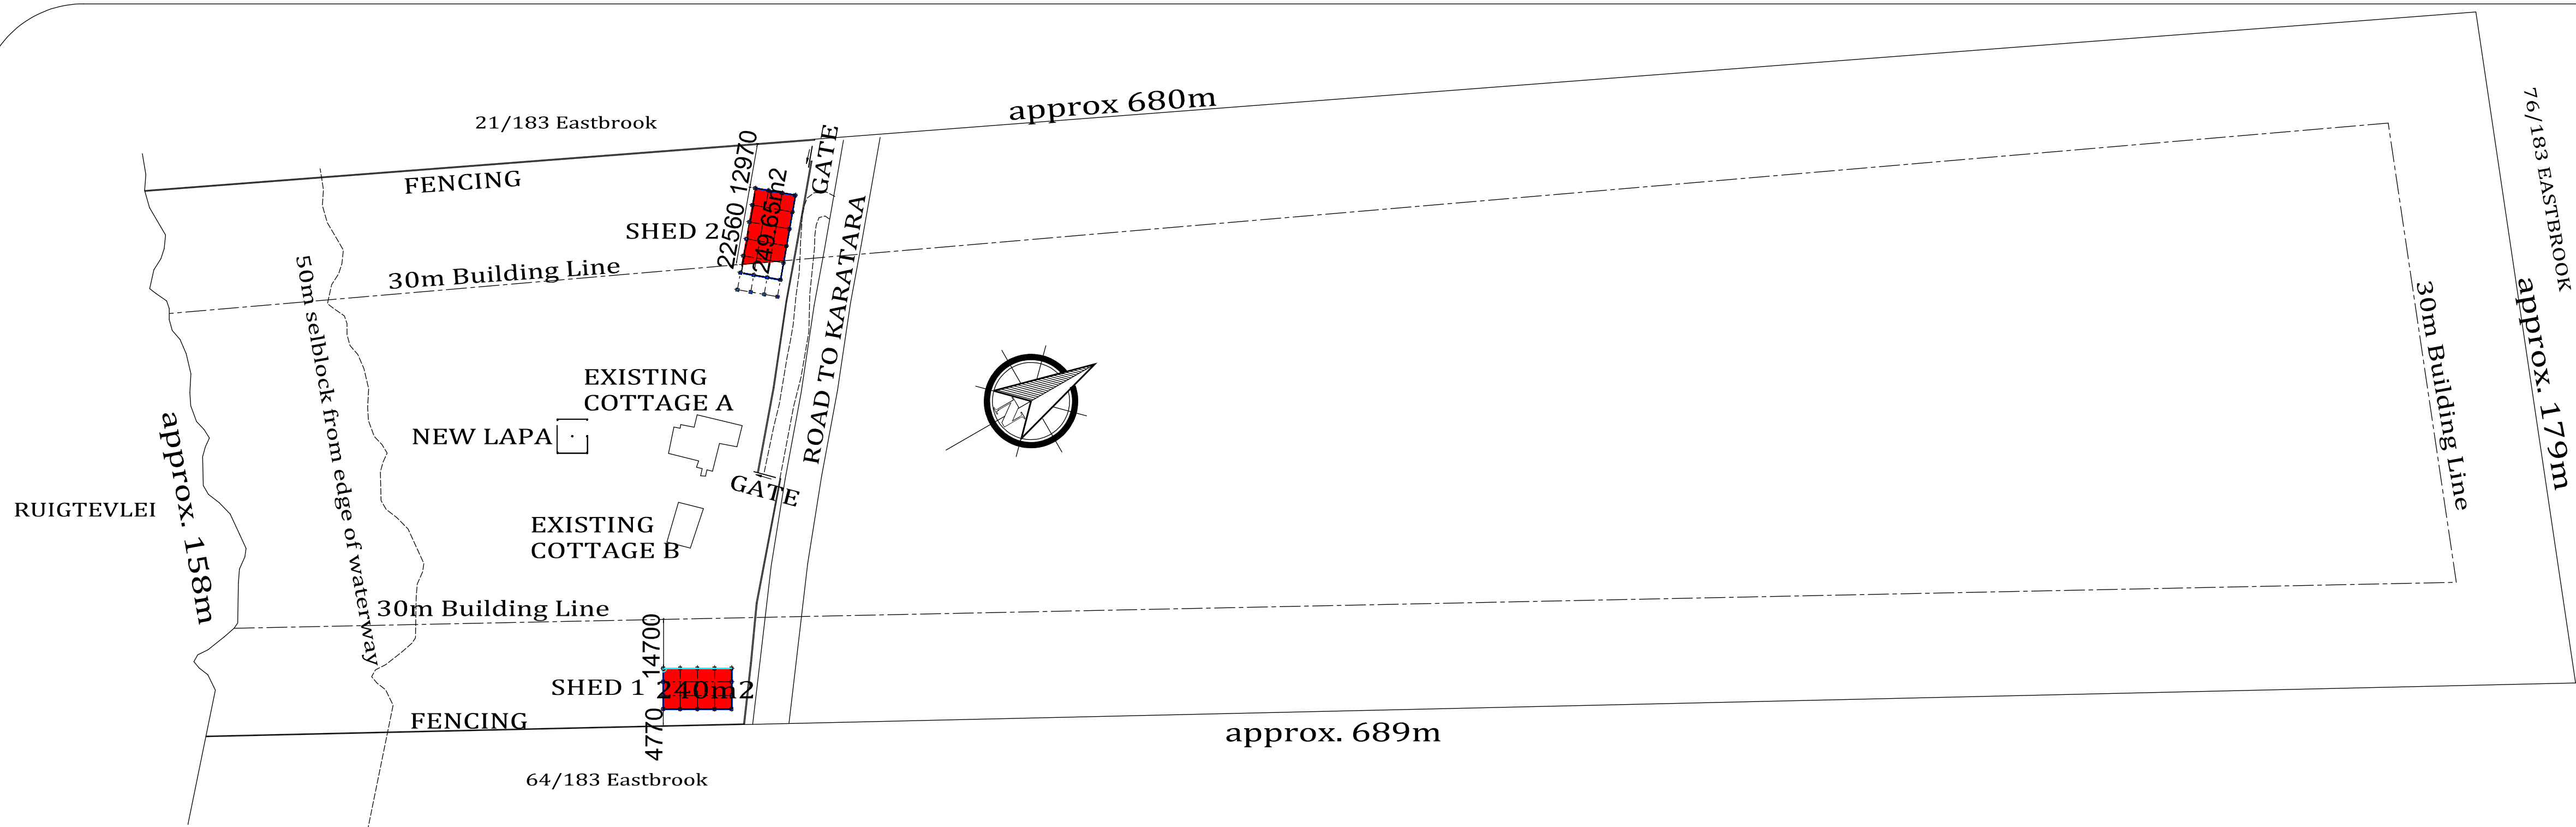

SITEPLAN

1:2000

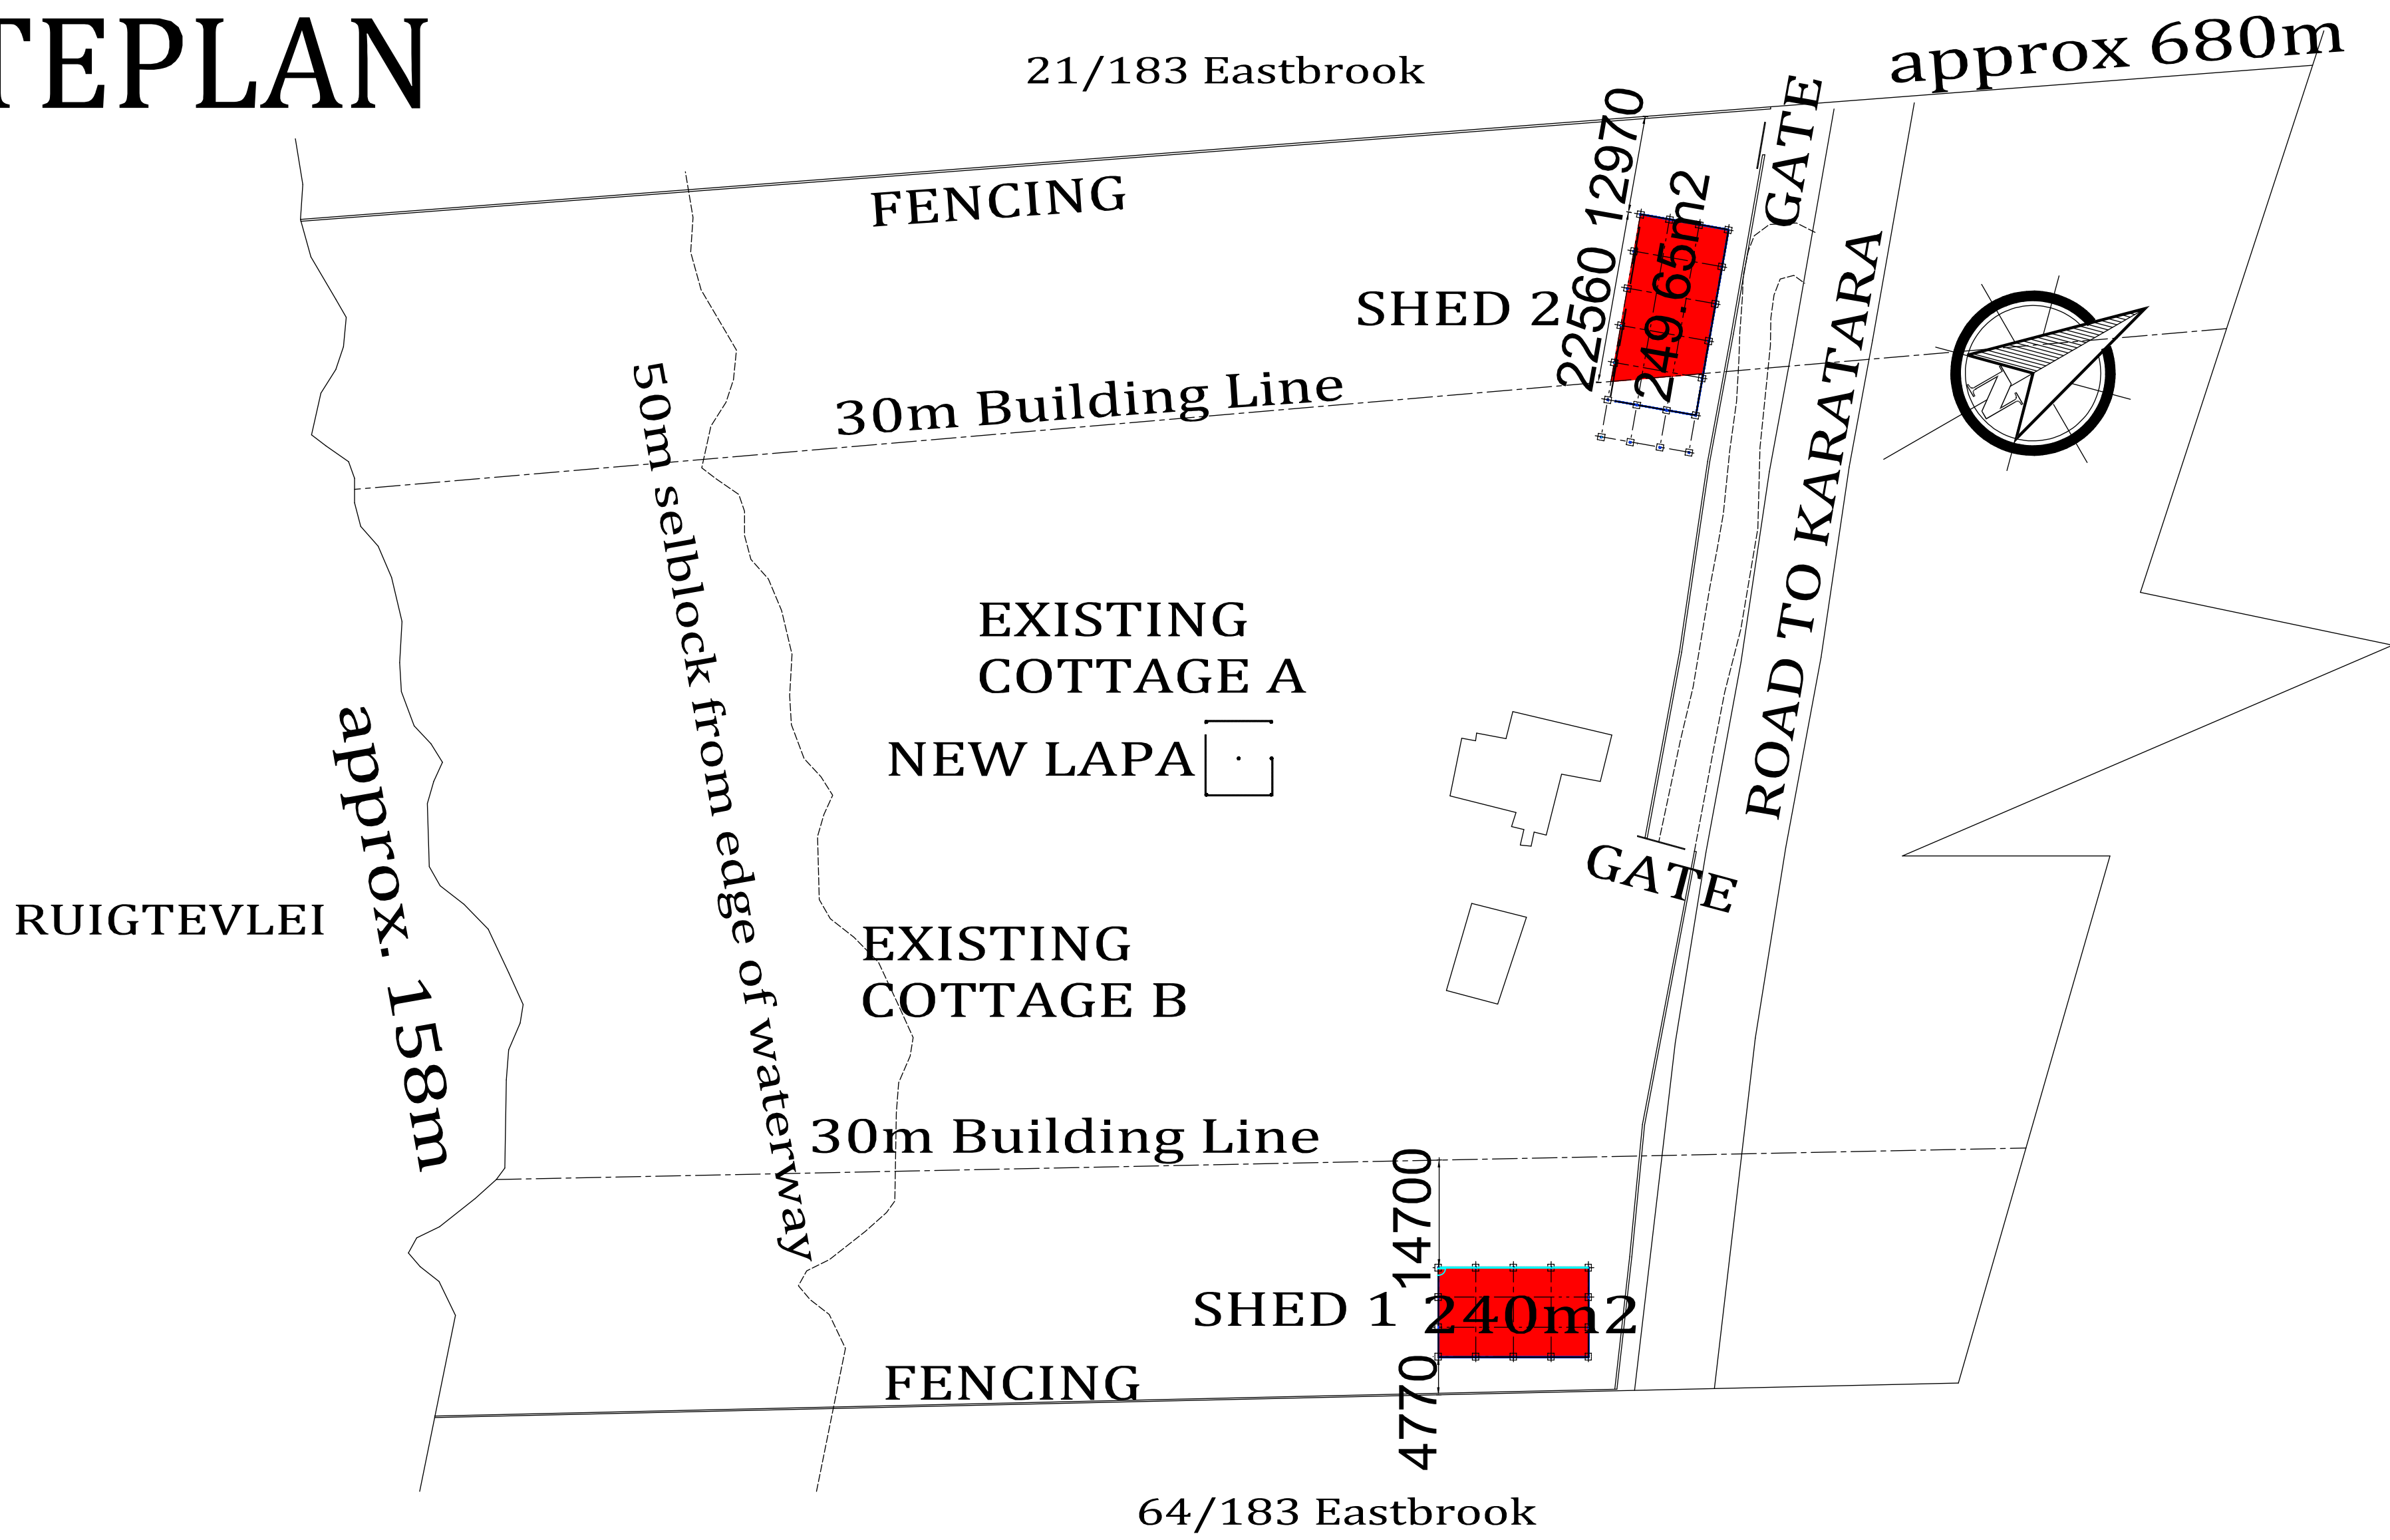

ENLARGED PORTION OF SITEPLAN

N.T.S

GENERAL NOTES

- Copyright reserved on all drawings
- Drawings may not be scaled
- All measurements and levels must be checked on site


AS-BUILT SHED 1	240m2
AS-BUILT SHED 2	360m2
NEW LAPA	90m2
Total:	690 m2
EXISTING COTTAGE A	157m2
EXISTING COTTAGE B	76m2
FOOTPRINT	923m2
ERF AREA	127150 m2
COVERAGE	0.72%

No	WYSIGINGS	DATUM
----	-----------	-------

Professional Architect Designer
PO BOX 241
Mosselbay
6500
Cell: 079 150 8455
email:
nickydeswardt38@gmail.com

FIRMA :

UNIPLANS

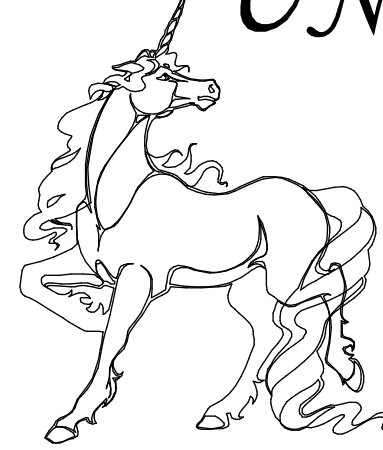

D0276

PROJEK :

AS-BUILT SHED &
NEW LAPA
UNIT 2 SEAHAVEN CC
22/183 FARM EASTBROOK
KNYSNA

OWNER/POA
SIGNATURE
N de Swardt

Drawn by Nicky de Swardt	Page 1
Date AUGUST 2024	Plan no: 22.15 +
Scale 1:100,50	