


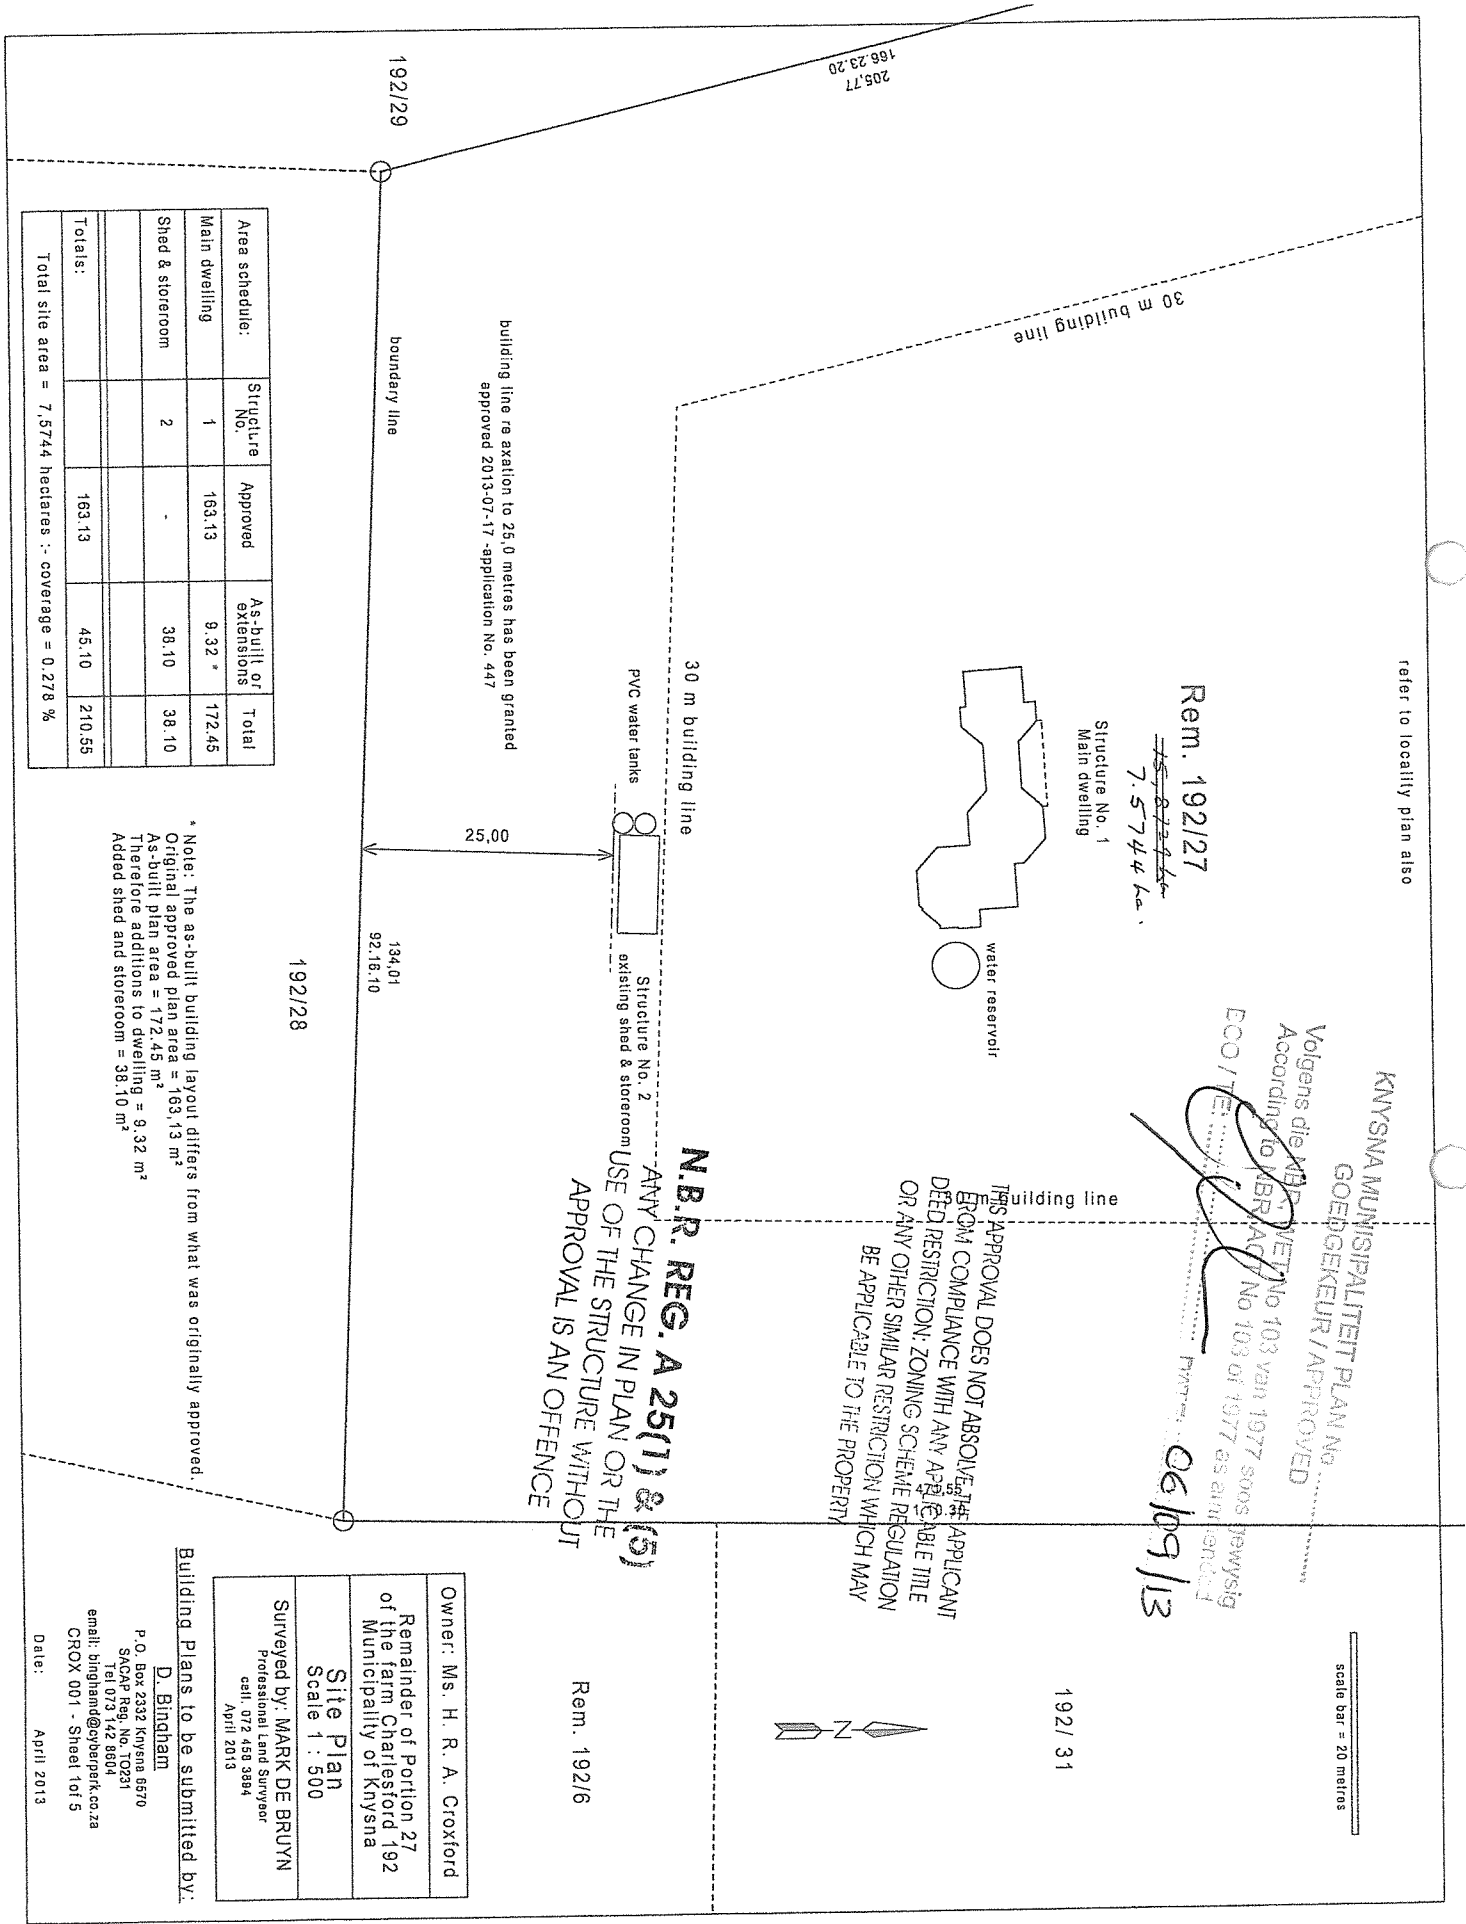


KNYSNA MUNISIPALITEIT PLAN NO.
GOEDGEKEUR / APPROVED

Volgens die NBR 1977 van 1977, is gawysig
According to NBR 1977 of 1977, is recommended
Dated: 06/09/13

THIS APPROVAL DOES NOT ABSOLVE THE APPLICANT
FROM COMPLIANCE WITH ANY APPLICABLE TITLE
DEED RESTRICTION, ZONING SCHEME REGULATION
OR ANY OTHER SIMILAR RESTRICTION WHICH MAY
BE APPLICABLE TO THE PROPERTY.

N.B.R. REG. A 25(1) & (5)

ANY CHANGE IN PLAN OR THE
USE OF THE STRUCTURE WITHOUT
APPROVAL IS AN OFFENCE

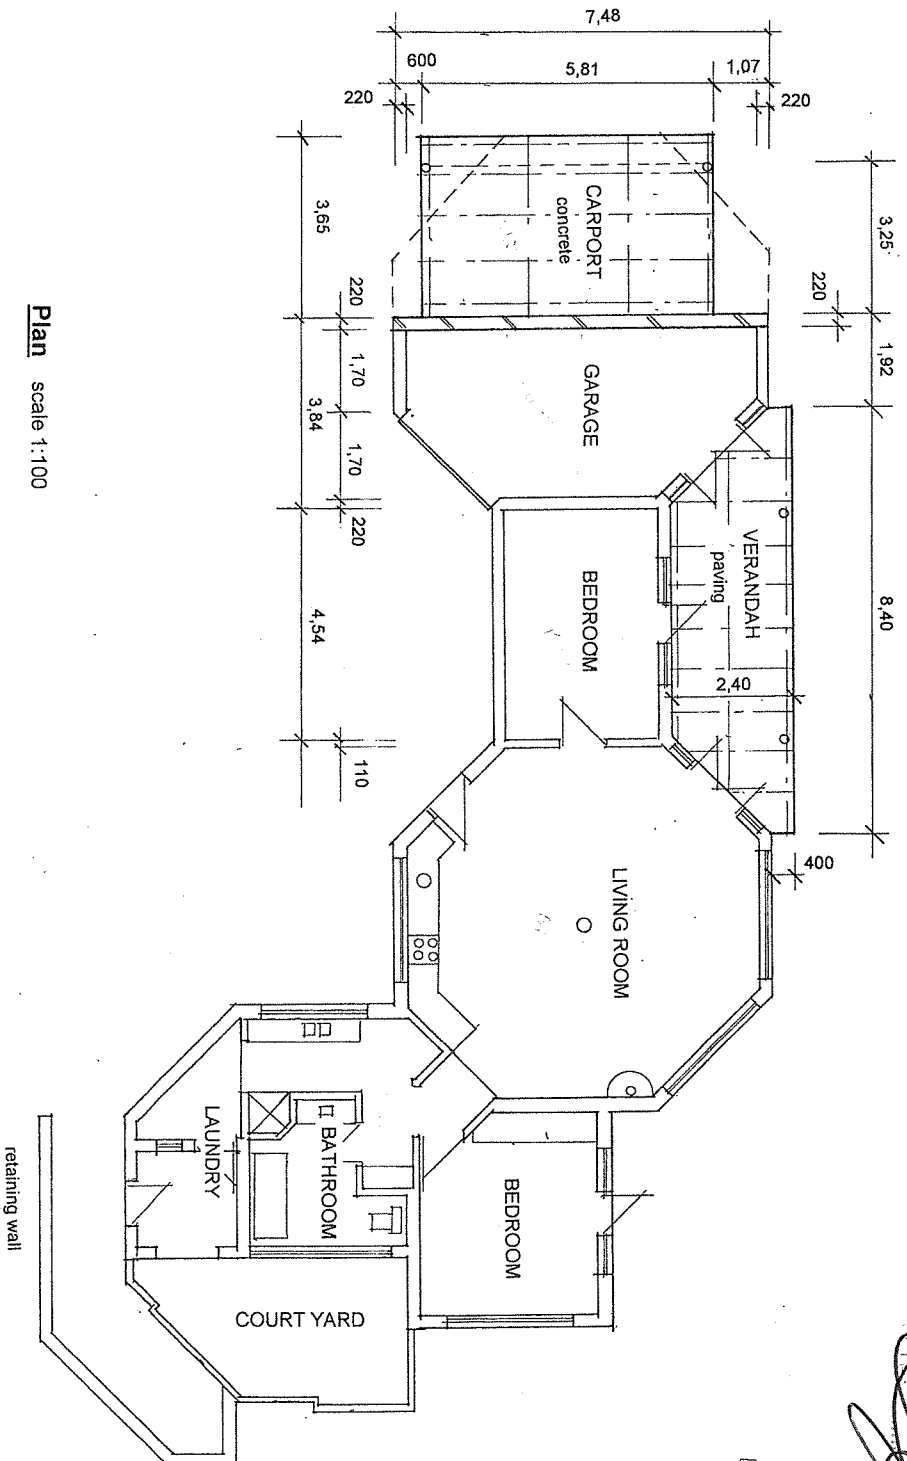

Plan scale 1:100

**AMNESTY AGRICULTURAL LAND
AS BUILT STRUCTURES**

ON PORTION 27 OF THE FARM 192 CHARLESFORD KNYSNA

FOR MRS. H. CROXFORD


Plan drawn by D. Bingham PO Box 2332 Knysna SACAP reg. TO 231
Plan No. C001 dt: 30/04/2013 Sheet 2 of 5 sheets
Tel: 073 1428 604 e-mail: binghamd@cypertek.co.za

KNYSNA MUNISIPALITEIT PLAN NO
GOEDGEKEUR / APPROVED

Volgers die N.B. Wet No 103 van 1977 soos gewysig
Aanvullende toelating No 103 of 1977 as aangepas
ECCOITE


DATE

06/09/15

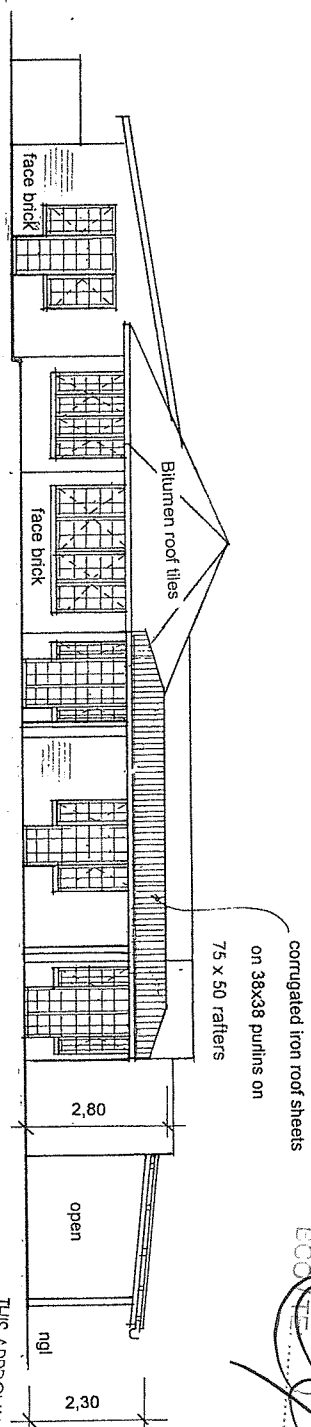

North Elevation scale 1:100

THIS APPROVAL DOES NOT ABSOLVE THE APPLICANT
FROM COMPLIANCE WITH ANY APPLICABLE TITLE
DEED RESTRICTION: ZONING SCHEME REGULATION
OR ANY OTHER SIMILAR RESTRICTION WHICH MAY
BE APPLICABLE TO THE PROPERTY.

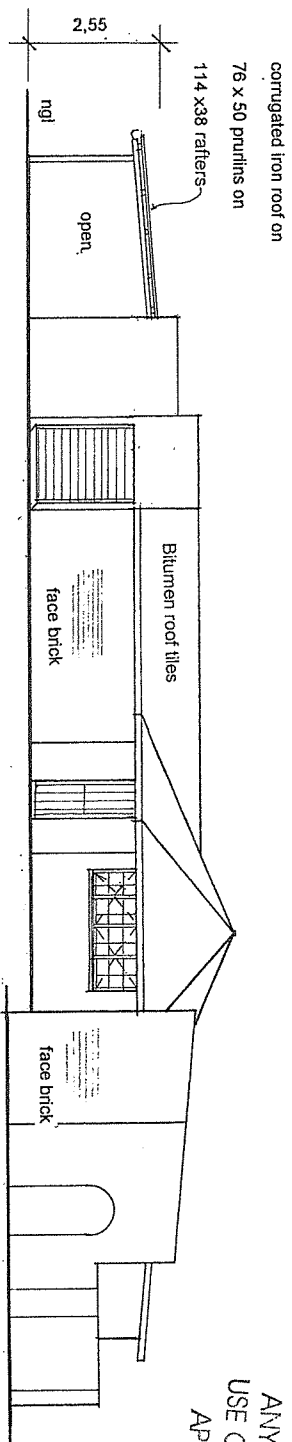

South Elevation scale 1:100

N.B.R. REG. A 25(1) & (5)
ANY CHANGE IN PLAN OR THE
USE OF THE STRUCTURE WITHOUT
APPROVAL IS AN OFFENCE

AMNESTY AGRICULTURAL LAND
AS BUILT STRUCTURES


ON PORTION 27 OF THE FARM 192 CHARLESFORD KNYNSNA

FOR MRS. H. CROXFORD

Plan drawn by D. Bingham PO Box 2332 Knysna SACAP reg. TO 231
Plan No. C001 dt: 30/04/2013 Sheet 3 of 5 sheets
Tel: 073 1428 604 e-mail: binghamd@cyberpetk.co.za


KNYSNA MUNICIPALITEIT PLAN No
GOEDGEKUR / APPROVED

Volgens die NBR, WTA No. 103 van 1977 soos gewysig
Accordie No. 103 of 1977 as amended

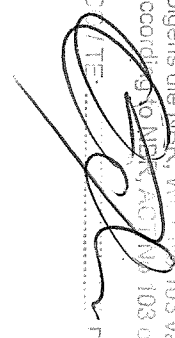
DOOR:  DATE: 26/09/13

THIS APPROVAL DOES NOT ASSOLVE THE APPLICANT
FROM COMPLIANCE WITH ANY APPLICABLE TITLE
DEED RESTRICTION, ZONING SCHEME REGULATION
OR ANY OTHER SIMILAR RESTRICTION WHICH MAY
BE APPLICABLE TO THE PROPERTY.

N.B.R. REG. A 25(1) & (5)
ANY CHANGE IN PLAN OR THE
USE OF THE STRUCTURE WITHOUT
APPROVAL IS AN OFFENCE

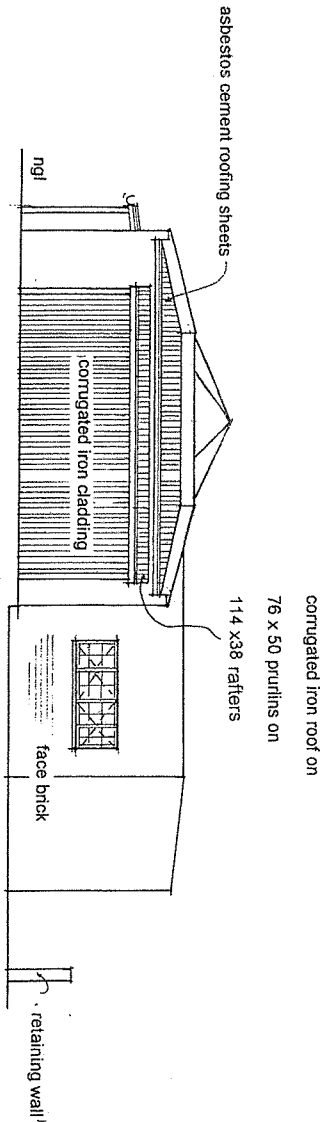

West Elevation scale 1:100

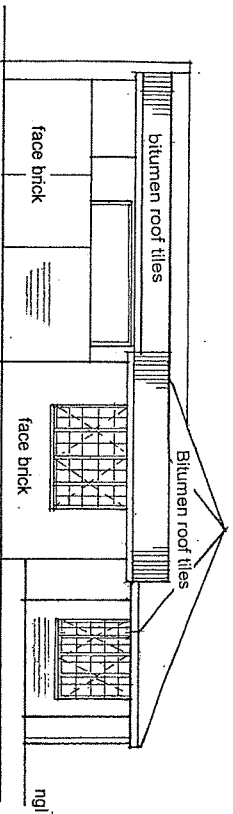

East Elevation scale 1:100

AMNESTY AGRICULTURAL LAND

AS BUILT STRUCTURES


ON PORTION 27 OF THE FARM 192 CHARLESFORD KNYNSA

FOR MRS. H. CROXFORD


Plan drawn by D. Bingham PO Box 2332 Kynsna SACAP reg. TO 231

Plan No. C001 dt: 30/04/2013 Sheet 4 of 5 sheets


Tel: 073 1428 604 e-mail: binghamd@cyberperk.co.za

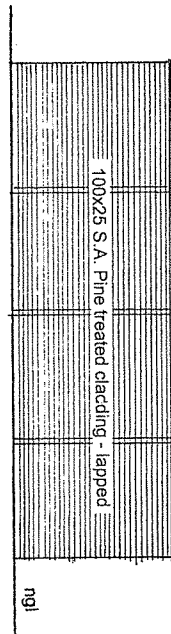


North Elevation scale 1:100

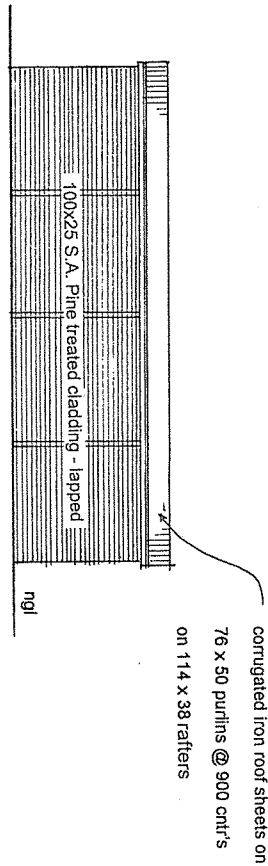


South Elevation scale 1:100

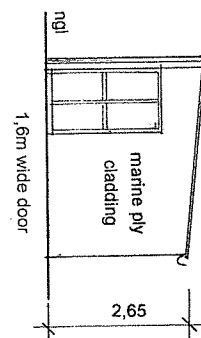

West Elevation scale 1:100

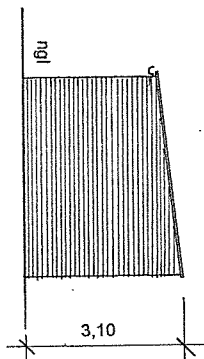

East Elevation scale 1:100

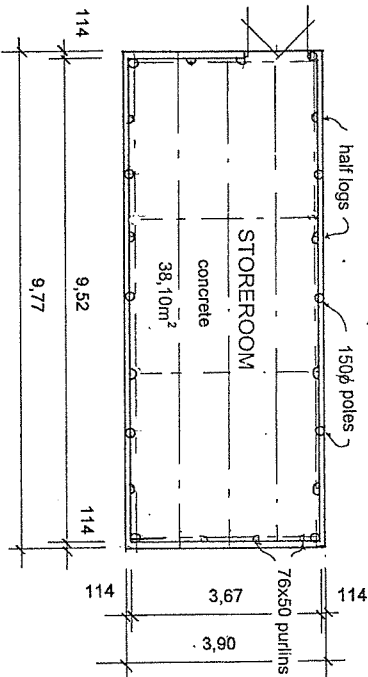

Plan scale 1:100

KNYSNA MUNISIPALITEIT PLAN NO. 192
GOEDGEKEUR / APPROVED
Volgens die N.B.R. Wet No. 25 van 1977 soos gewysig
According to N.B.R. Act No. 25 of 1977 as amended
ECO / N. 192 / 1977
DATE: 06/04/13

THIS APPROVAL DOES NOT ABSOLVE THE APPLICANT
FROM COMPLIANCE WITH ANY APPLICABLE TITLE
DEED RESTRICTION, ZONING SCHEME REGULATION
OR ANY OTHER SIMILAR RESTRICTION WHICH MAY
BE APPLICABLE TO THE PROPERTY.

N.B.R. REG. A 25(1) & (5)
ANY CHANGE IN PLAN OR THE
USE OF THE STRUCTURE WITHOUT
APPROVAL IS AN OFFENCE

AMNESTY AGRICULTURAL LAND

AS BUILT STRUCTURES

ON PORTION 27 OF THE FARM 192 CHARLESTOWN KNYSNA

FOR MRS. H. CROXFORD

Plan drawn by D. Bingham PO Box 2332 Knysna SACAP reg. TO 231

Plan No. C001 dt: 30/04/2013 Sheet 5 of 5 sheets

Tel: 073 1428 604 e-mail: binghamd@cyberperk.co.za