

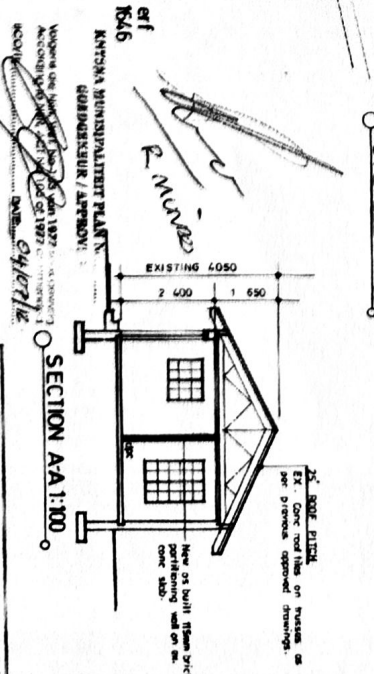
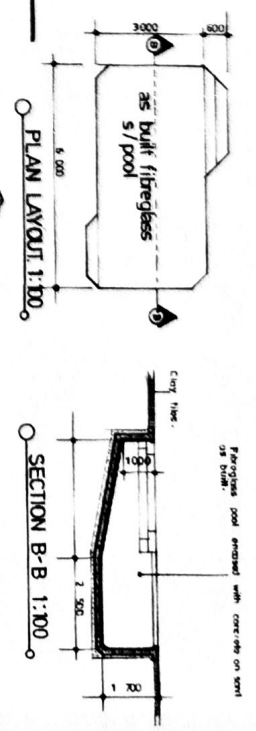
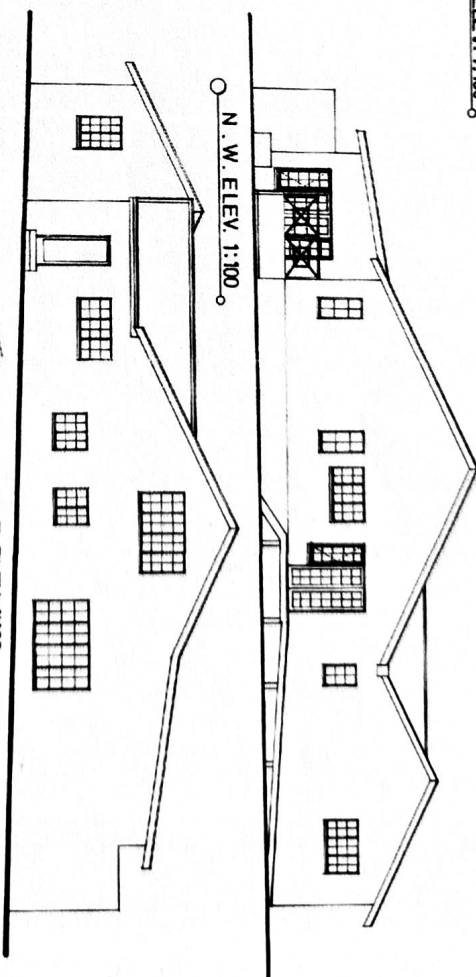
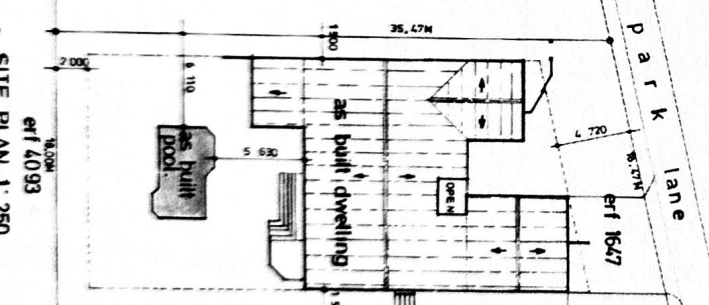
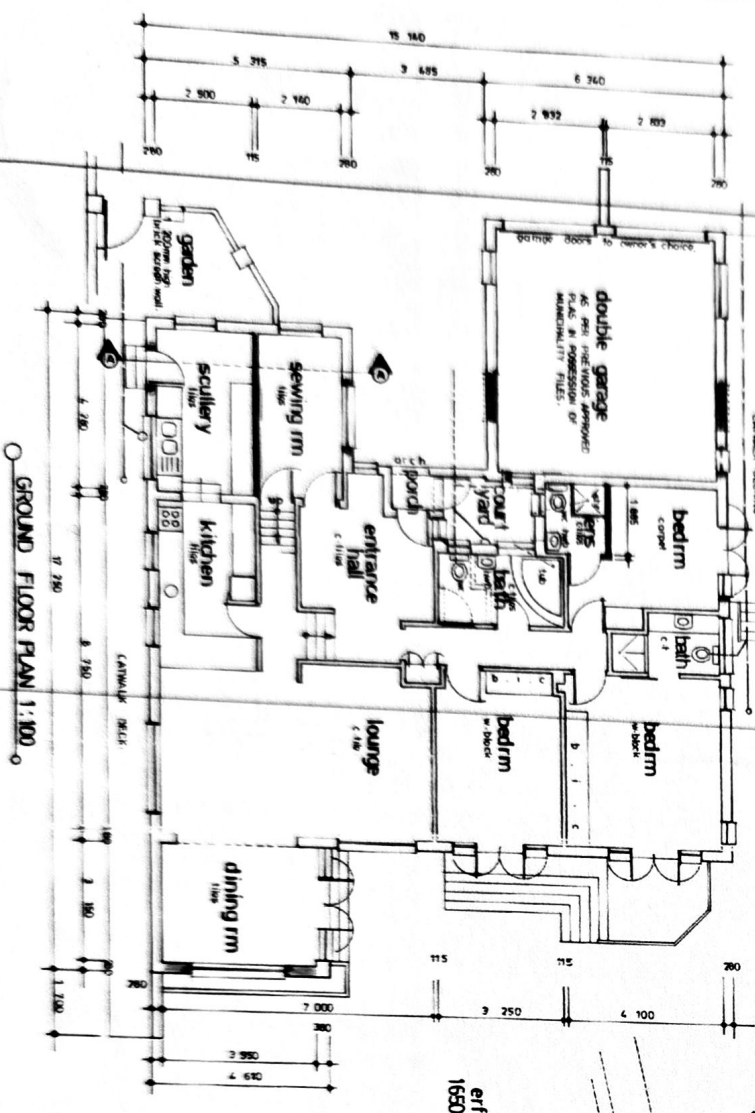
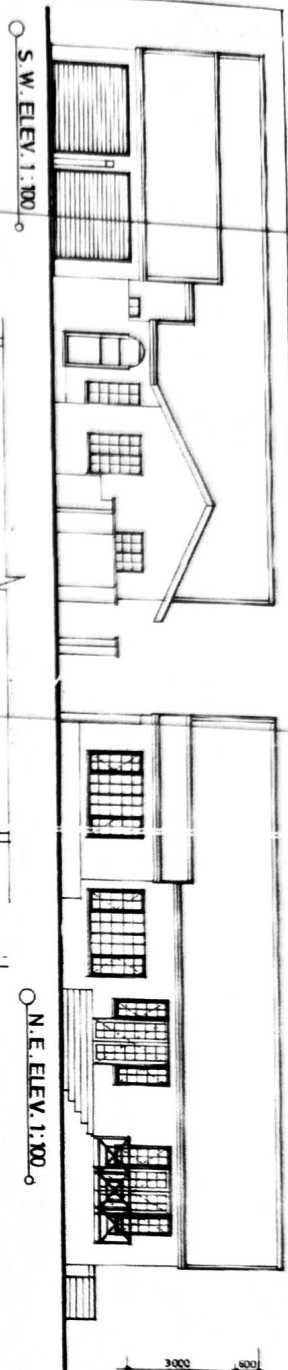
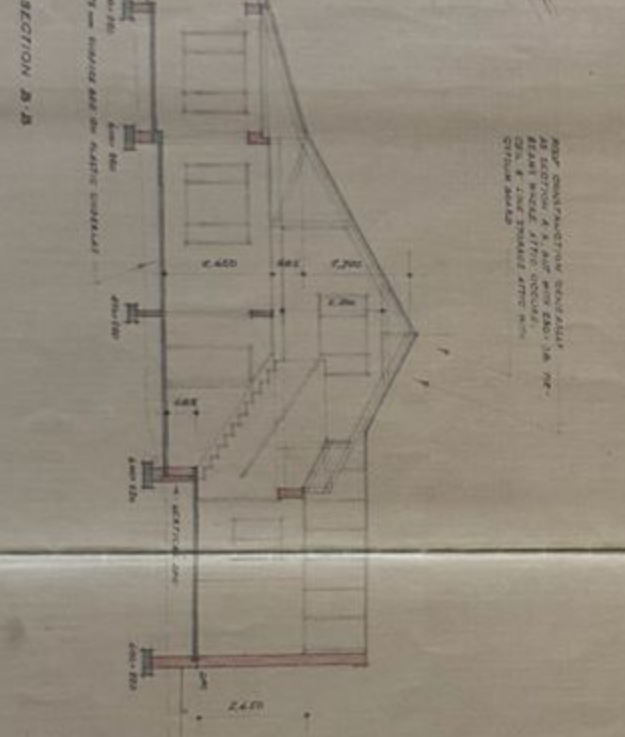
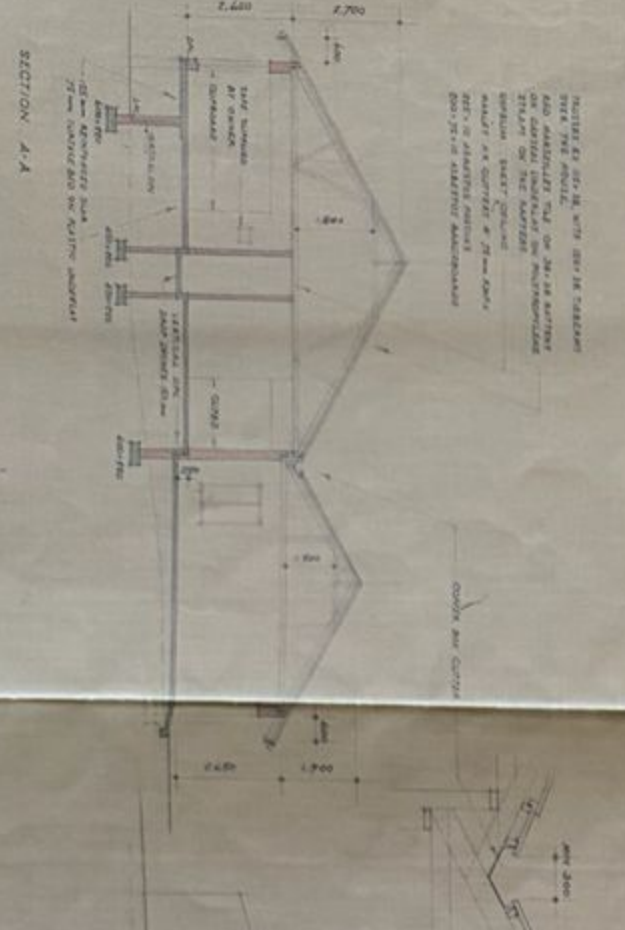
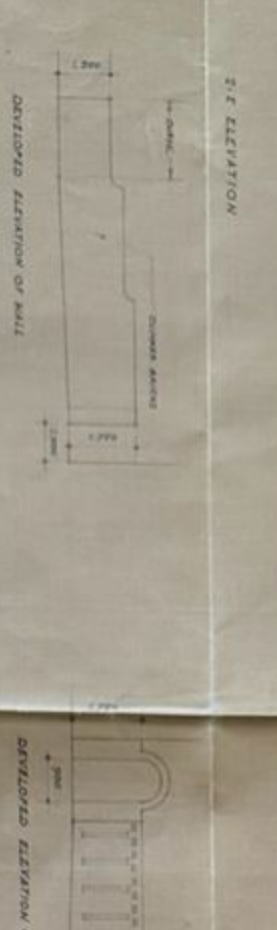
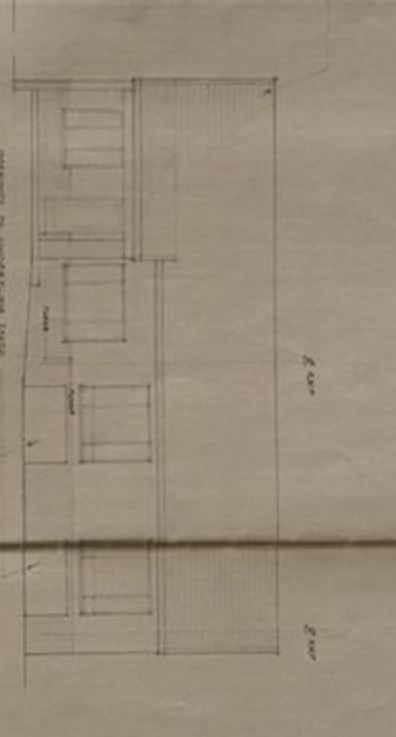
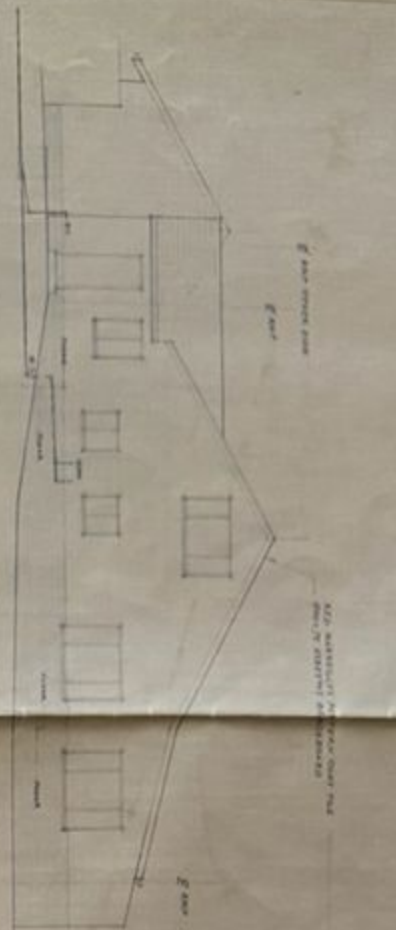


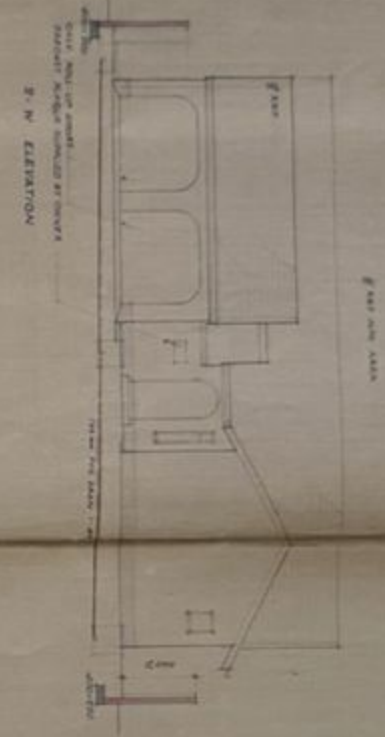

BUILDING DWELLING NO. 416 A 1 20. 0000 m AREA POOL 1 18. 0000 m AREA 1 6.35. 0000 m FINISH 1 33. 90. 5		N.A.C. REG. A 294 ANY CHANGE IN PLAN, 1 USE OF THE STRUCTURE AND 2 MATERIAL IS AN OFFSE
THE APPLICANT MUST ASSURE THE APPLICANT FROM COMPLAINTS WITH ANY APPLICANT THE OFFICIAL, THE APPLICANT SHALL BE HELD ON ANY OTHERS SHALL BE HELD HELD BE APPLICANT TO THE PROPERTY.		

ARCH-IMAGES ARTS STUDIO 07 SACAP REG NO. 7069		P.O. BOX 1068 KNYNSA 8570 Email: arch-images@gnn.com
ISSUES CHARTER THE ONLY SHOOTER!		CELL: 071 341 9641 FAX: 086 884 0034 Email: arch-images@gnn.com

AS BUILT ALTERATIONS TO EXISTING DWELLING AND POOL ON EFF. N 1667 LEISURE ISLE KNYNSA FOR J. A. VAN VELEN		dm cd 200 ki NO. 416 AUTHORIZED 14/05/2012 46 SHOWN 1st 1st 1st 1st 1 0
--	--	--

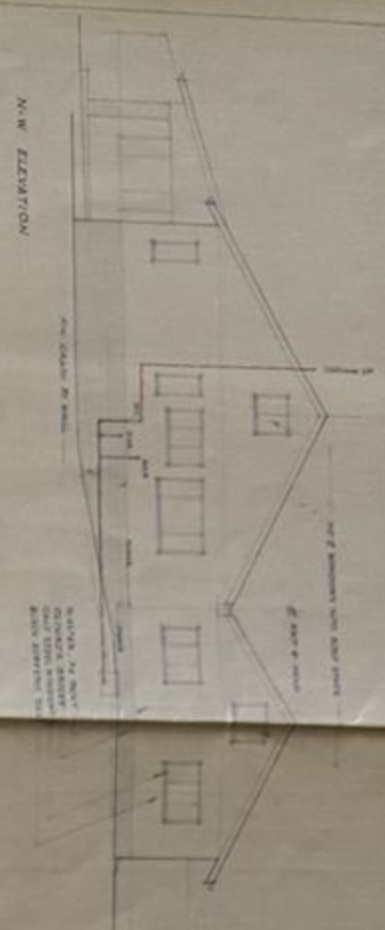

ENTRANCE
REPAIRS
TO BE MADE
BY THE
OWNER
AT HIS
OWN RISK
AND
EXPENSE
DATE: 10/1/77
BY: [Signature]

M. & M. P. MOORE
1547 KINGS
NEW YORK

PLAN, SECTIONS, ELEVATIONS
SITE PLAN

SCALE:
1" = 10'-0"
1" = 20'-0"
1" = 40'-0"
1" = 80'-0"
1" = 160'-0"

2406-1