
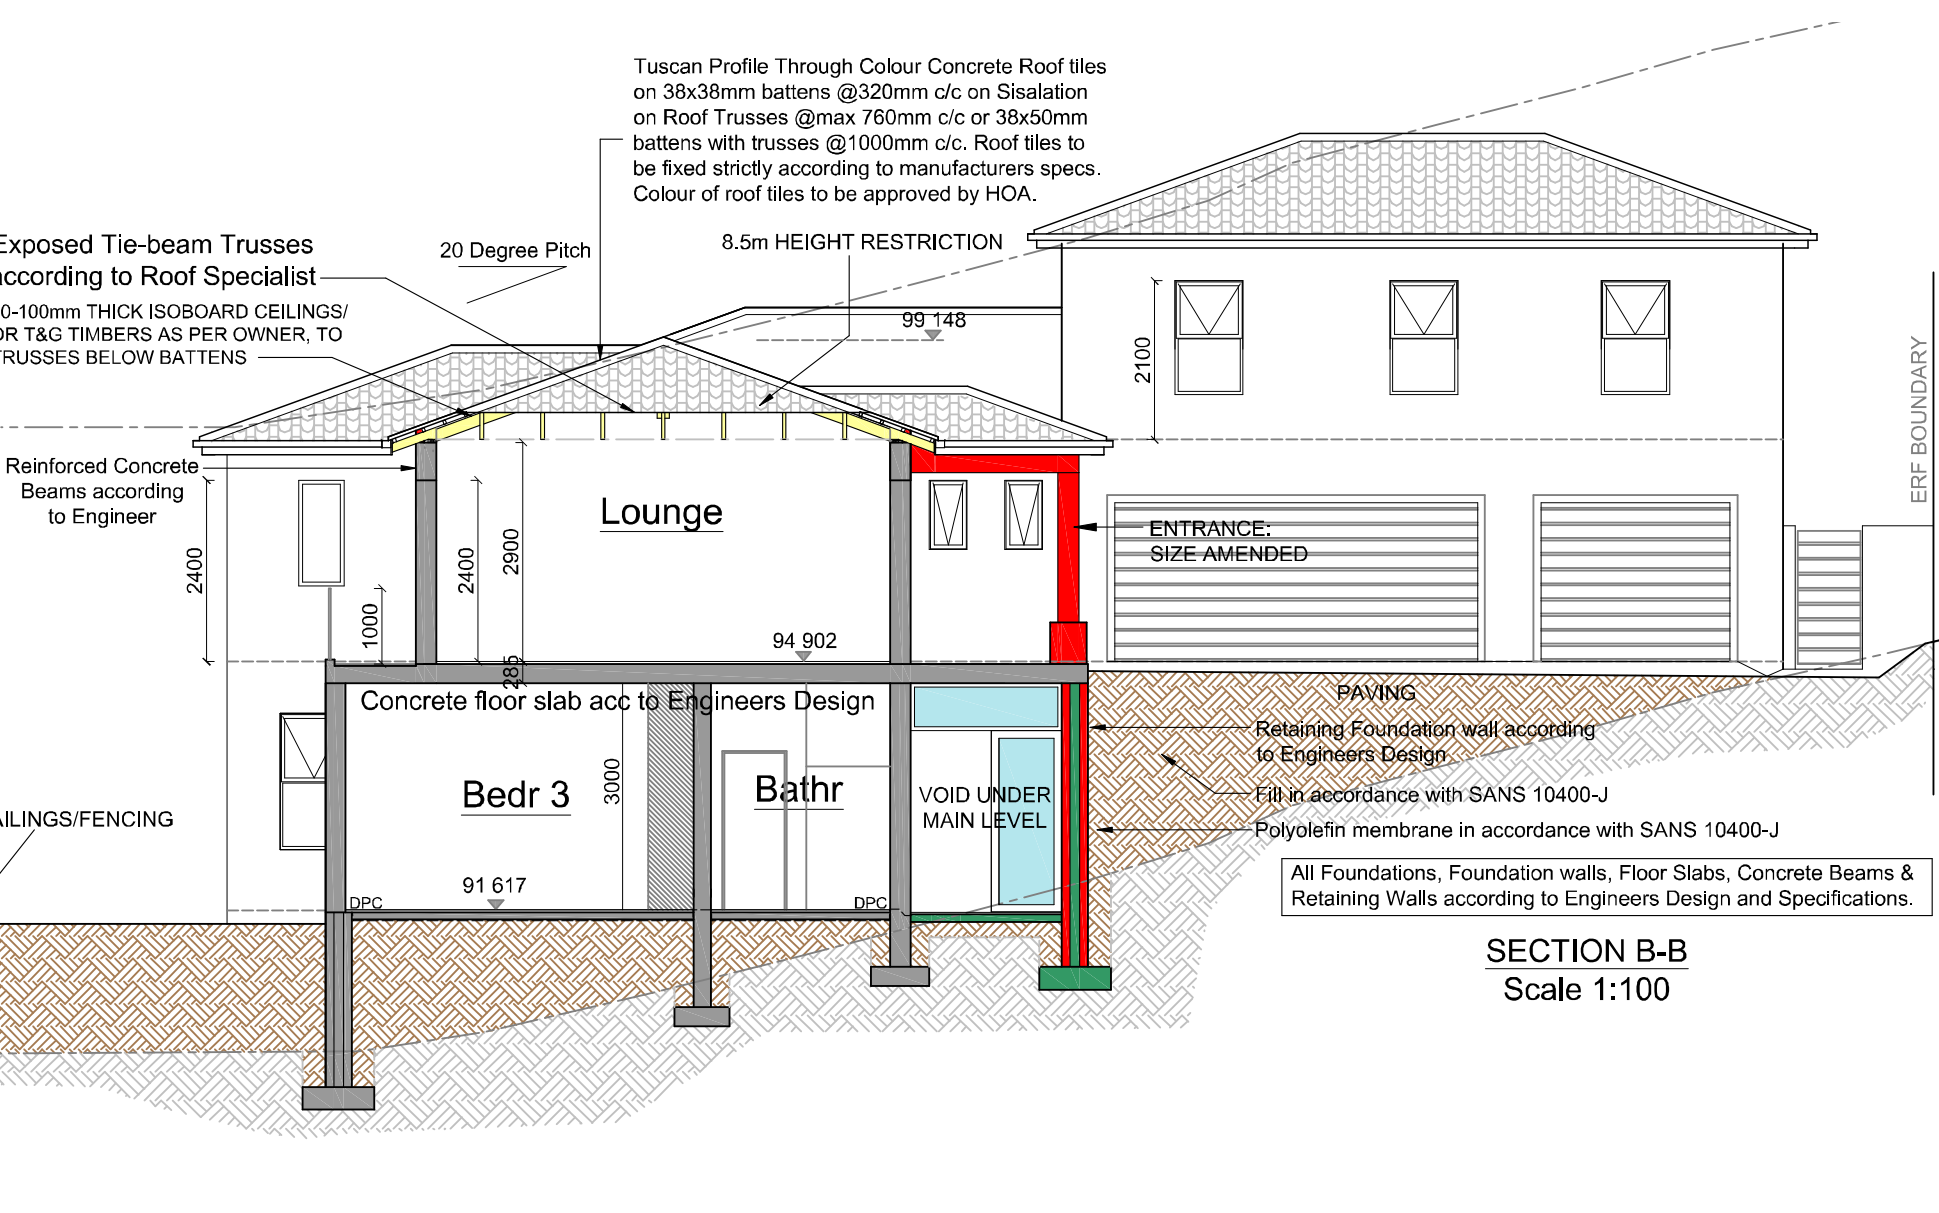
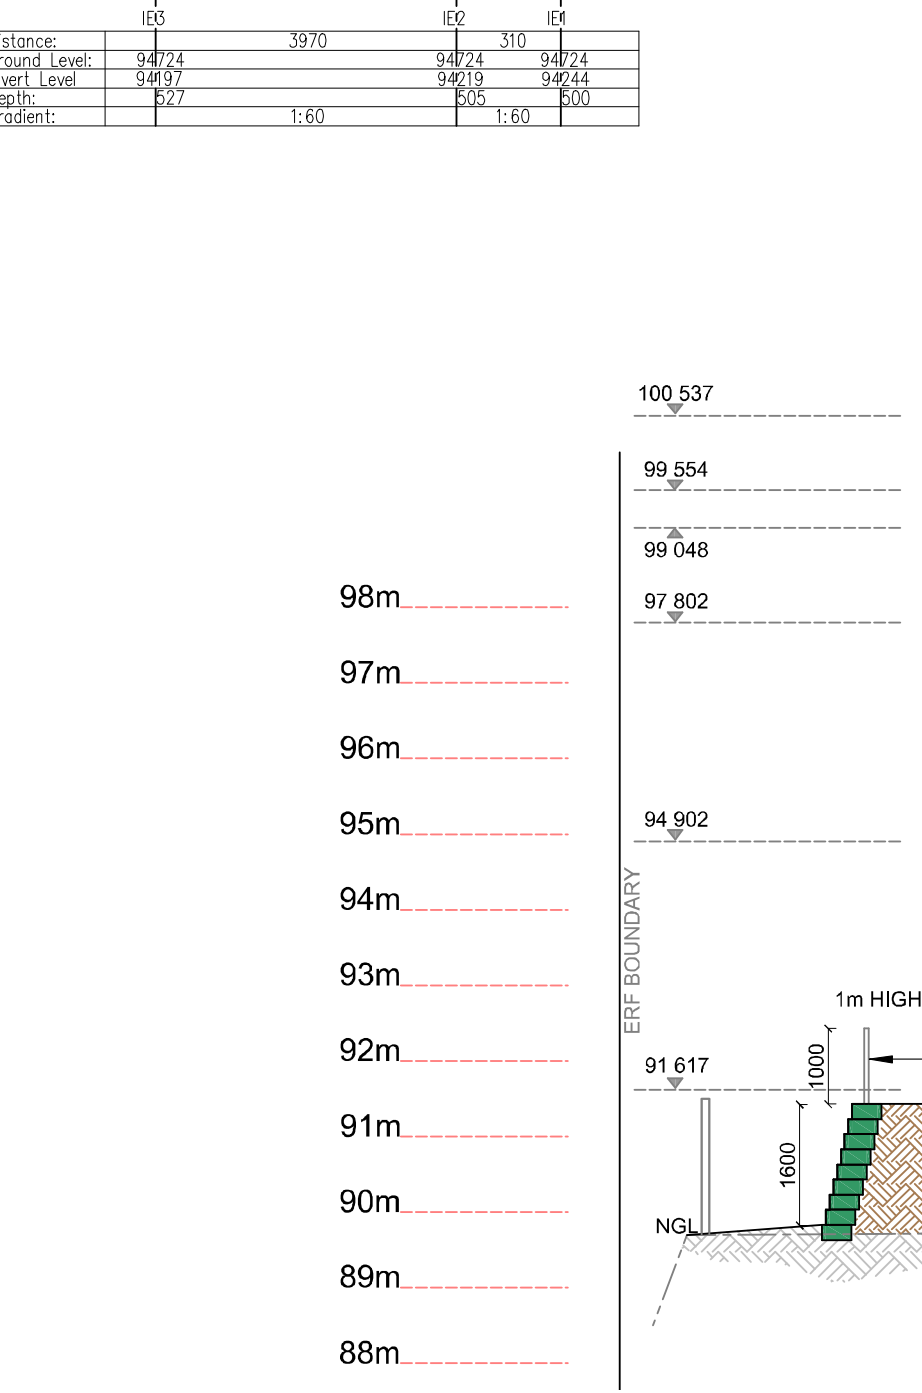
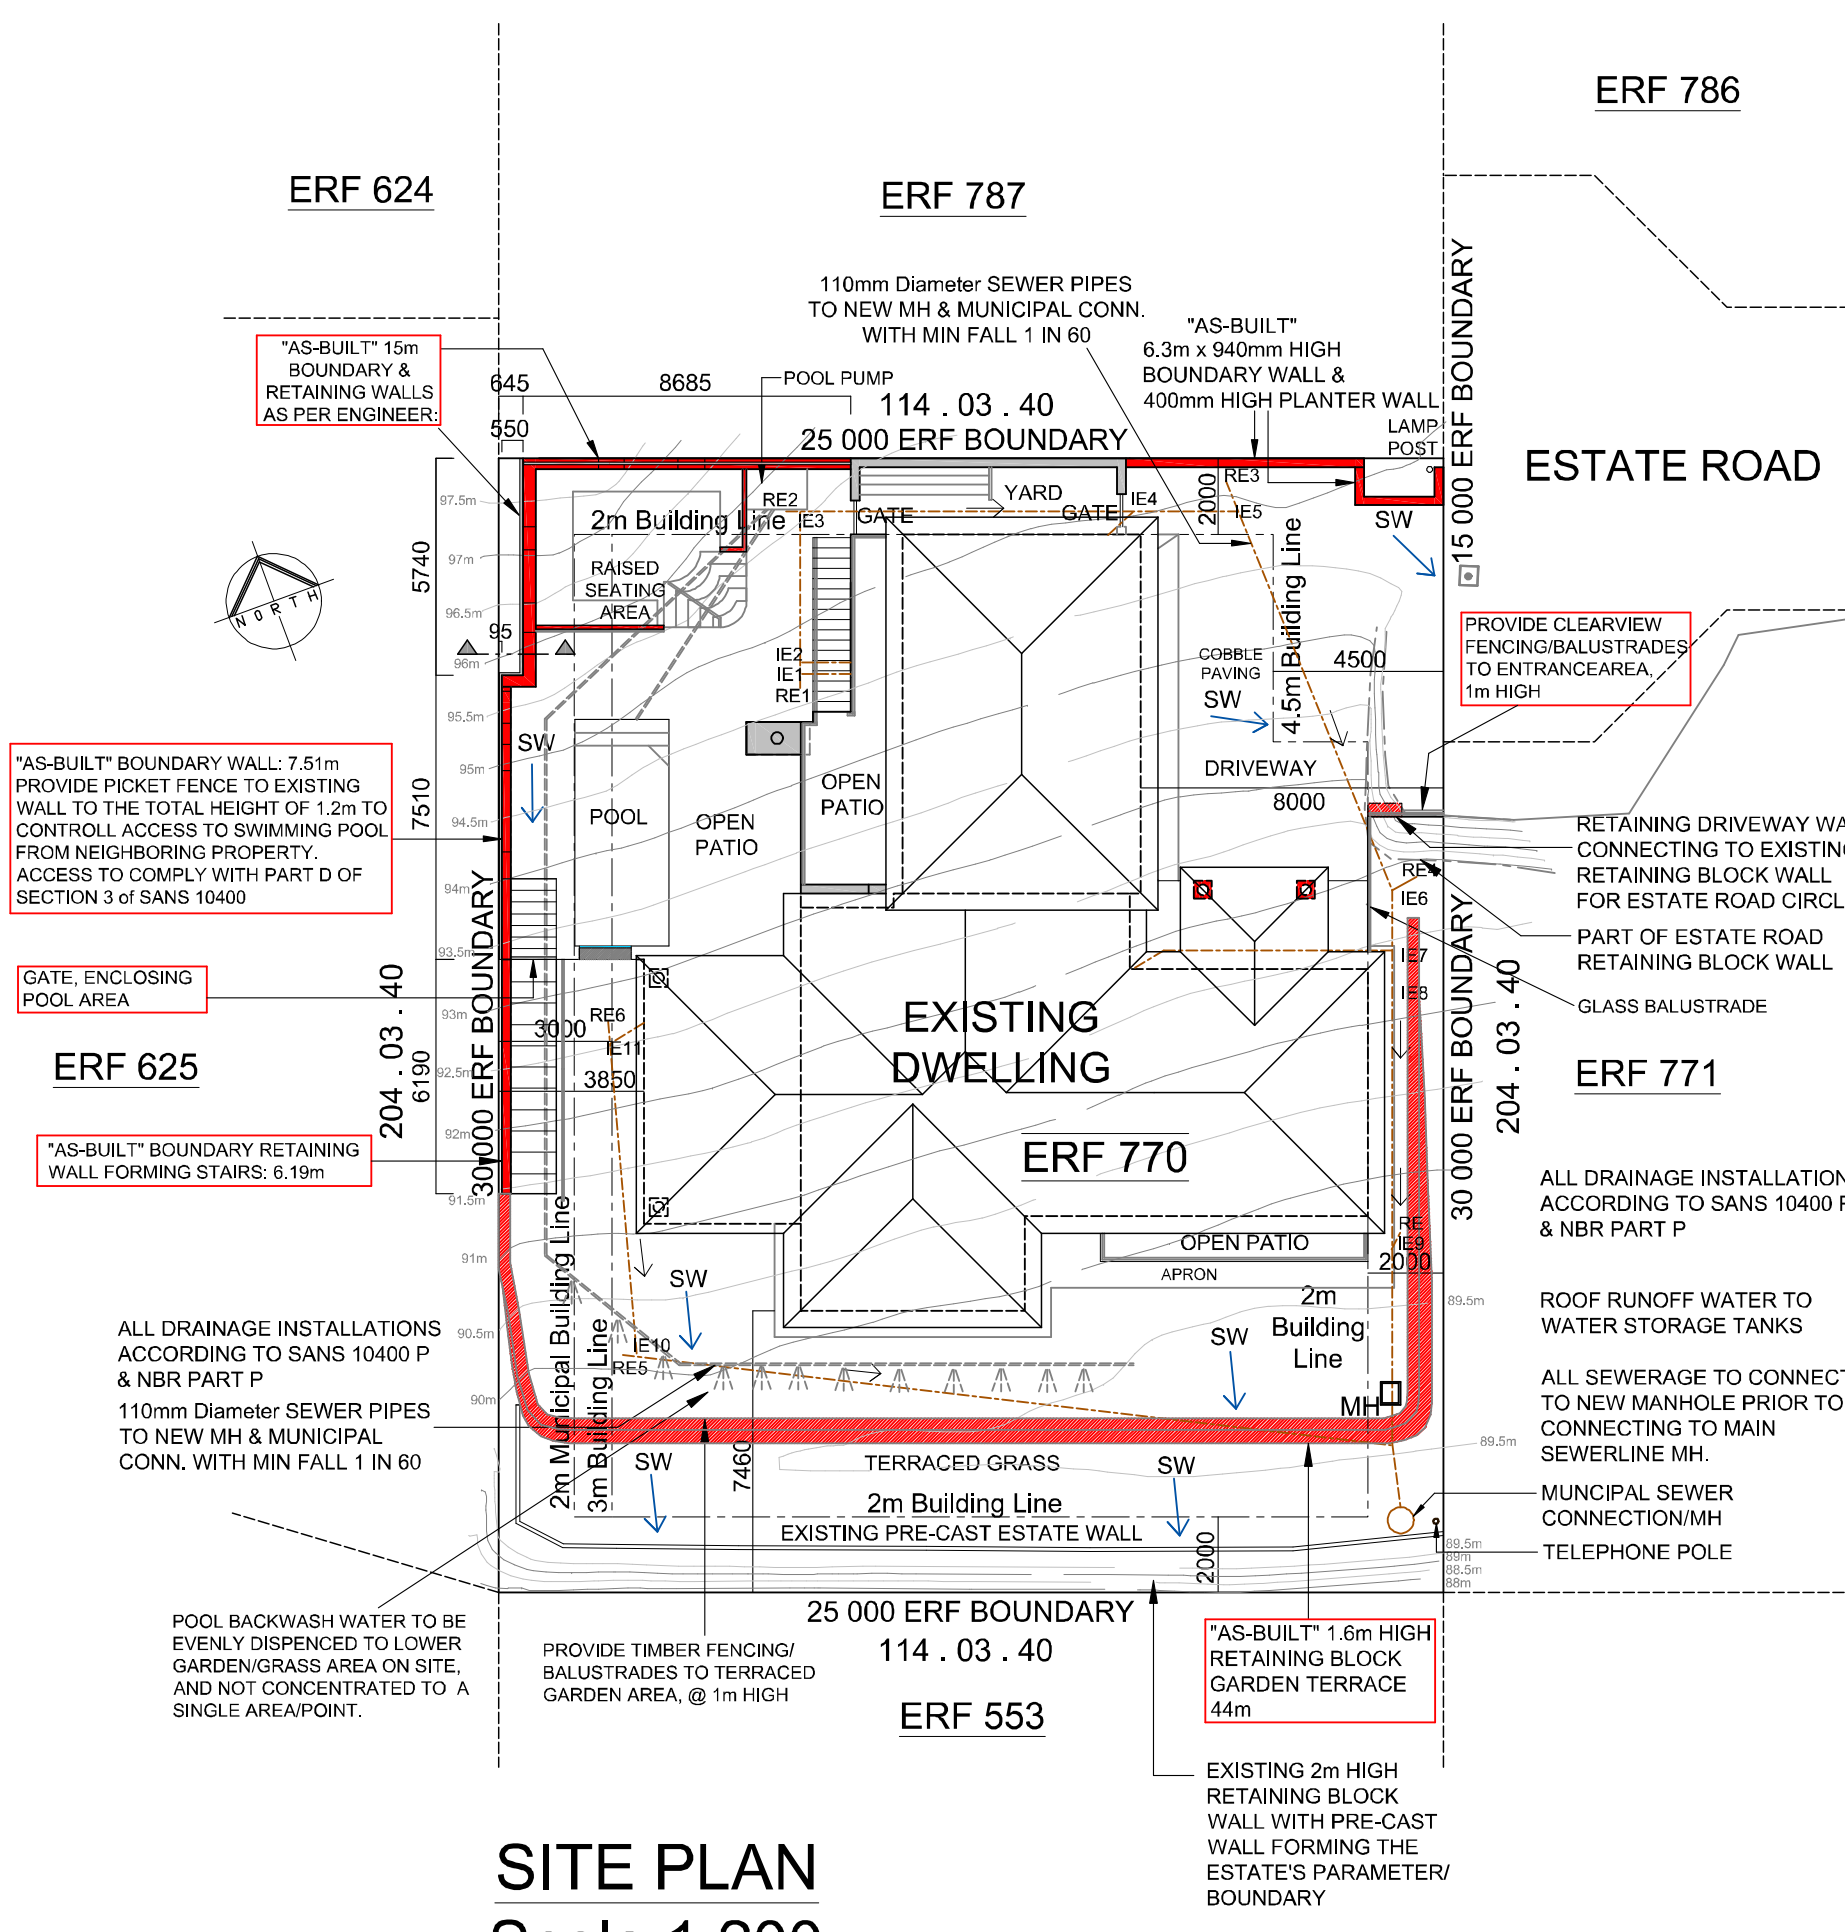
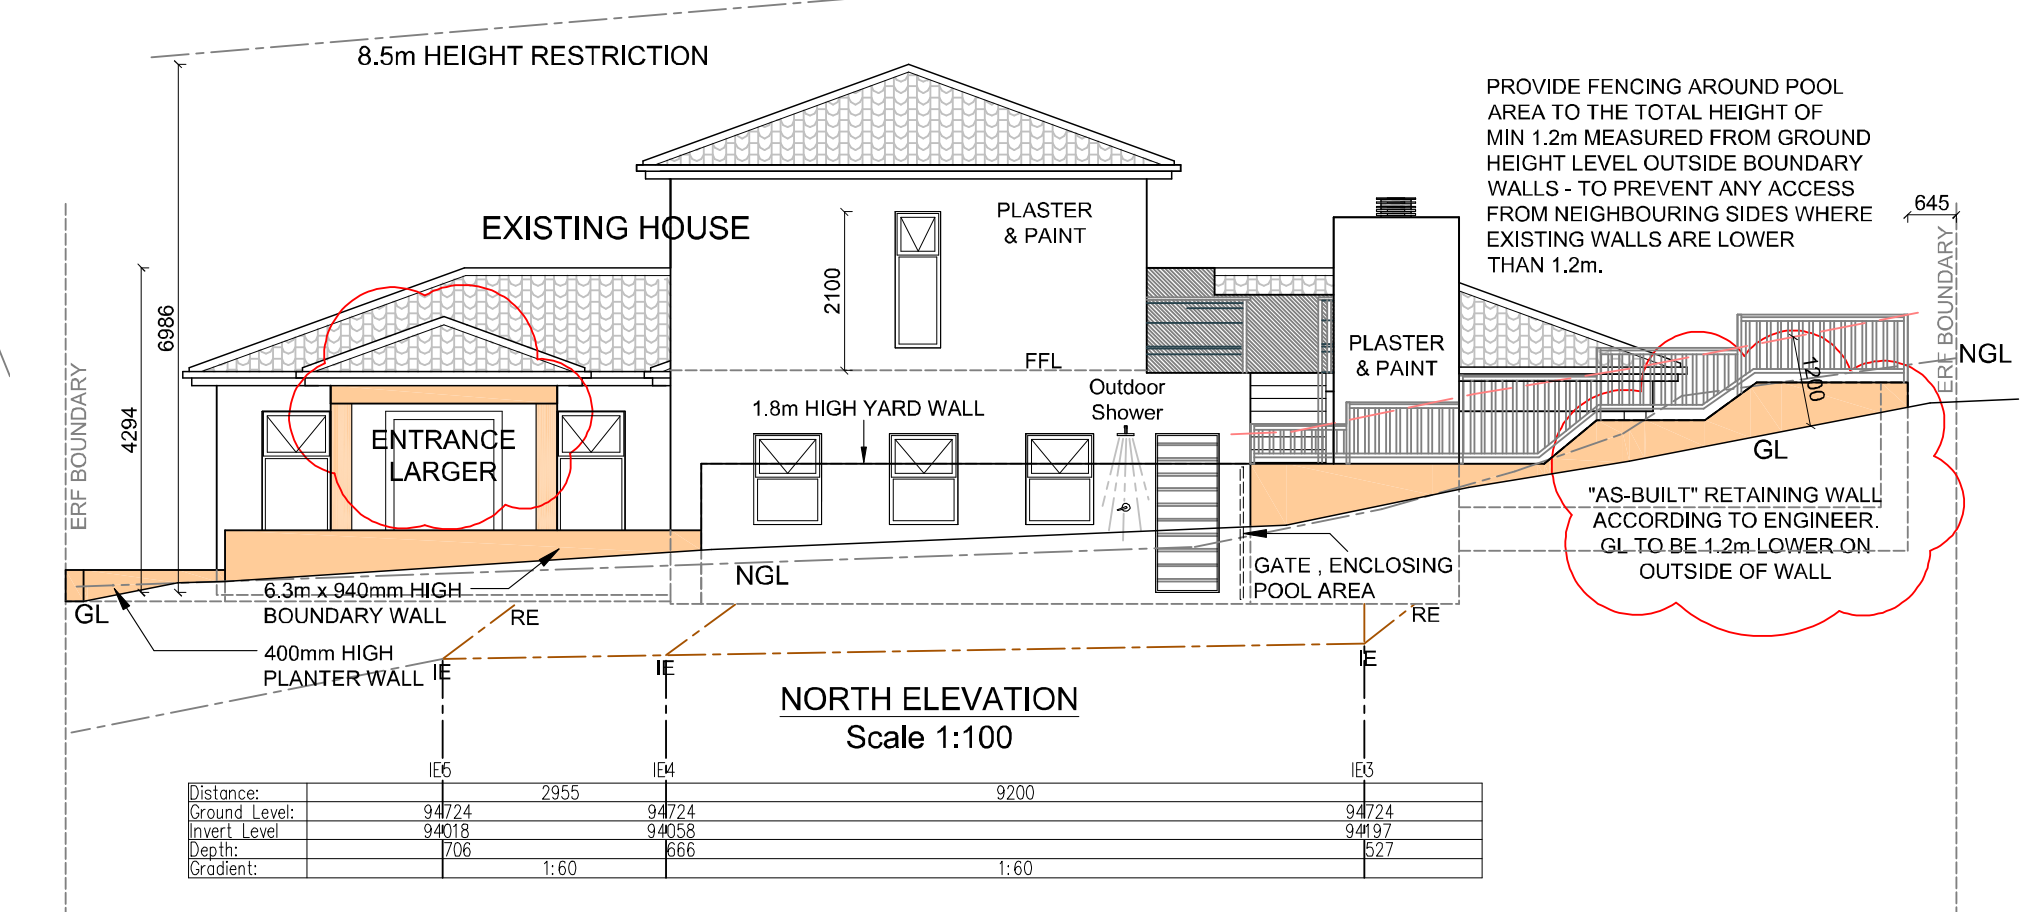
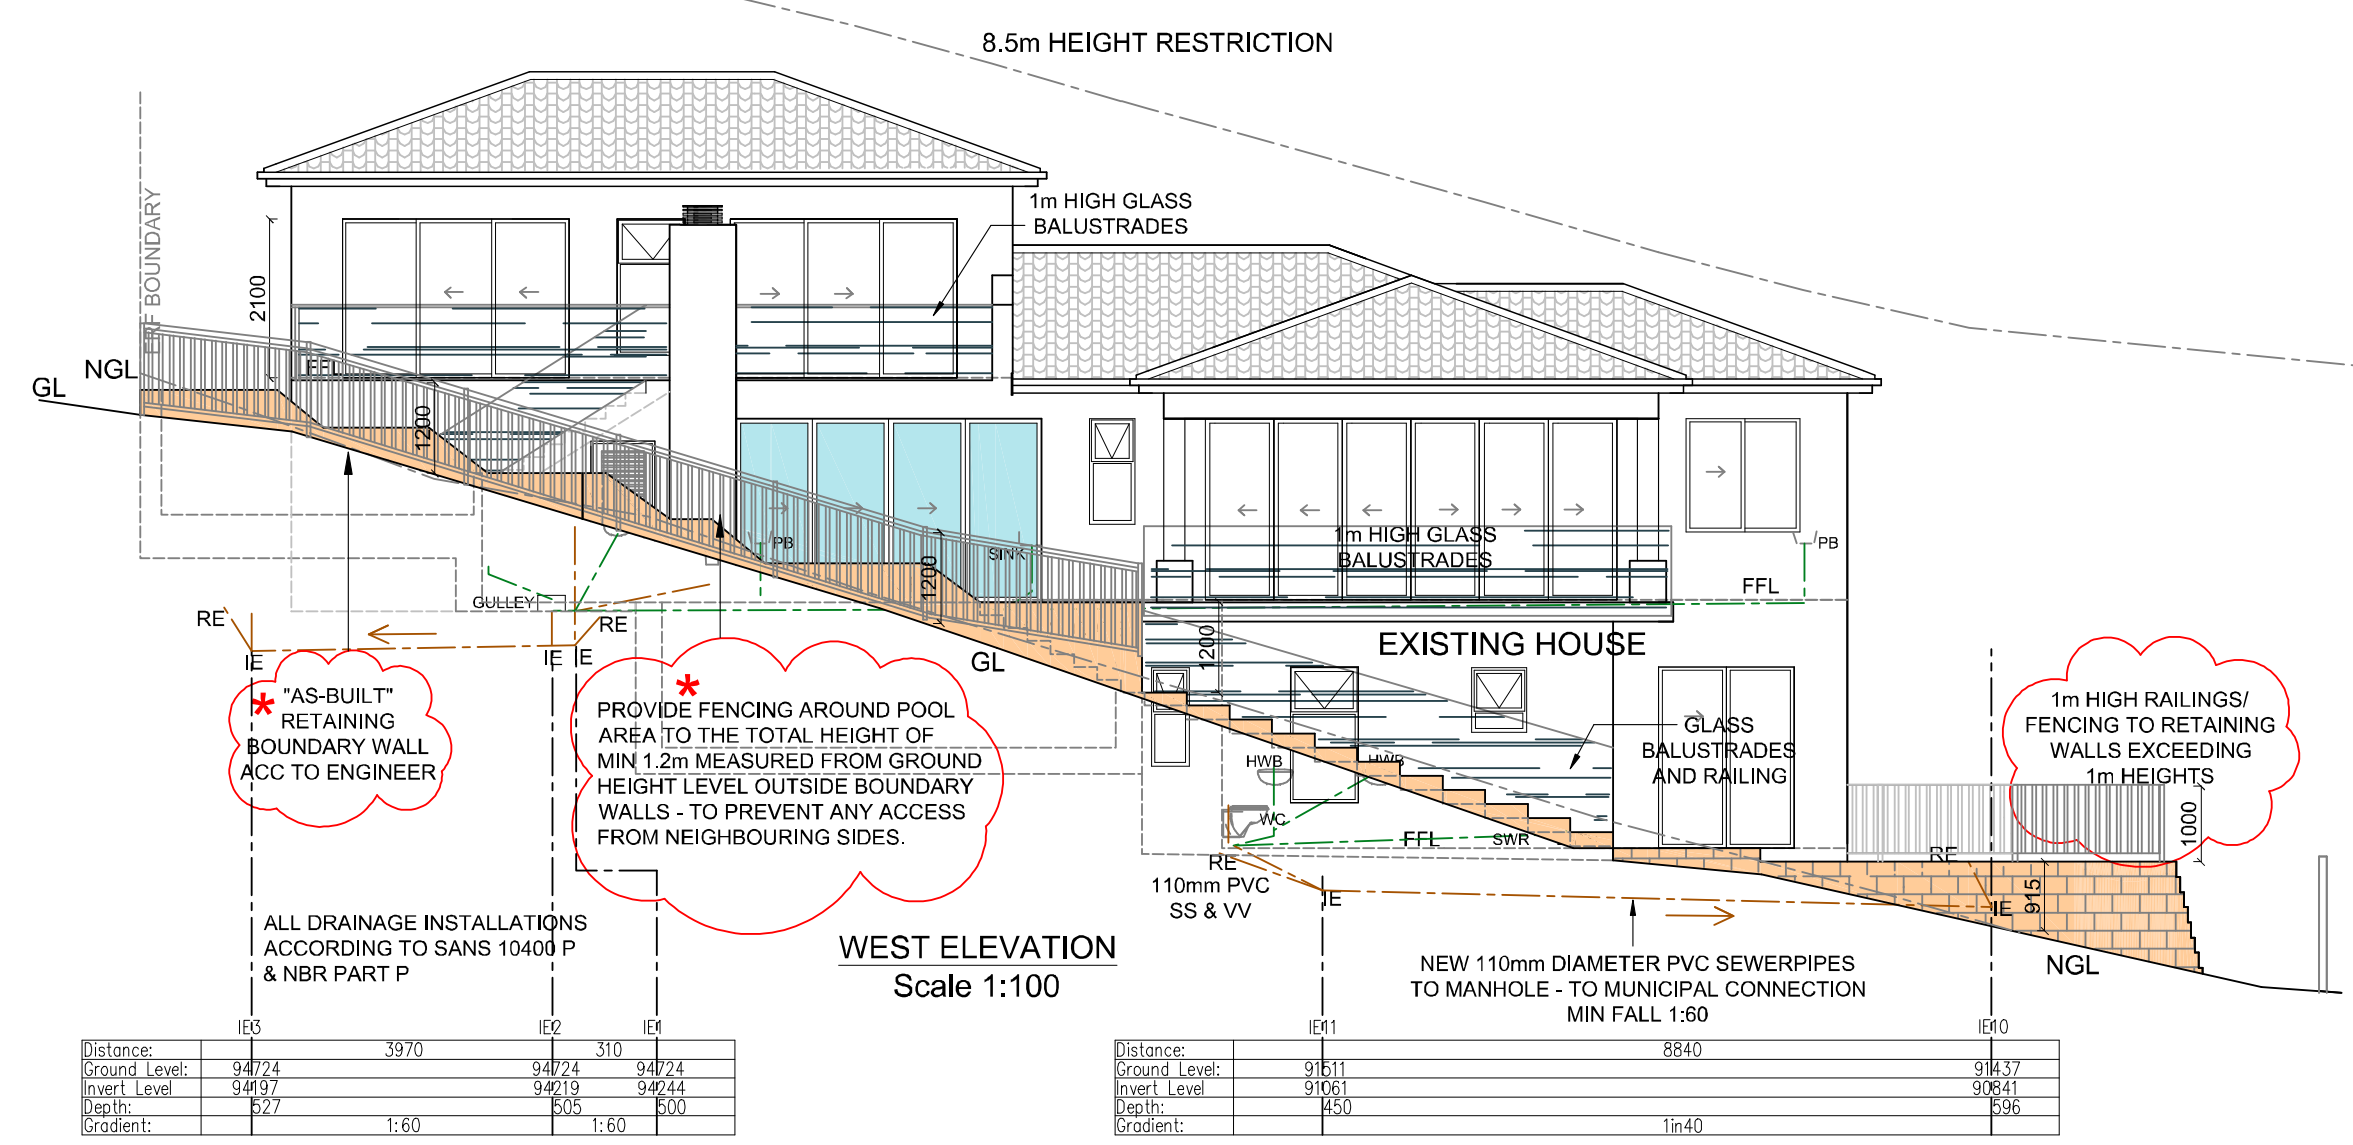
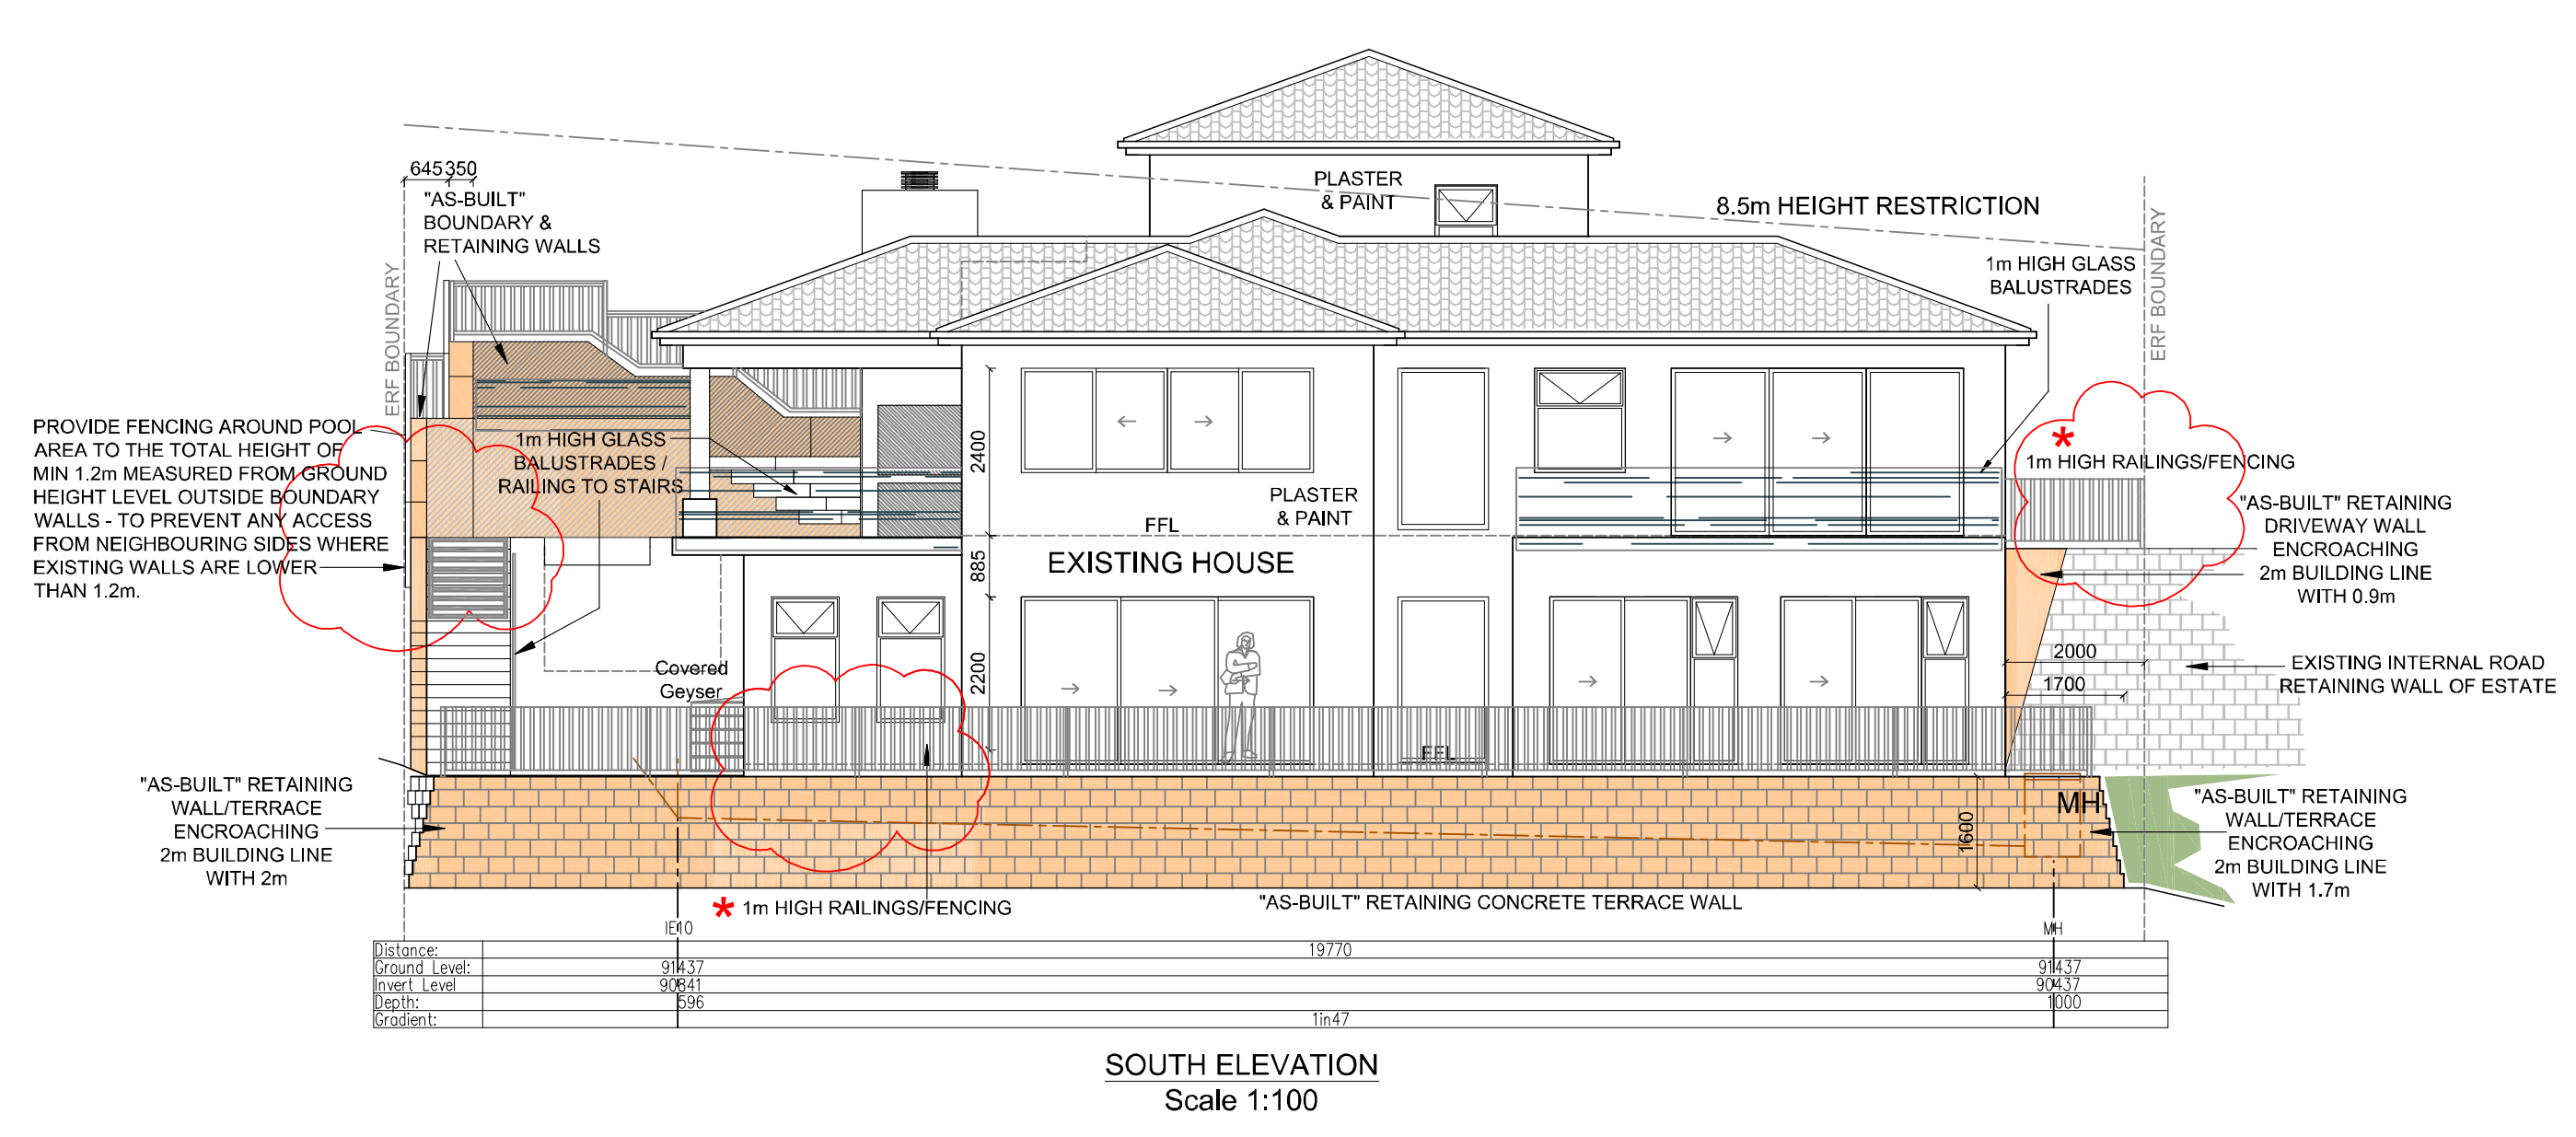


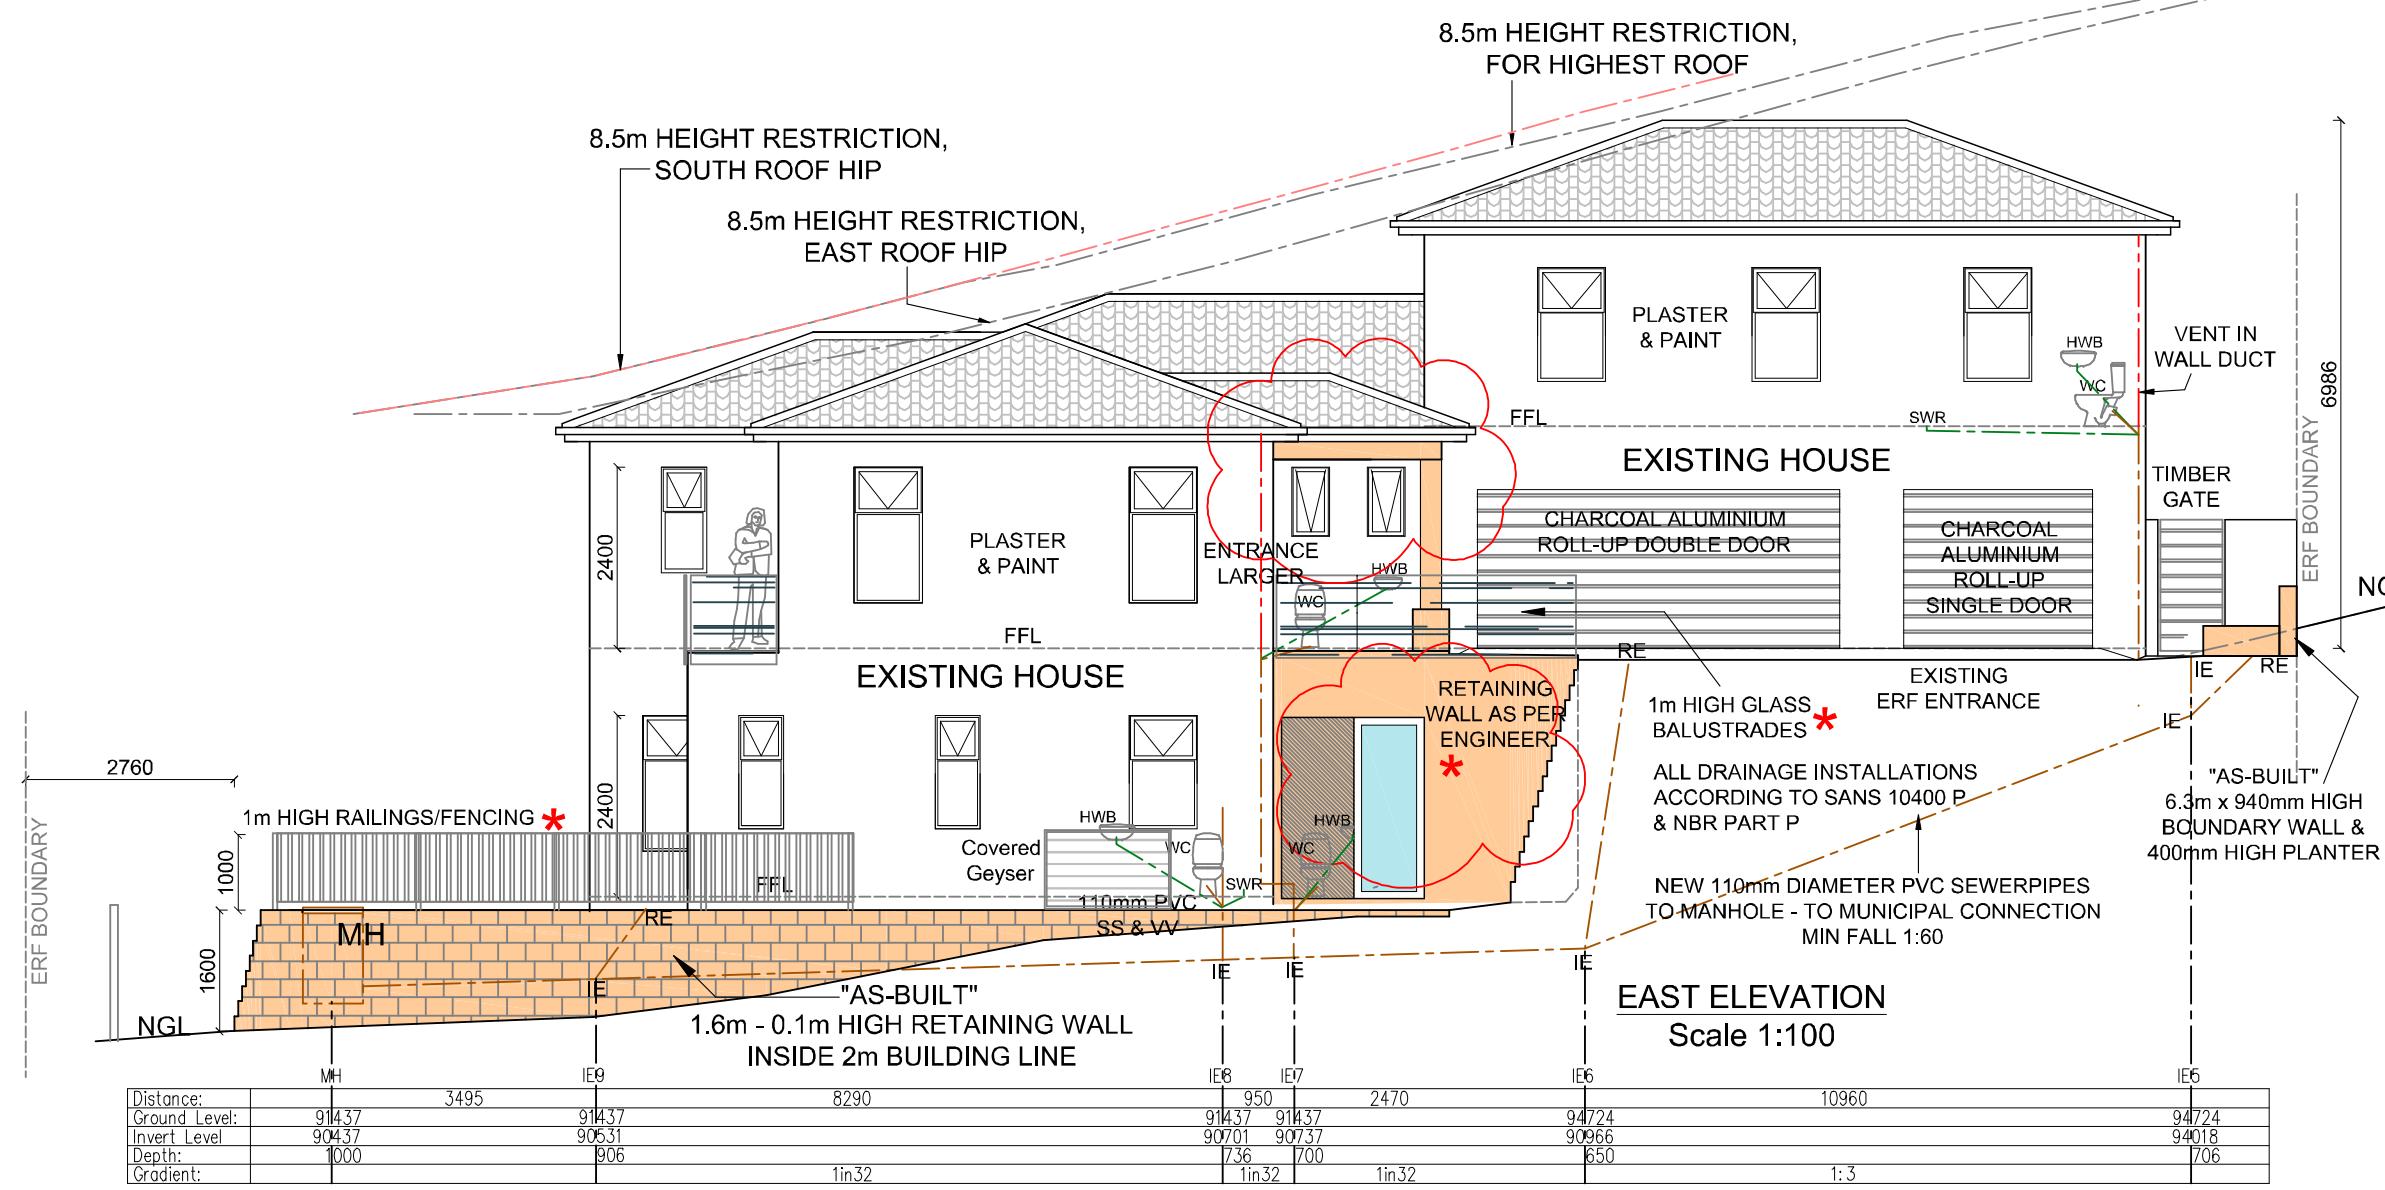

**BOUNDARY RETAINING
WALL SECTION**
Scale 1:100

REAS:	EXISTING:	AS-BUILT/DEVIATION:
AIN LEVEL:	195m2	206m2
COVERED PATIOS:	40.5m2	32.7m2
OWER LEVEL:	135.5m2	137.8m2
OID/STORAGE:	26m2	34m2
RST FLOOR FLAT:	60m2	60m2
POOL:	15m2	15m2
PEN PATIOS:	46.5m2	76.3m2
TOTAL:	446m2	485.5m2
		39.5m2 Additional m2
RF:	750m2	750m2
OOTPRINT:	244m2	247.2m2
VERAGE:	32.5%	33%
0% ALLOWED)		
OUNDARY WALL:	22.5m	22.34m
ORTH BOUNDARY	---	8.4m
WALL: ("As-Built")		
ETAINING BLOCK	---	44m
ARDEN WALLS:		

5.5m2 - As-built

34m2 - New Area -Total: 39.5m Additional

Amended Plan

REV002/0526

CLIENT:

MR. & MRS. SHARROCKS

PROJECT:

DEVIATION OF APPROVED PLAN:
AS-BUILT ALTERATIONS/ADDITIONS
ON ERF 770, 6 LEROUXNA'S VUE
ESTATE, BRENTON ON SEA, KNYSNA

DRAWING TITLE:

**SITE PLAN, ELEVATIONS
& SECTION**

SHEET 1 OF 3(A1)

Scale: 1:200 / 1:100

DRAWN BY:

R JANSSEN

CHECKED BY:

Henry Paxton

DATE:

NOVEMBER 2025

PLAN NUMBER:

770K/0524b

COMPANY :

**PAXTON
ARCHITECTURAL
STUDIO** pr.st 1163

Henry Paxton

Sen. Arch. Technologist

129 Blombosch

Bietou street

Mossel Bay

6511

cell : 0825739449

e-mail : hpaxton8@gmail.com

SITE PLAN
Scale 1:200