
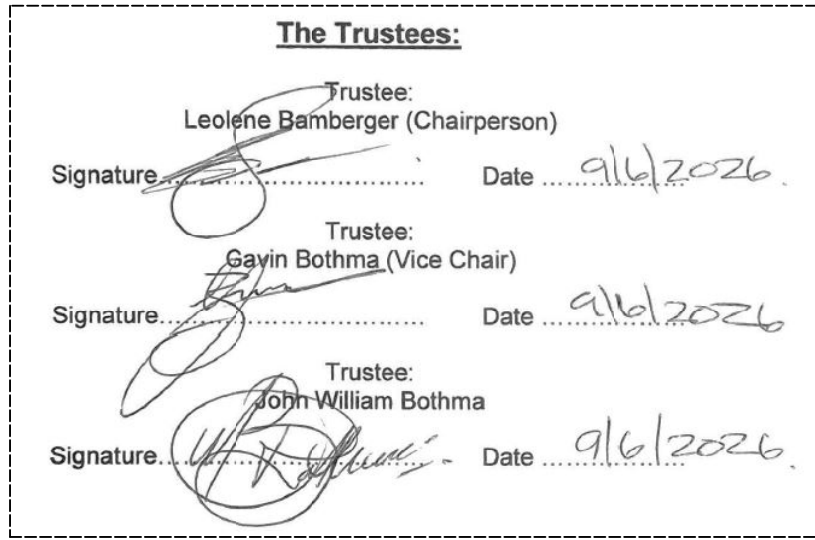


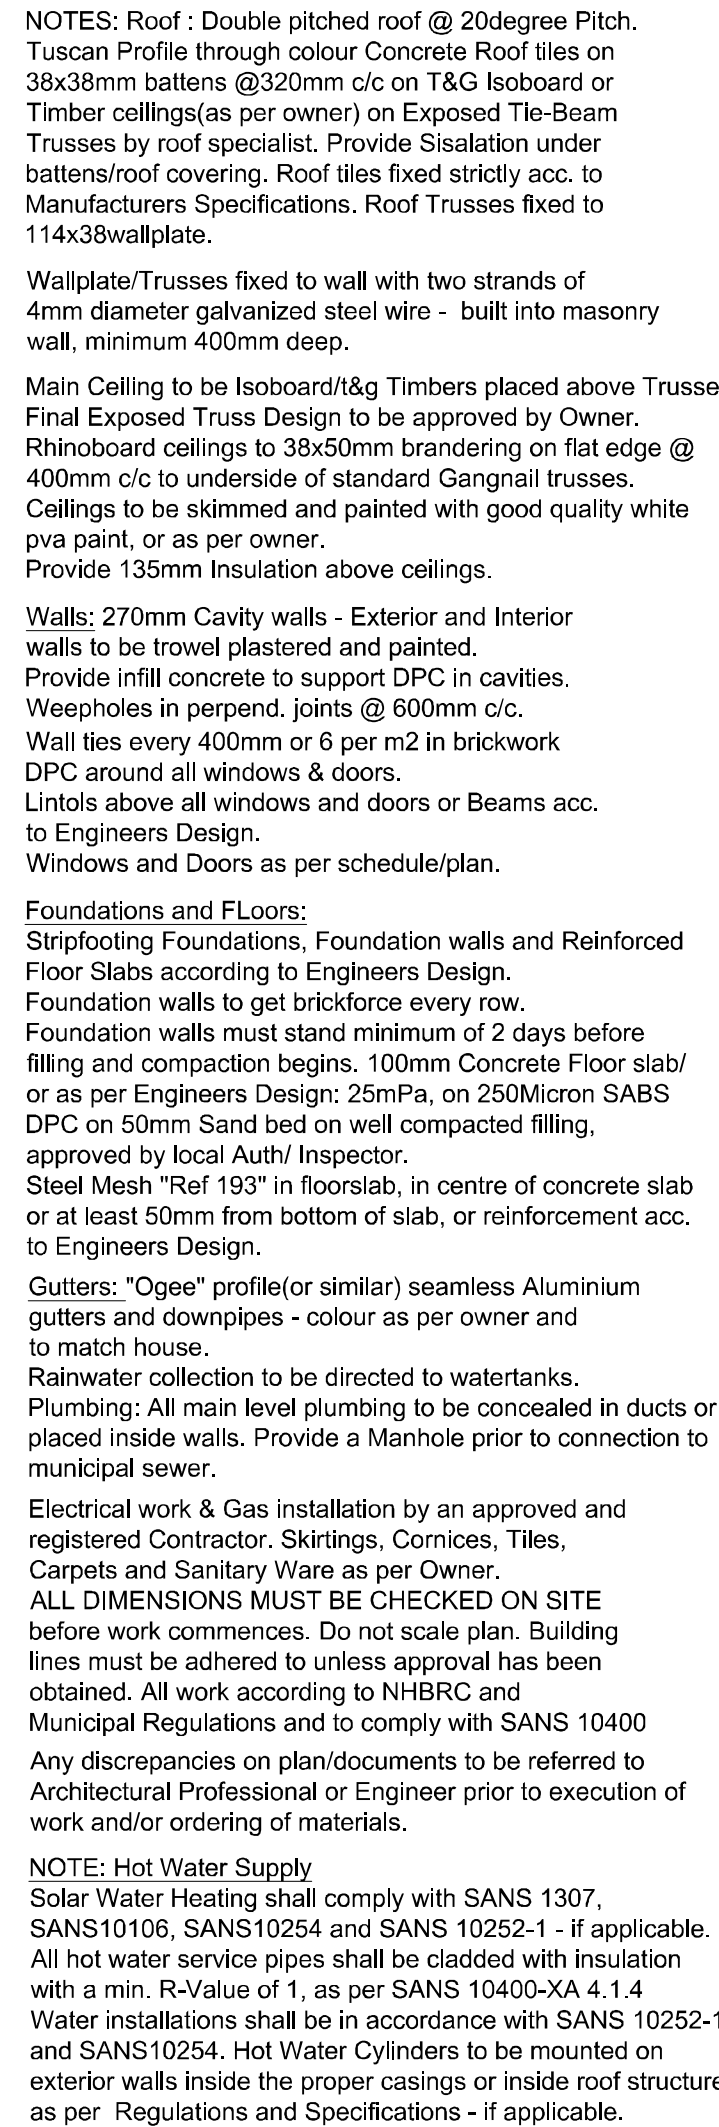

Amended Plan		REV002/0526
CLIENT:		
MR. & MRS. SHARROCKS		
PROJECT:		
REVISION OF APPROVED PLAN: AS BUILT ALTERATIONS/ADDITIONS ON ERF 770, 6 LEROUXNA'S VUE ESTATE, BRENTON ON SEA, KNYSNA		
DRAWING TITLE:		
FLOOR PLAN: LOWER LEVEL AND FLAT		
SHEET 3 OF 3(A1)		
Scale: 1:50		
DRAWN BY: R JANSEN		CHECKED BY: Henry Paxton
DATE: NOVEMBER 2025		PLAN NUMBER: 770/K05924b
COMPANY :		
PAXTON ARCHITECTURAL STUDIO pract 1163		
Henry Paxton Sen. Arch. Technologist 129 Blombosch Bietou street Mossel Bay 6511 cell : 0825739449 e-mail : hpxstpn@gmail.com		