


TIN
SCALE 1:100

Y 2450
X 3773070

Y 2420
X 3773070

Y 2450
X 3773090

Y 2420
X 3773090

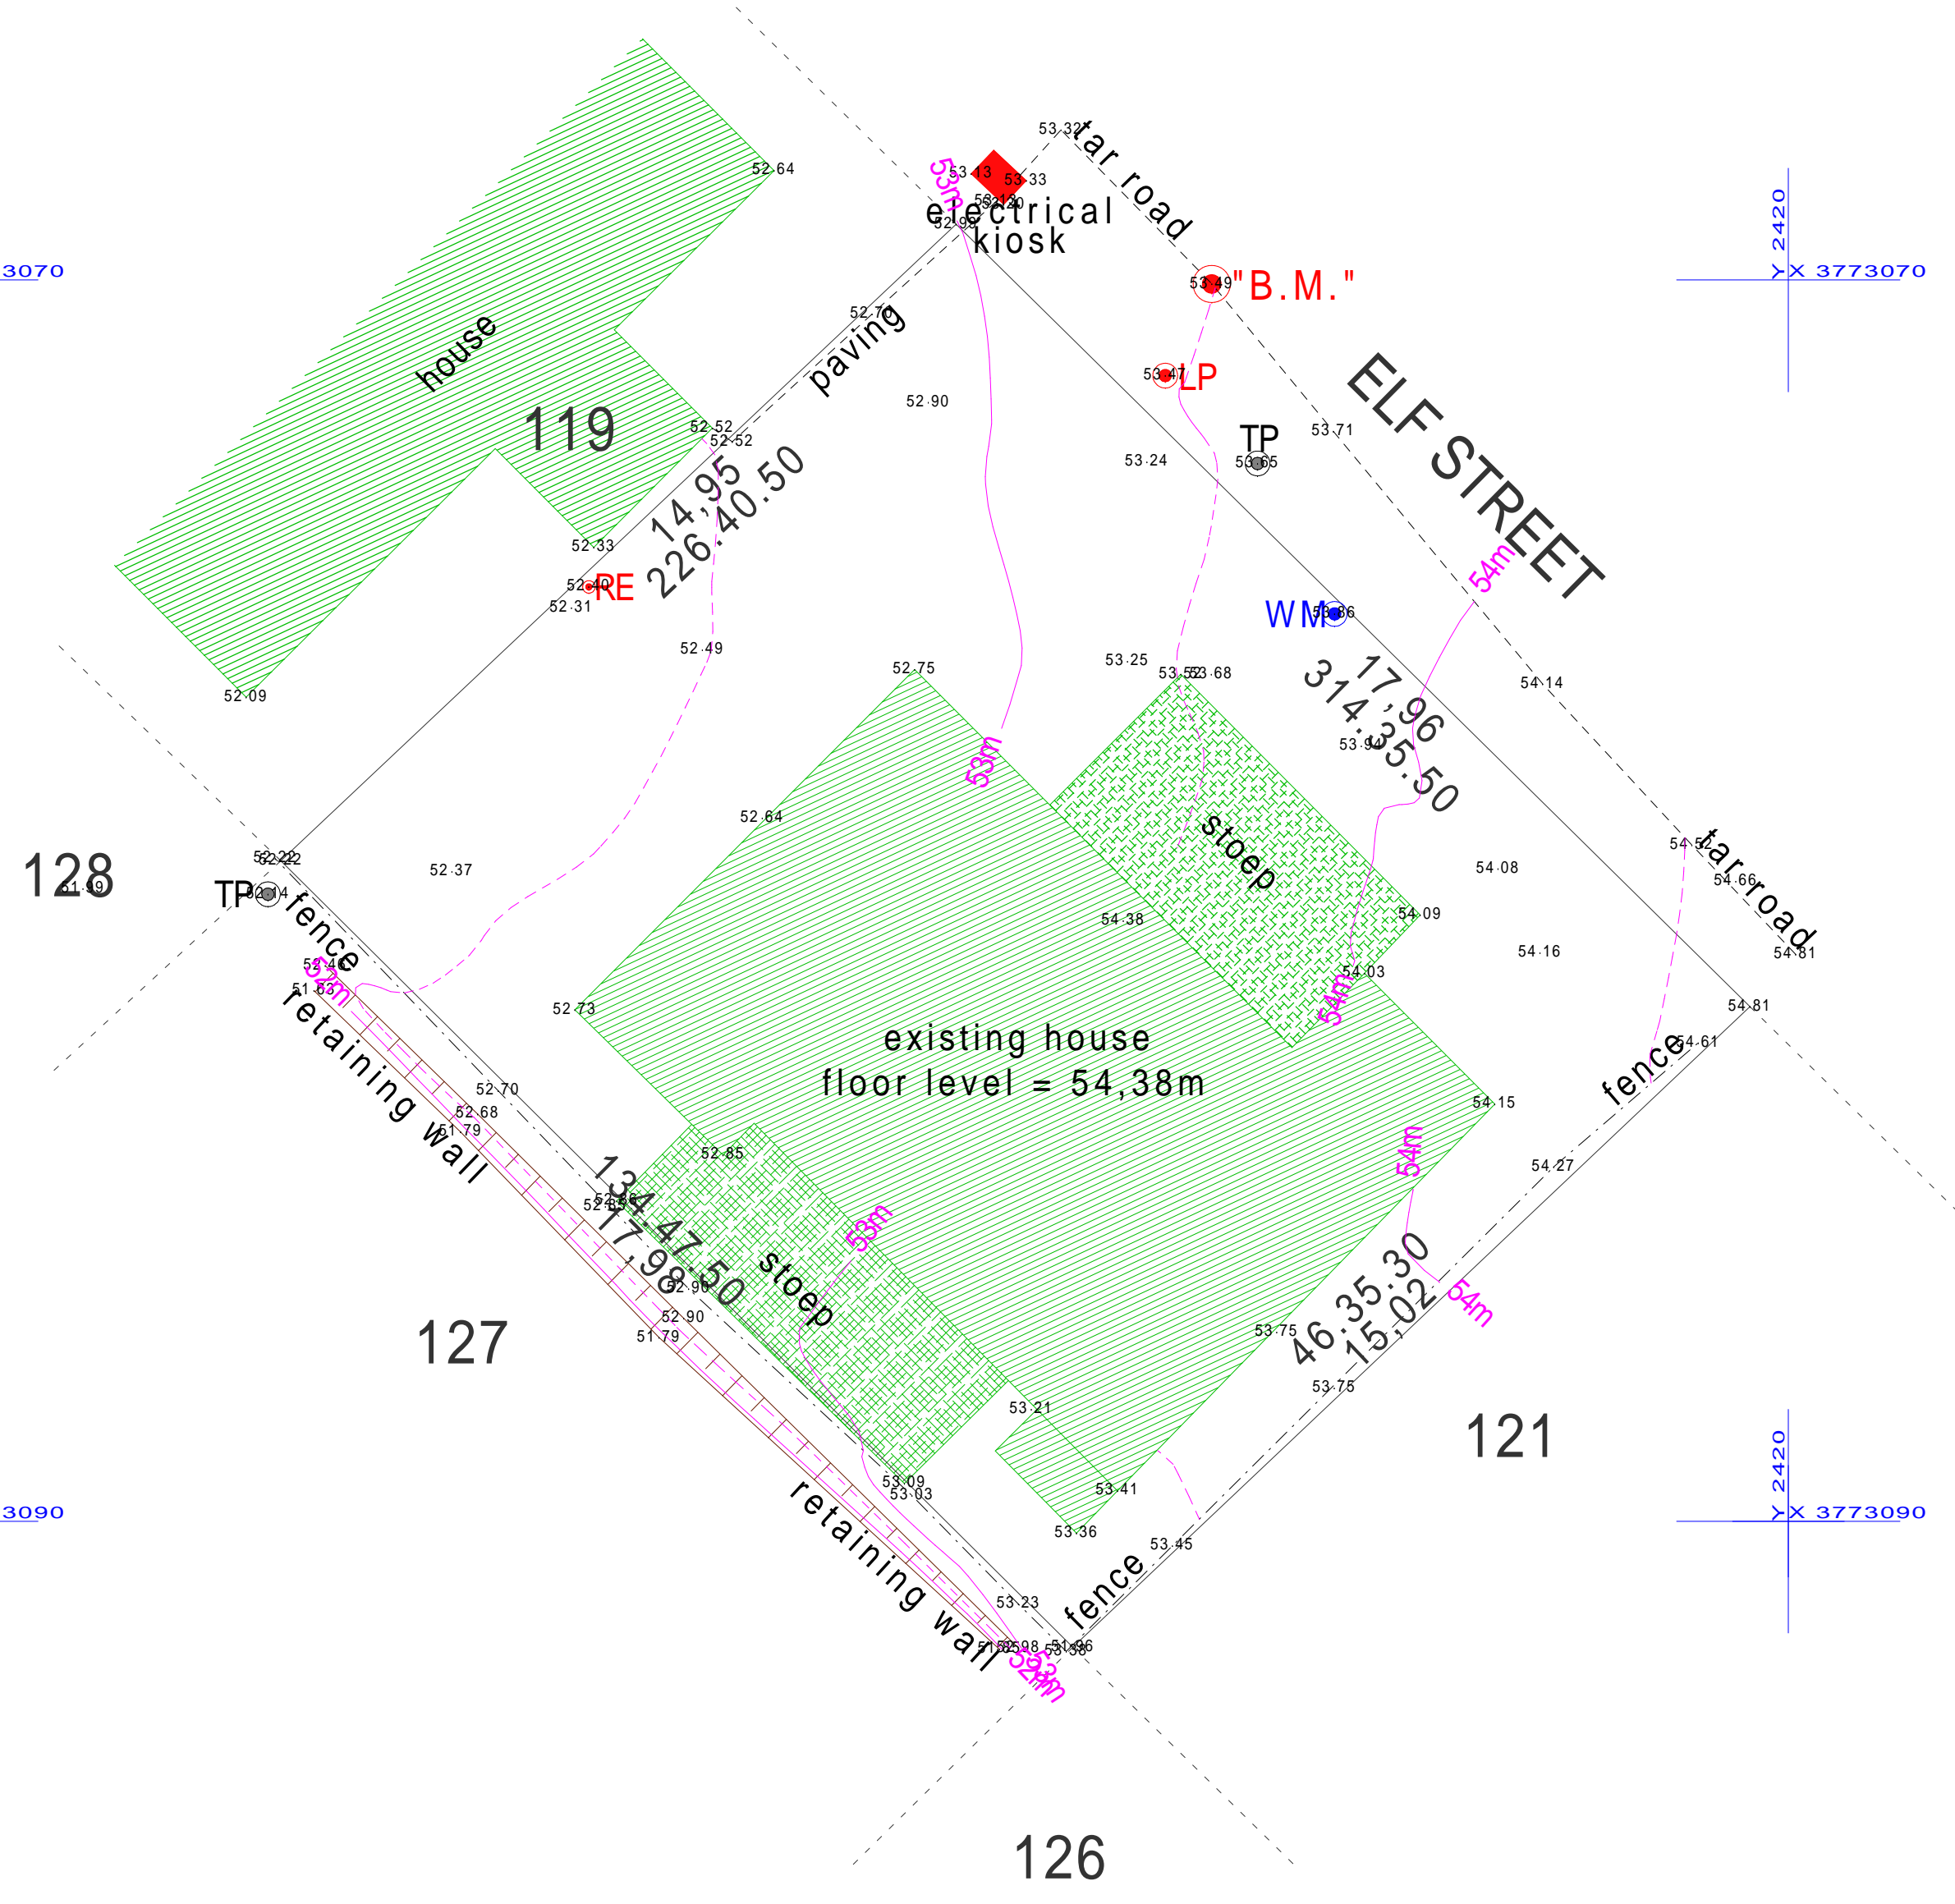

NOTES:
 1. Heights are based on an arbitrary level.
 2. Bench Mark = "BM" = 53.49m = stud in tar.
 3. Cadastral beacons have been verified in the field by survey in conjunction with Professional Land Surveyor Henk Le Roux (PLS 1055).
 4. Co-ordinate system = LO.23.
 5. Legend:
 ● LP = Lampost
 ⊙ TP = Telephone Pole
 ⊙ RE = Rodding Eye
 ⊙ WM = Water Meter

SCALE:
1 : 100

DATE OF SURVEY:
JULY 2015

CLIENT:
D. TERBLANCHE

JOB DESCRIPTION:
CONTOUR/SITE PLAN

PROPERTY:
ERF 120 BUFFALO BAY

DRAWING NO:
BB120CP.1

EDEN GEOMATICS
 Topographical & Engineering Surveyors
 P.O.Box 346 Knysna 6570
 Andre Genade 072 993 8665
 andre@edengeomatics.co.za
 Nick Foster 071 621 2409
 nick@edengeomatics.co.za