


Detailing the building line encroachments

Agapanthus Avenue

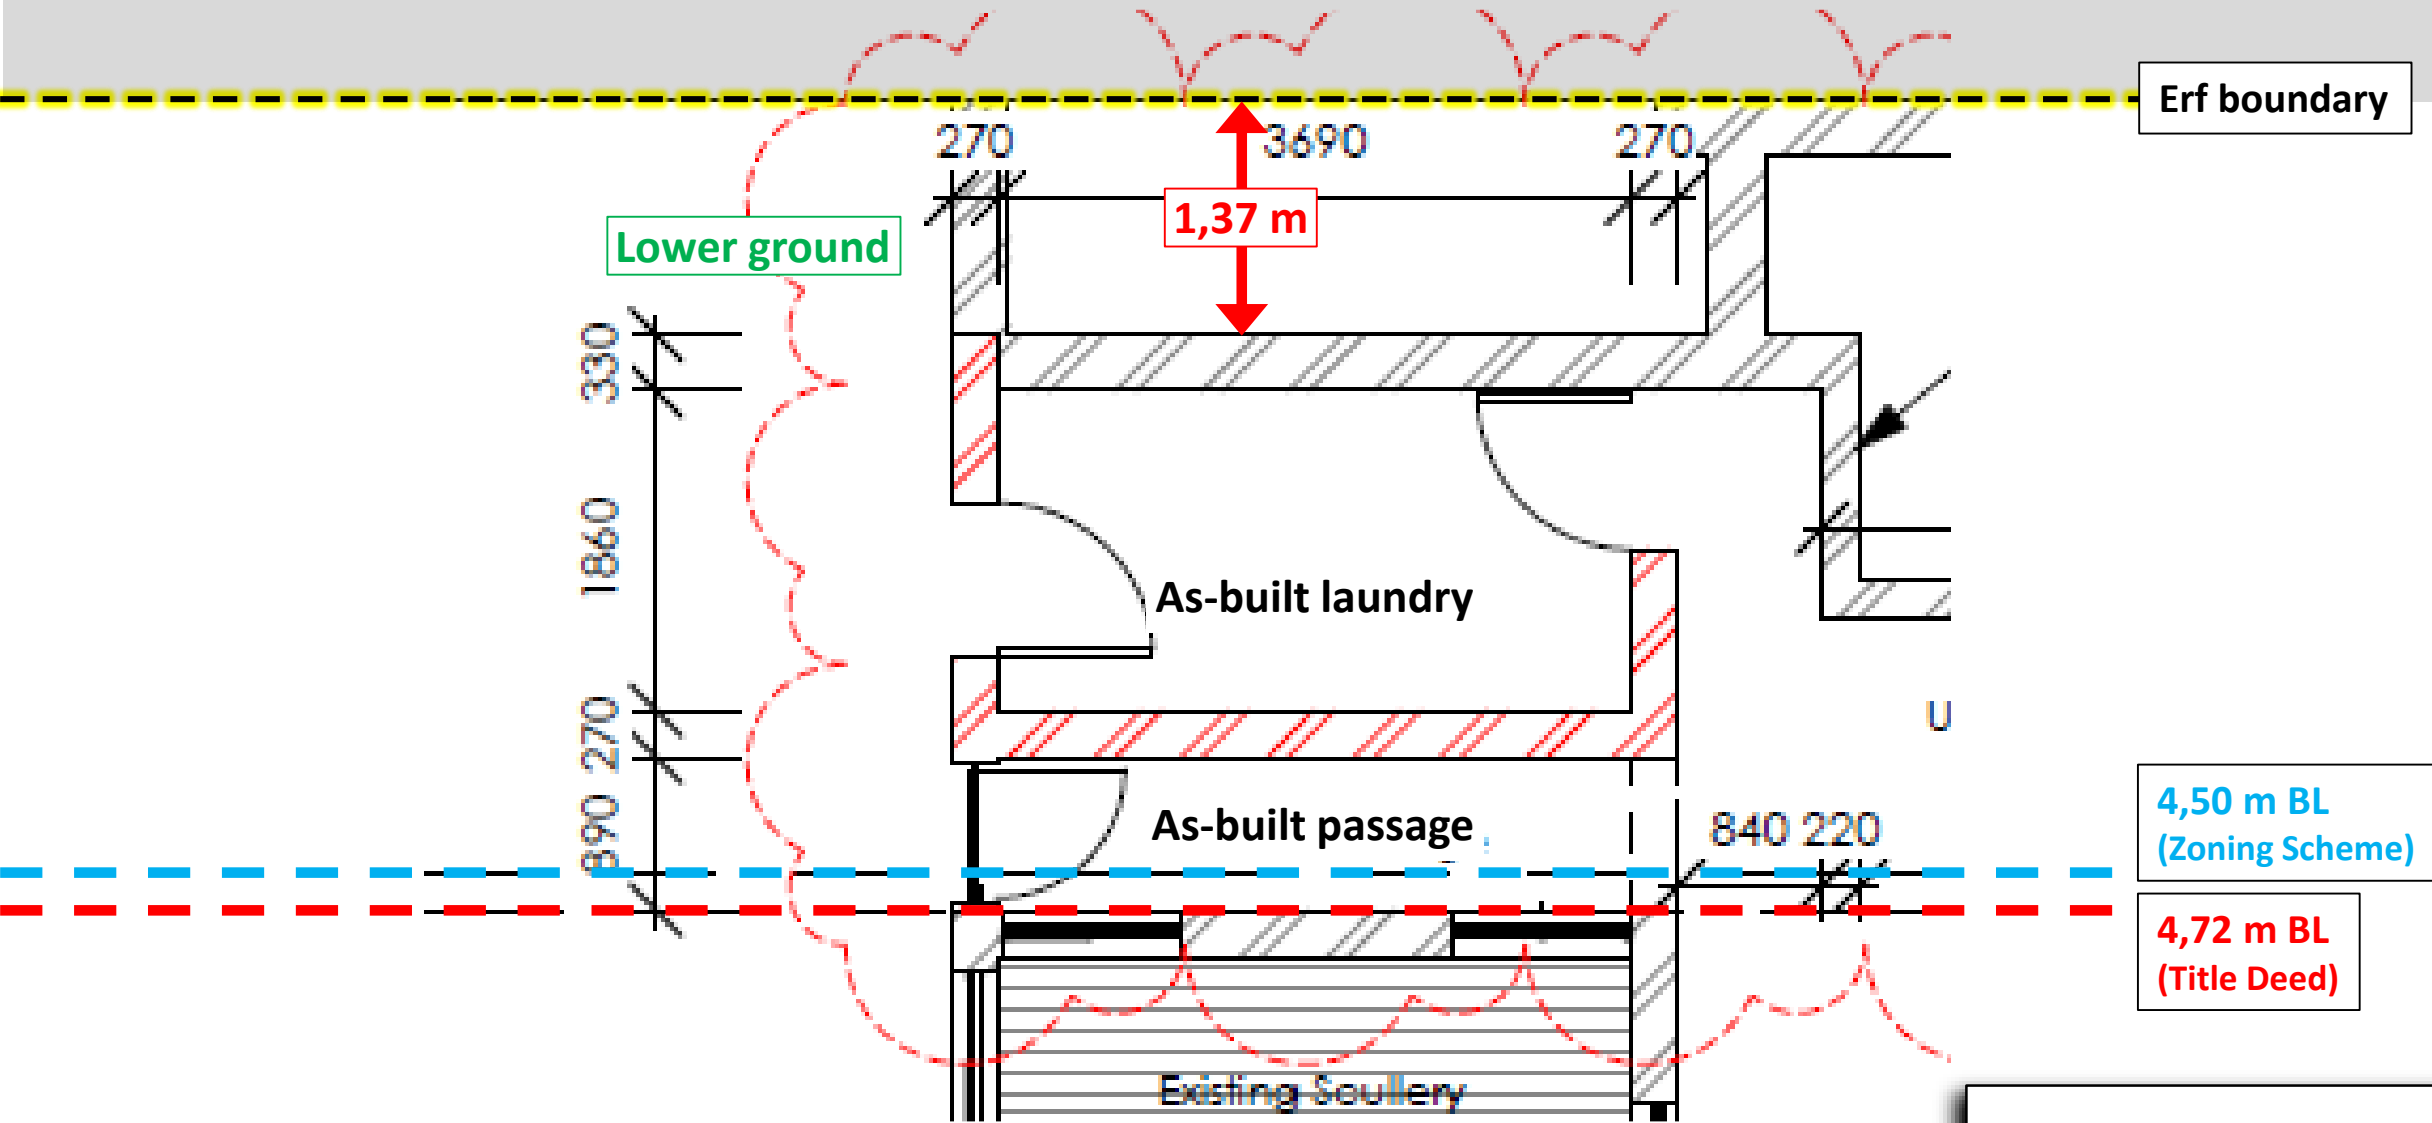

Annexure H