


SCALE 1:100

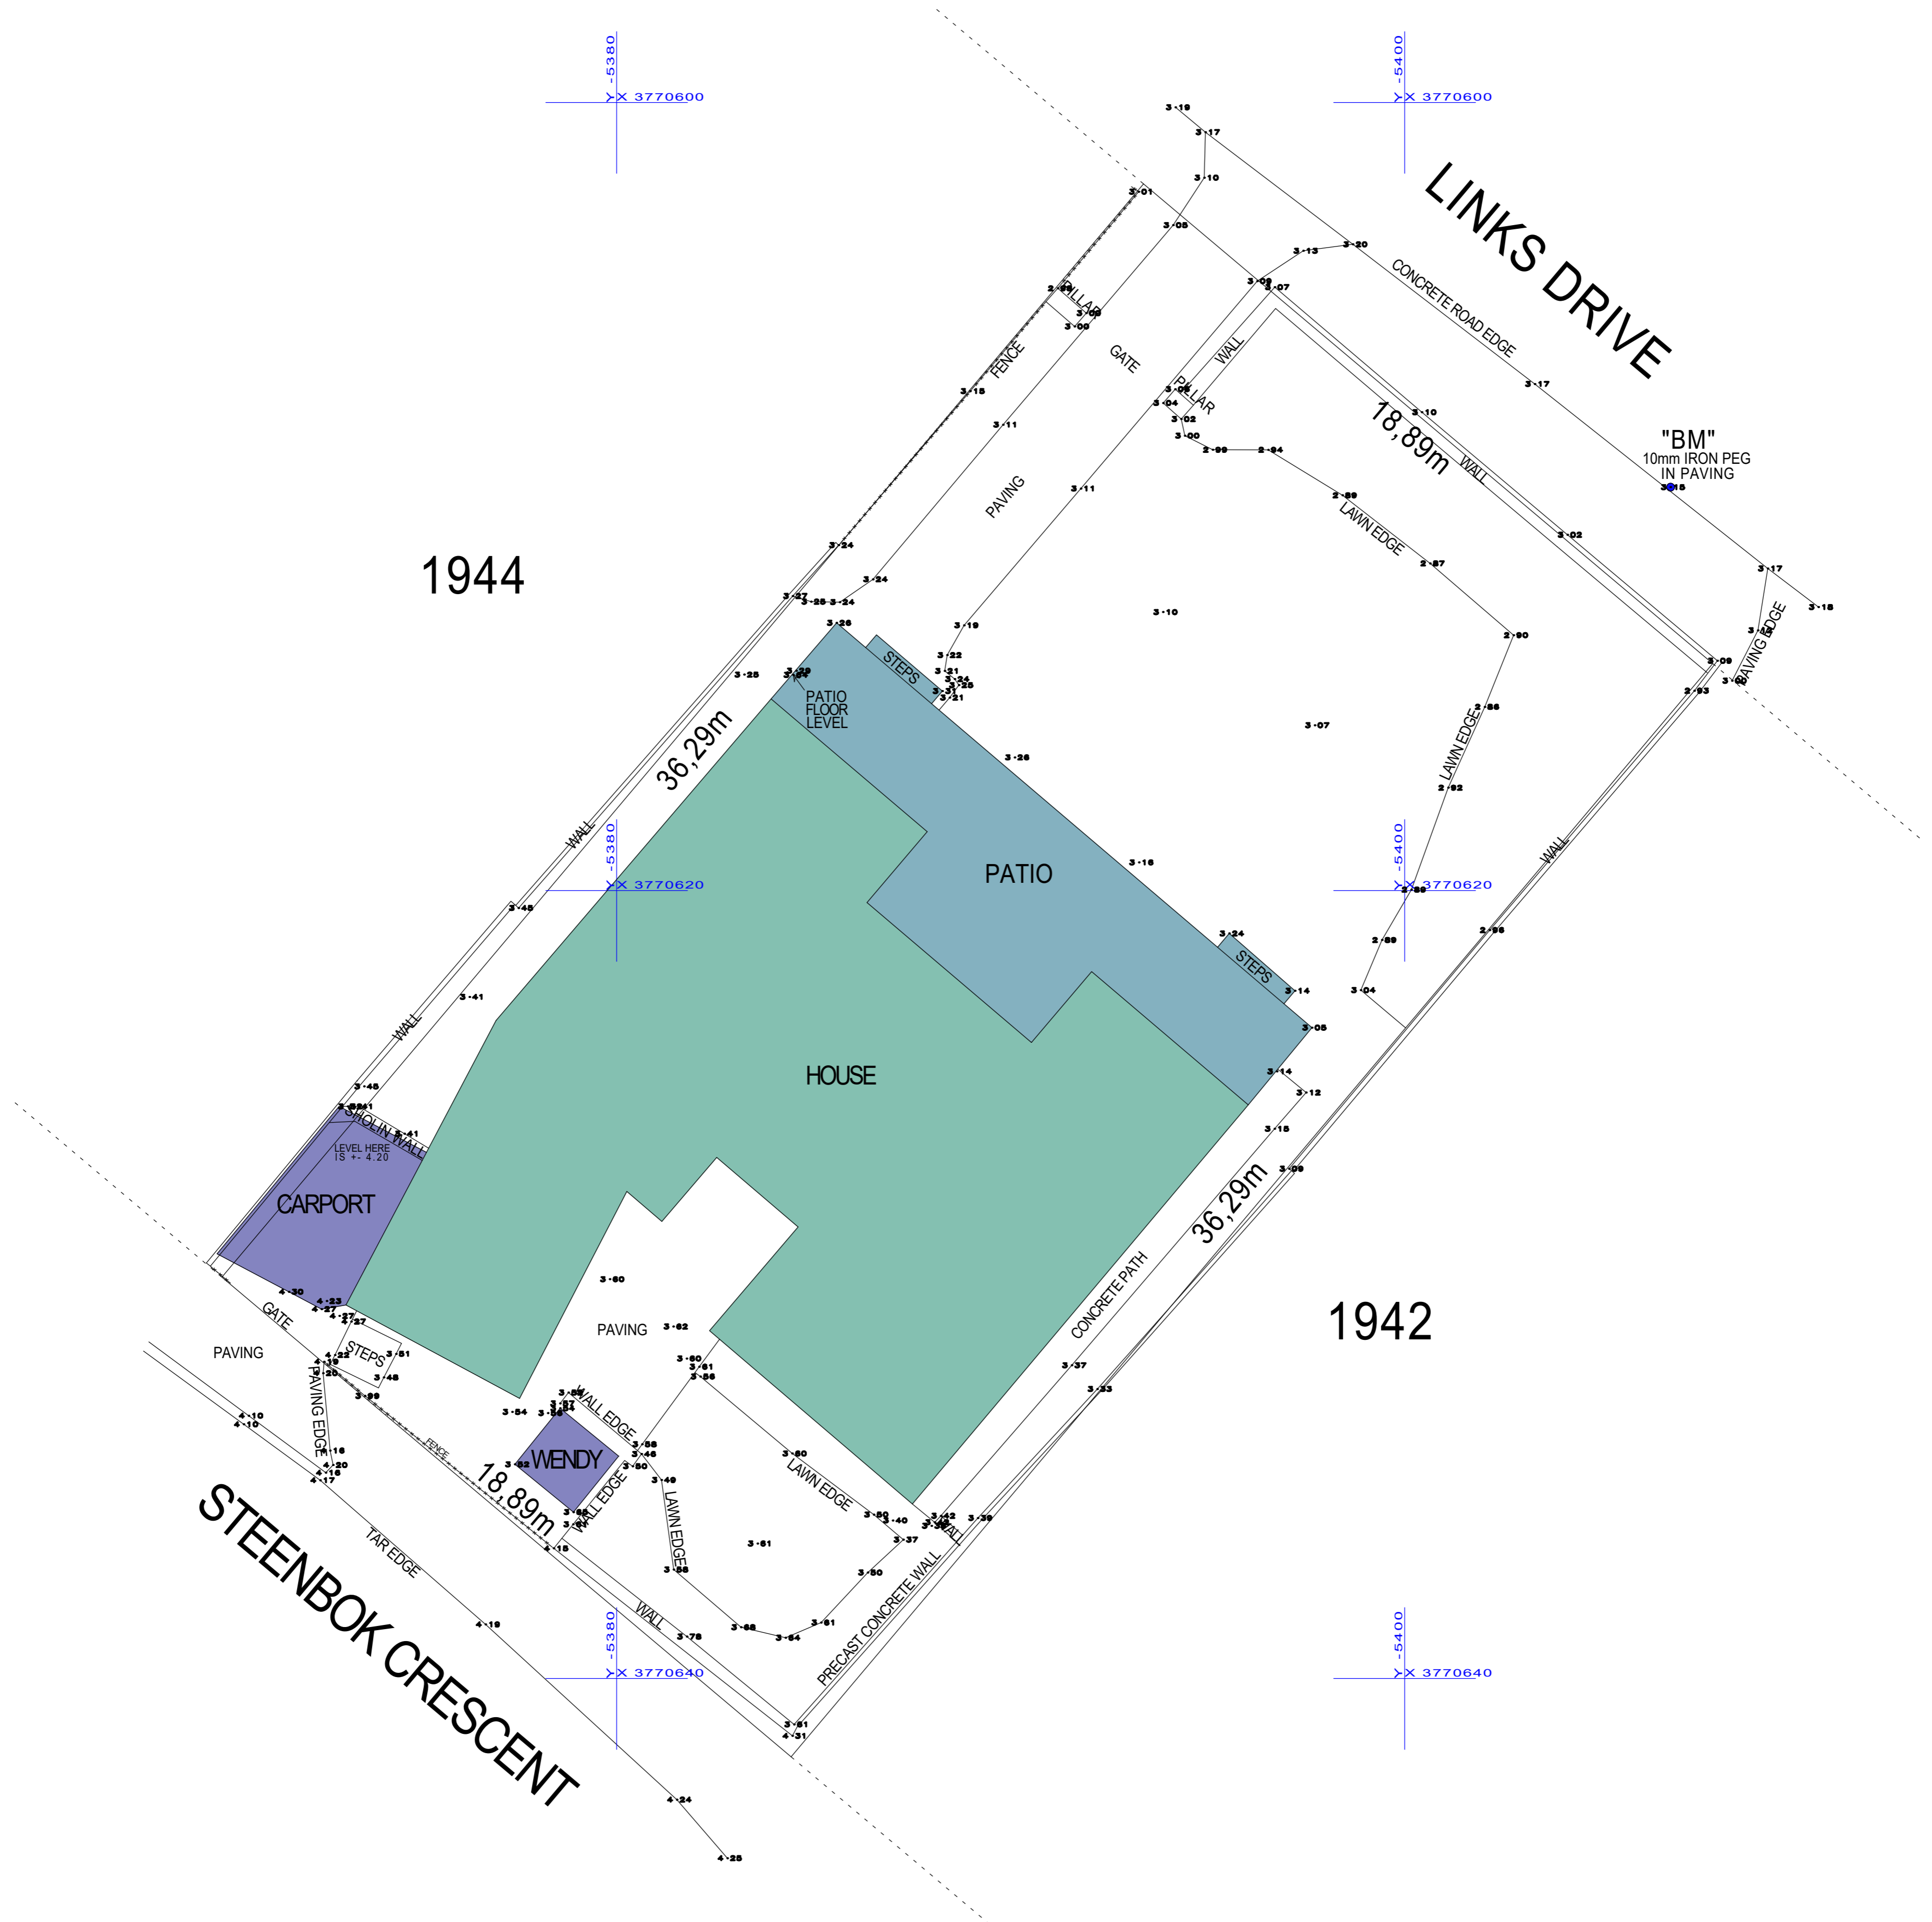

NOTES:	
1.	Heights are based on Approximate Mean Sea Level.
2.	Bench Mark = "BM" = 10mm iron-peg in concrete road = 3.15m
3.	Co-ordinate system = Lo23.
SCALE:	A1 / 1:100
DATE OF SURVEY:	NOVEMBER 2021
CLIENT:	ANDREW JOHNSTONE
JOB DESCRIPTION:	SITE / LEVEL PLAN
PROPERTY:	ERF 1943 KNYSNA [LEISURE ISLE]
DRAWING NO:	K1943SP
EDEN GEOMATICS Topographical & Engineering Surveyors P.O. Box 346 Knysna 6570 Andre Genade 072 993 8665 andre@edengeomatics.co.za Nick Foster 071 621 2409 nick@edengeomatics.co.za	