



first floor

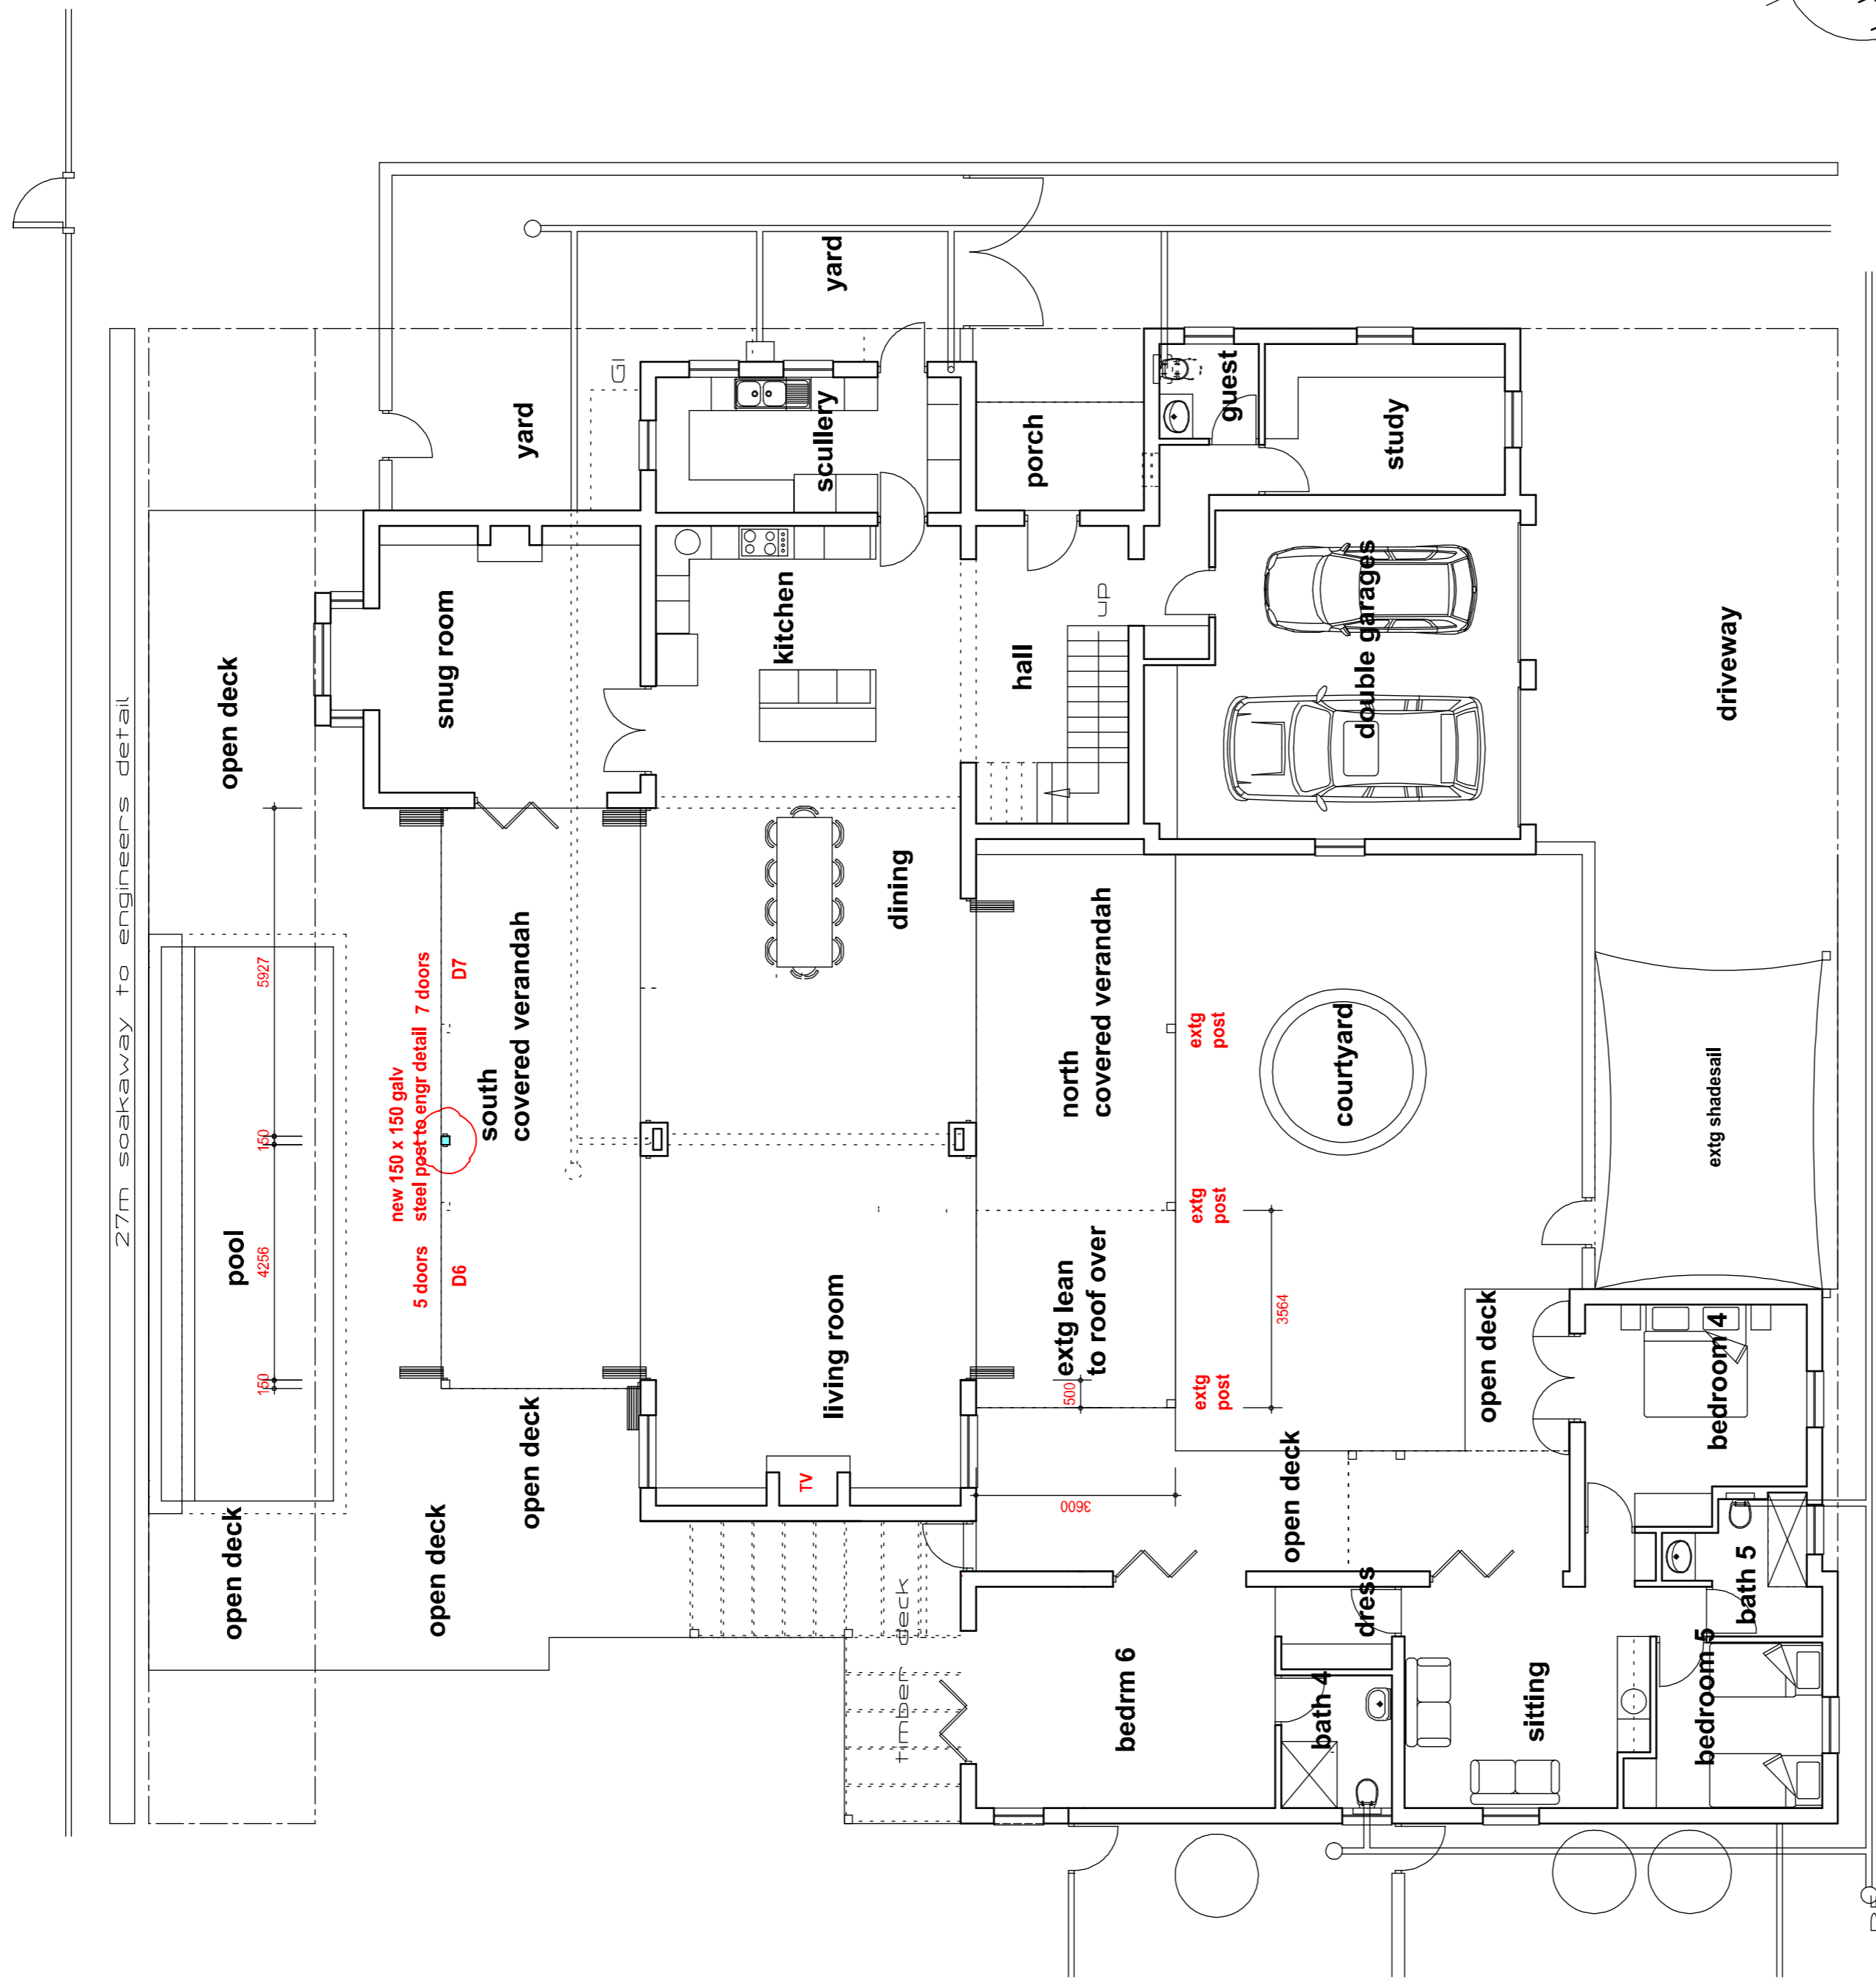

ground floor

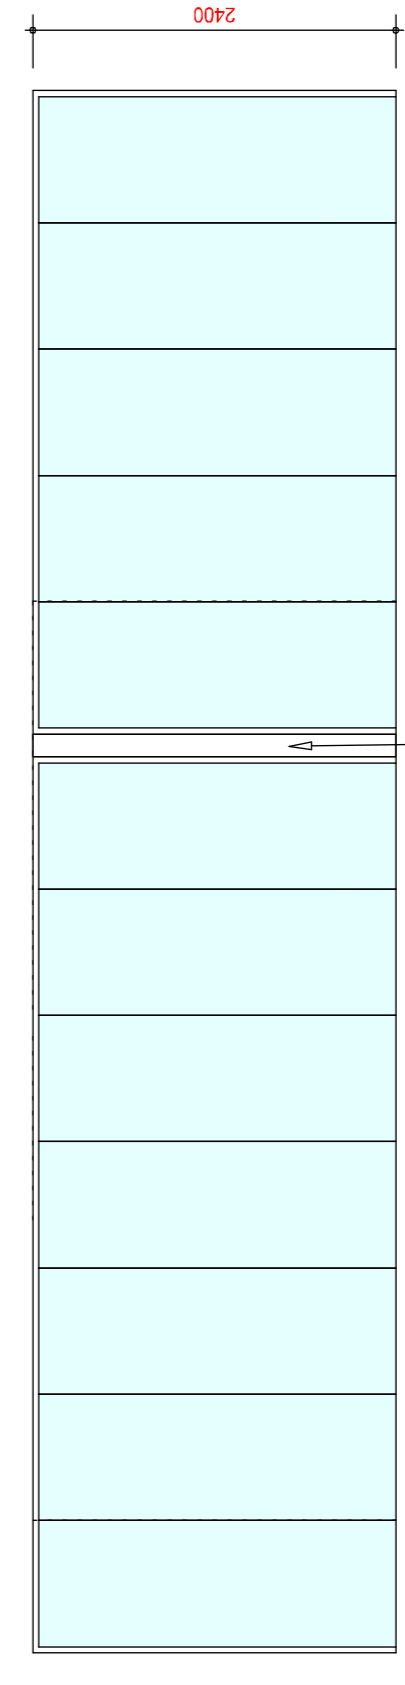

D6 sunflex SD25 slide turn and stack frameless door system
 150mm gluv steel column
 D7 sunflex SD25 slide turn and stack frameless door system

27m skakaway to engineers detail

 D7

extg lean to roof over
 165
 3564
 extg post
 extg post
 extg post

596 4256

2400