



Site Development Plan (retaining structures)

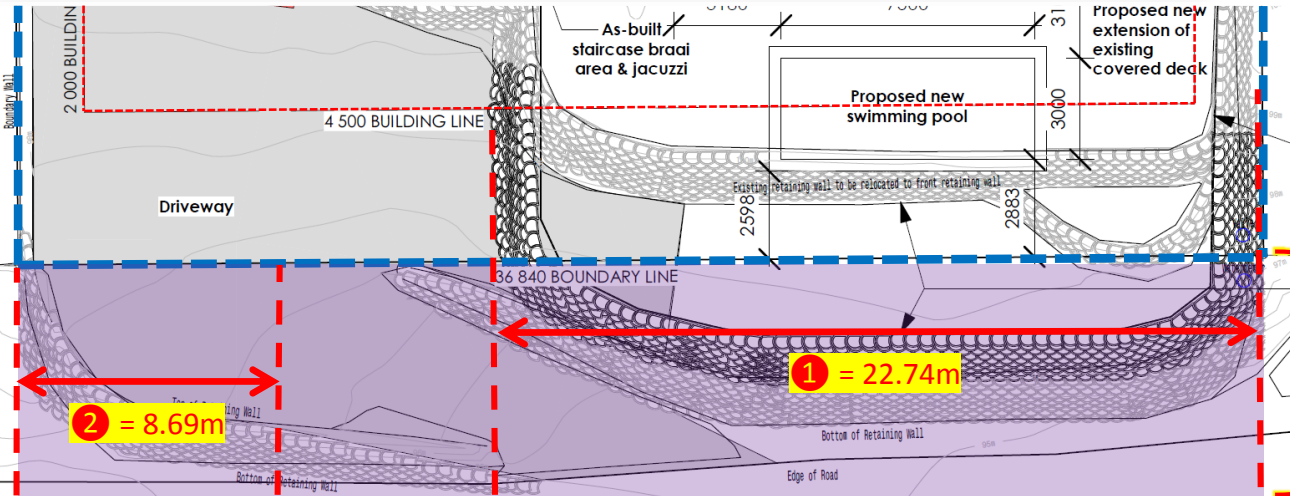

LEGEND

Zoning Scheme B.L.	---
Erf boundary	----
Lease area	■

Width of retaining structures higher than 2.0m

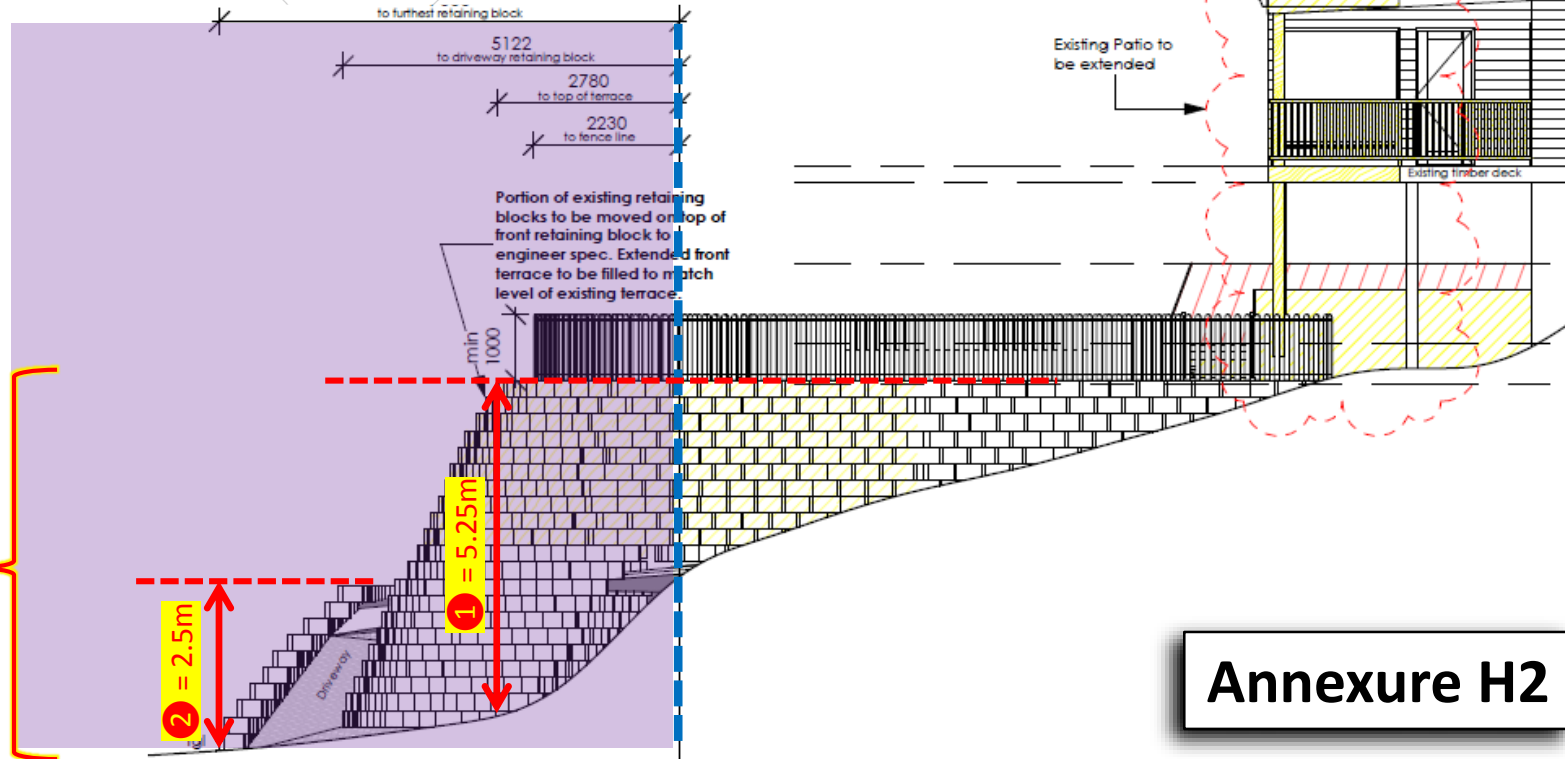

Height of retaining structures

Annexure H2