


SCALE 1:100

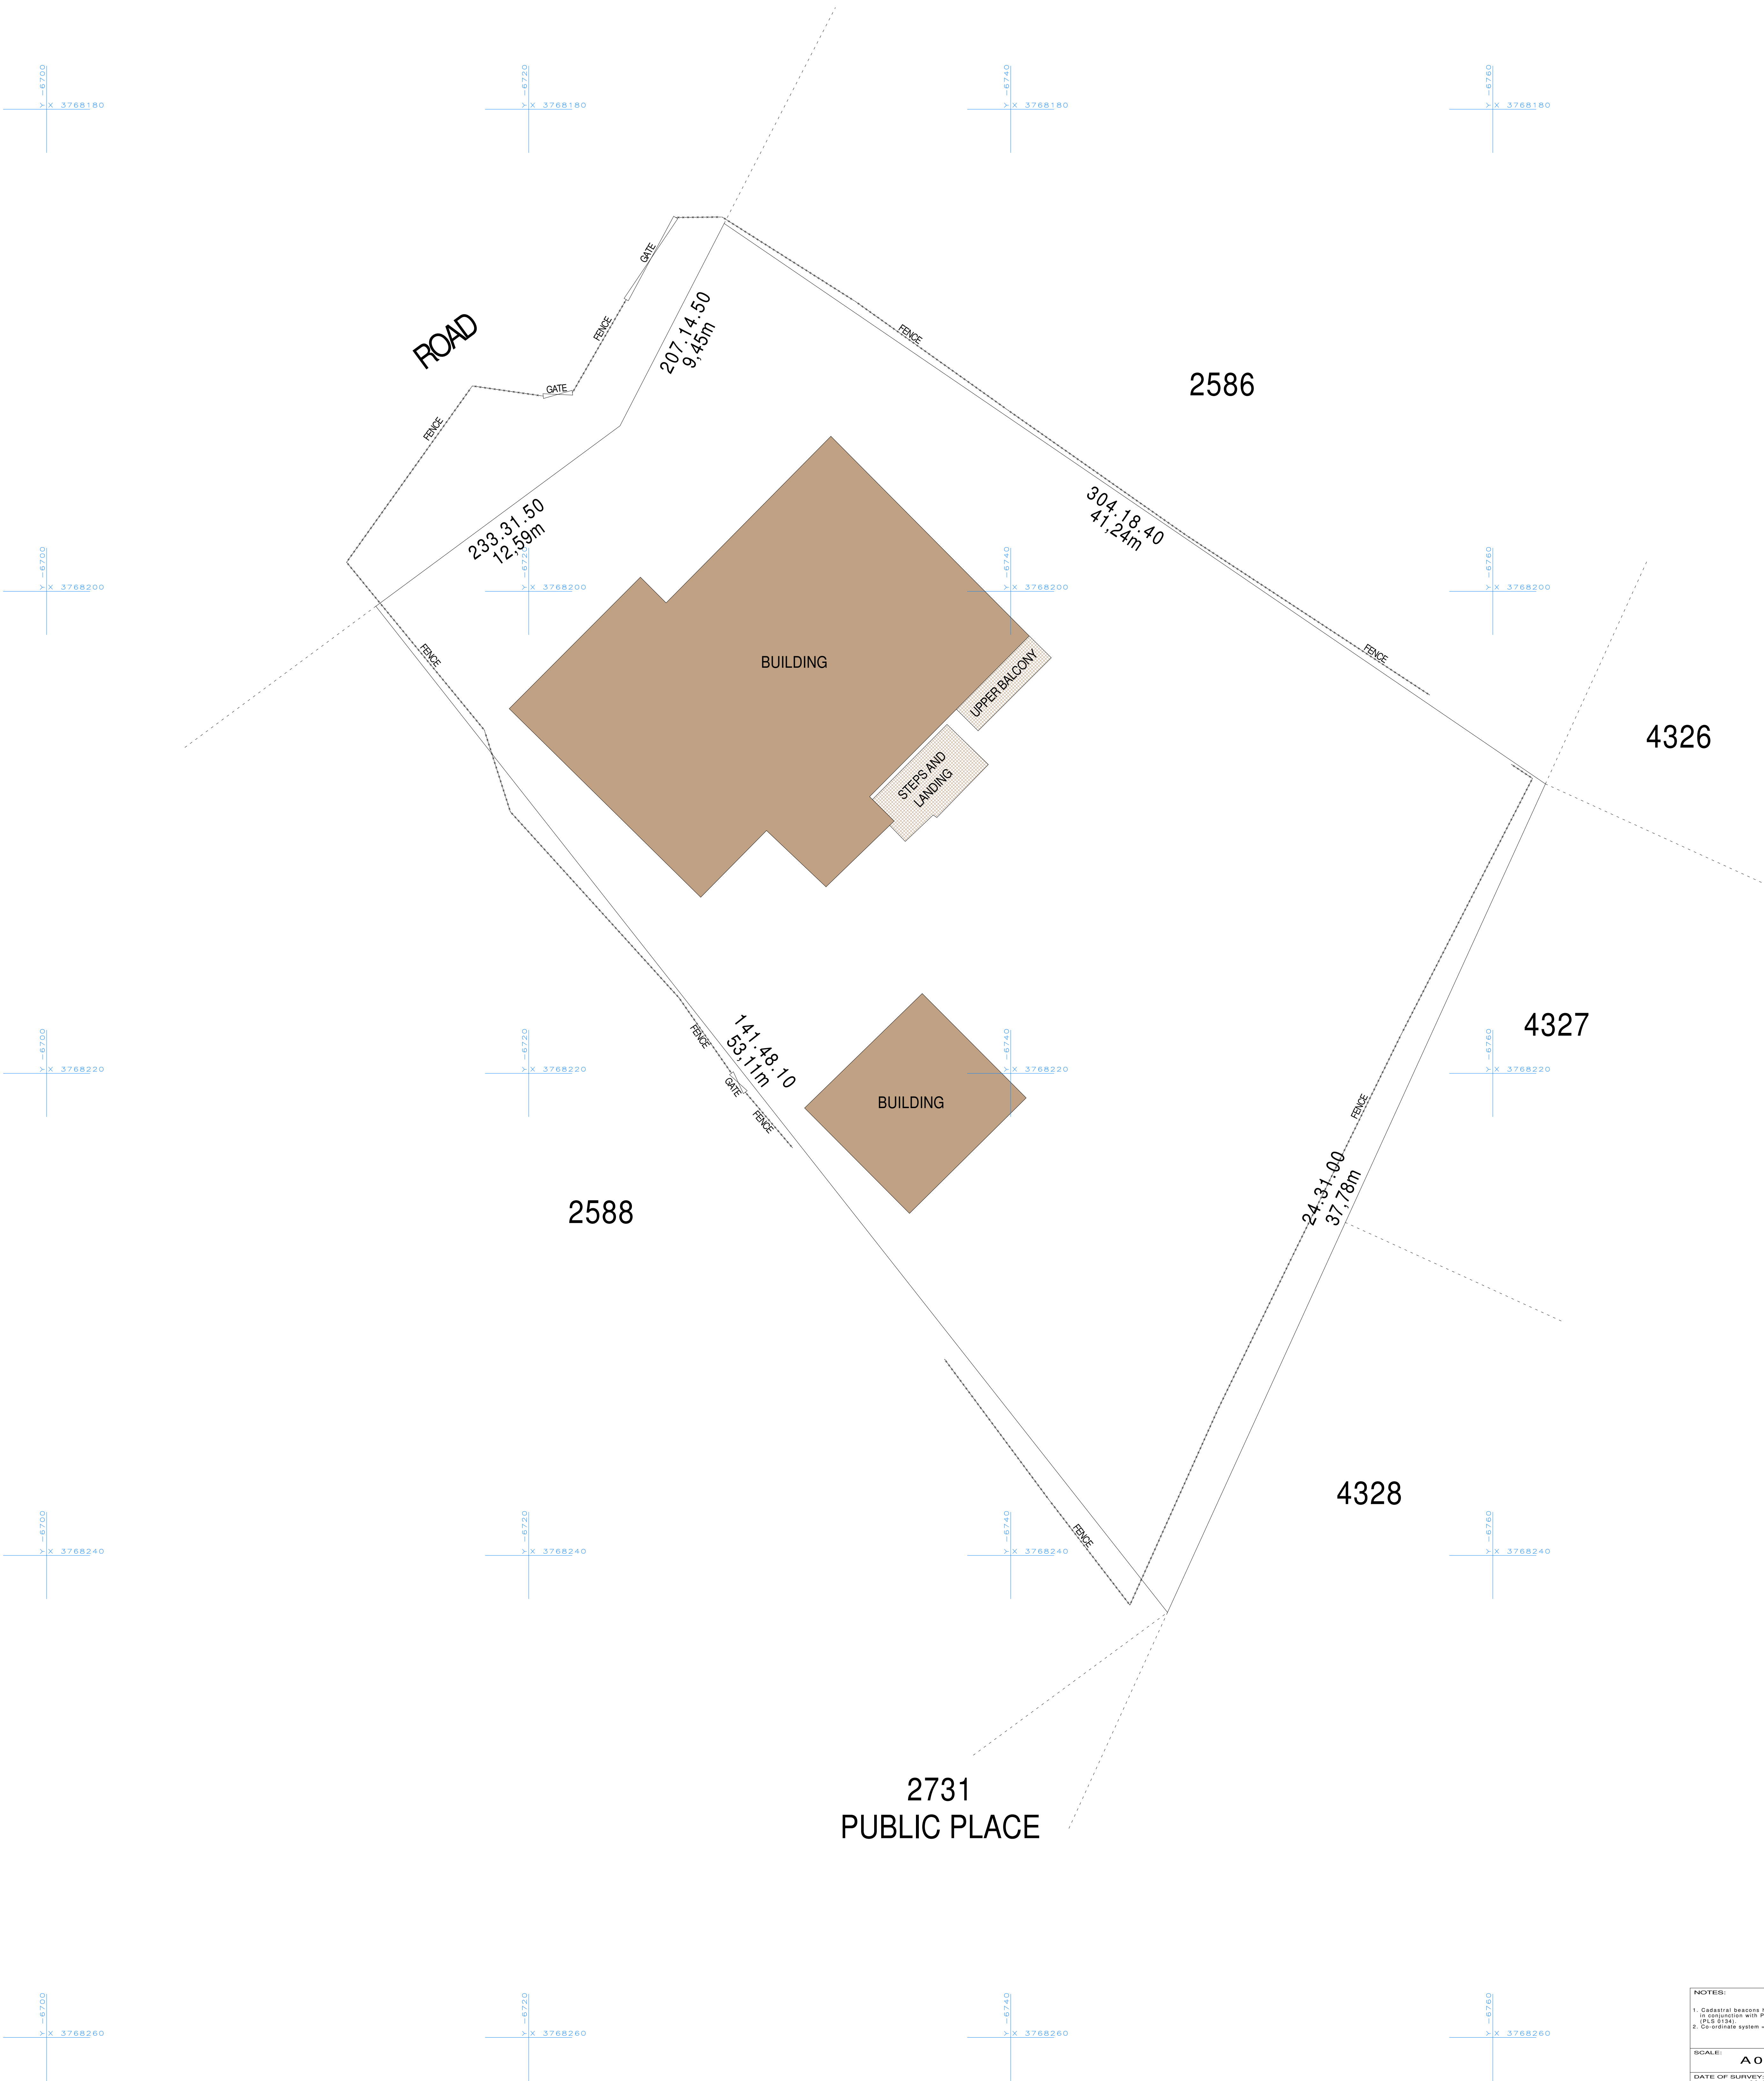

NOTES:	
1. Cadastral beacons have been verified in the field by survey in cooperation with Professional Land Surveyor M de Bruyn (PLS 01341).	
2. Co-ordinate system = L203	
SCALE:	A0 / 1:100
DATE OF SURVEY:	JUNE 2025
CLIENT:	FOREST EDGE PRE-PRIMARY SCHOOL
JOB DESCRIPTION:	SITE PLAN
PROPERTY:	ERF 2587 KNYSNA [OLD PLACE]
DRAWING NO:	K2587SP
EDEN GEOMATICS	
Topographical & Engineering Surveyors	
P.O. Box 346 Koyana 6570	
Andre Senade 072 993 8665	
andre@edengeomatics.co.za	
Nick Foster 071 821 2409	
nick@edengeomatics.co.za	