
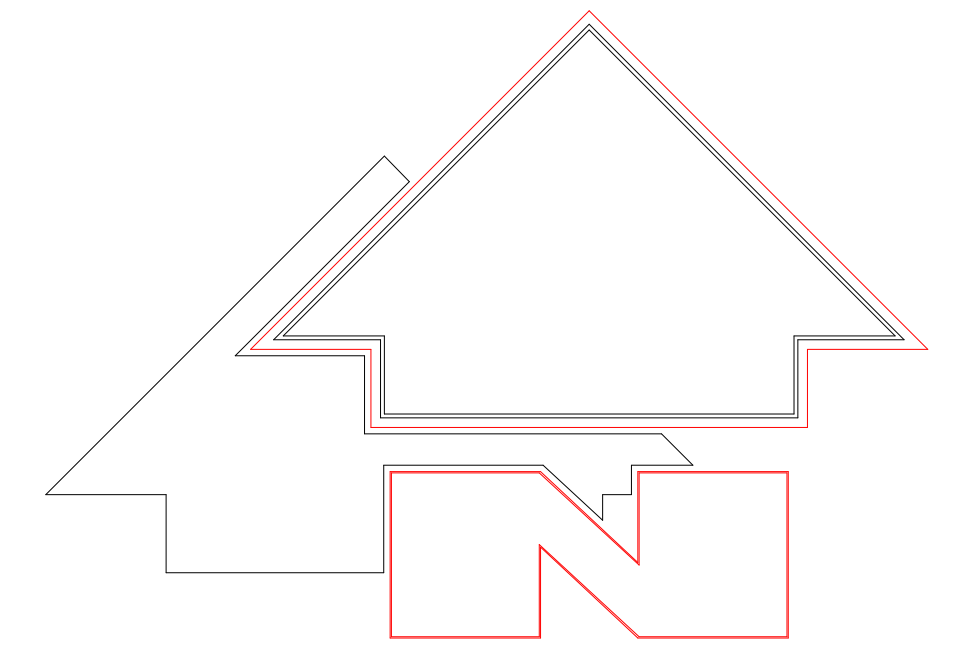


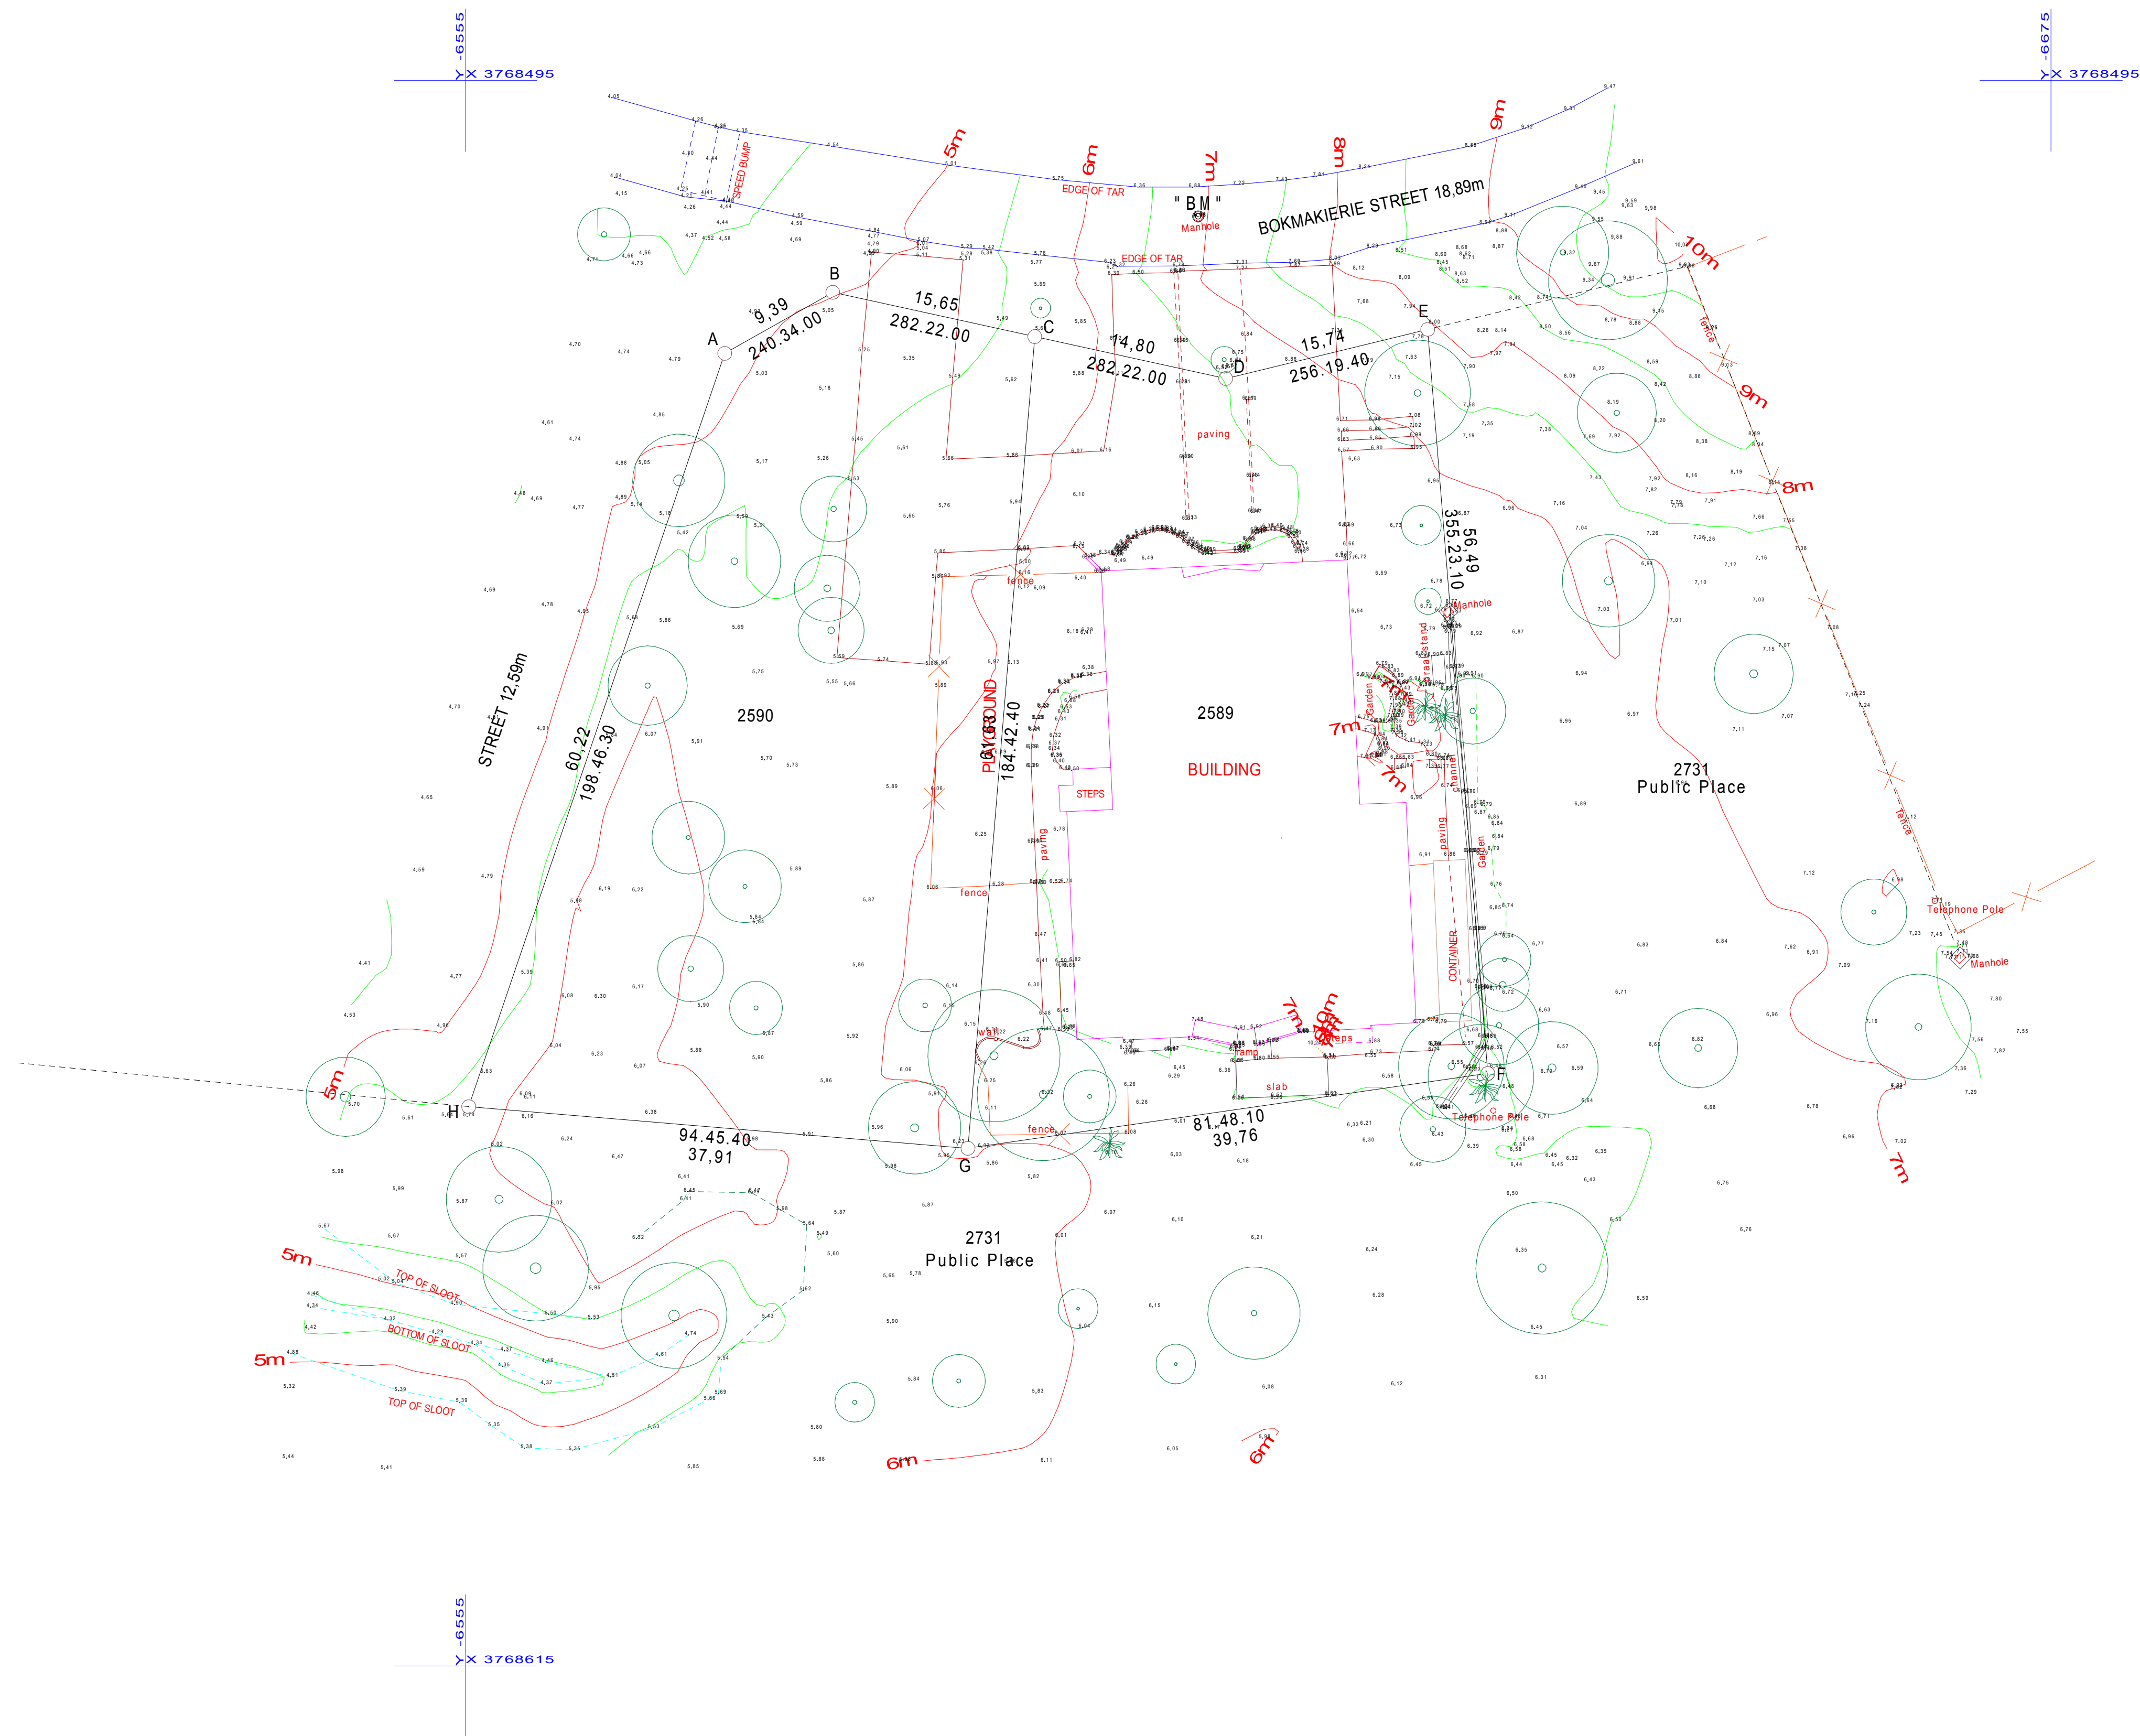


WG23
Scale 1:300, A1

- Notes :
1. Beacons verified as per GP 8467/1955
(see Beacon Certificate)
 2. Bench Mark = "BM" = Centre of Round Manhole Cover
HEIGHT = 6,92m above approximate Mean Sea Level
 3. Beacon Descriptions
ALL BEACONS.....12mm Iron Pegs

This Plan may not be copied
or amended without the written
consent of VPM Surveys.

© 2016 VPM Surveys all rights Reserved

C		
B		
A		
NO	DATE	DESCRIPTION
REVISIONS		
DATE: 17/03/22		SCALE: 1:300
SURVEYED ON: 10-11/03/22		SURVEYOR: W.BANTON (PLST0758)
DRAWING FILE: SERVER://ALLYDATA4/KNYSNA/K1-10000/K2589 AND 2590CP		

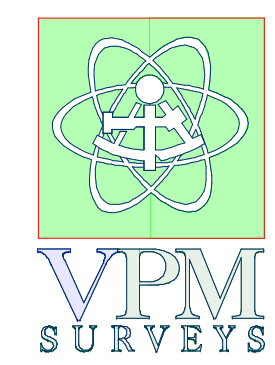

Professional Land Surveyors
Township Planners,
GIS & GPS consultants
Topographic, Sectional Title
& Engineering Surveys
16 Green Street P.O.Box 173
Knysna 6570
Tel: 044 3022300 Fax: 0866898908
e-mail: info@vpmsa.co.za

CLIENT

Knysna Vineyard Church

PROJECT

Contour / Site Plan

TITLE

ERF 2589-2590
Lower Old Place
KNYSNA

DRG NO
K2589-2590CP

REV
A