LAND SURVEYOR'S CERTIFICATE

ERF 5008 Sedgefield

(data from Diagram 2395/2018)

name	Y	X	Ht
A	20369.03	64803.91	3.03
B	20310.91	64790.46	3.18
C	20310.89	64815.92	3.21
D	20299.42	64816.07	3.31
E	20299.39	64847.04	3.39
F	20237.14	64846.99	3.02
G	20236.29	64850.27	3.12
H	20217.56	64850.21	3.48
J	20210.25	64879.54	3.17
K	20391.54	64923.55	3.30
L	20398.54	64894.79	3.13

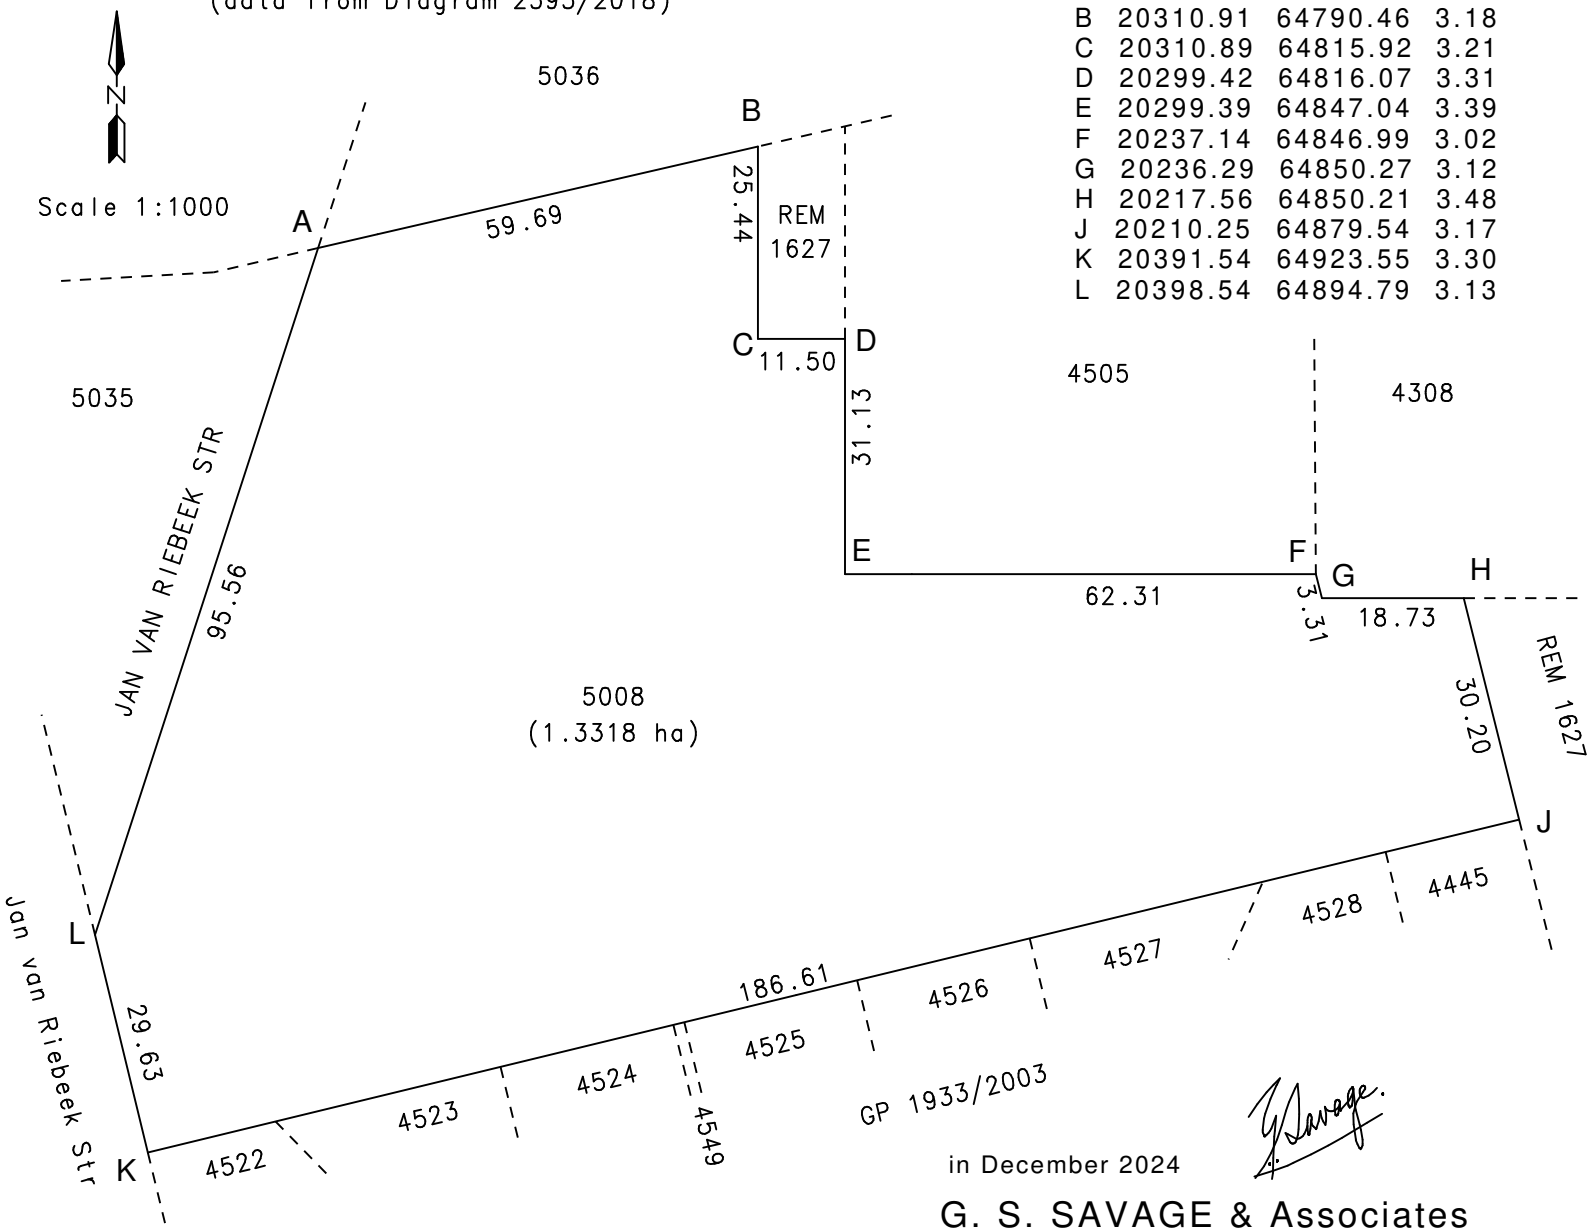

in December 2024

G. S. SAVAGE & Associates

PROFESSIONAL LAND SURVEYOR

46 ALBERT STREET, P O BOX 752, GEORGE 6530

TEL: (044) 874 2414 Cell: 083 454 1350

CF: 681/EL

Ref: 4839SEDGE ht plan erf 5008