


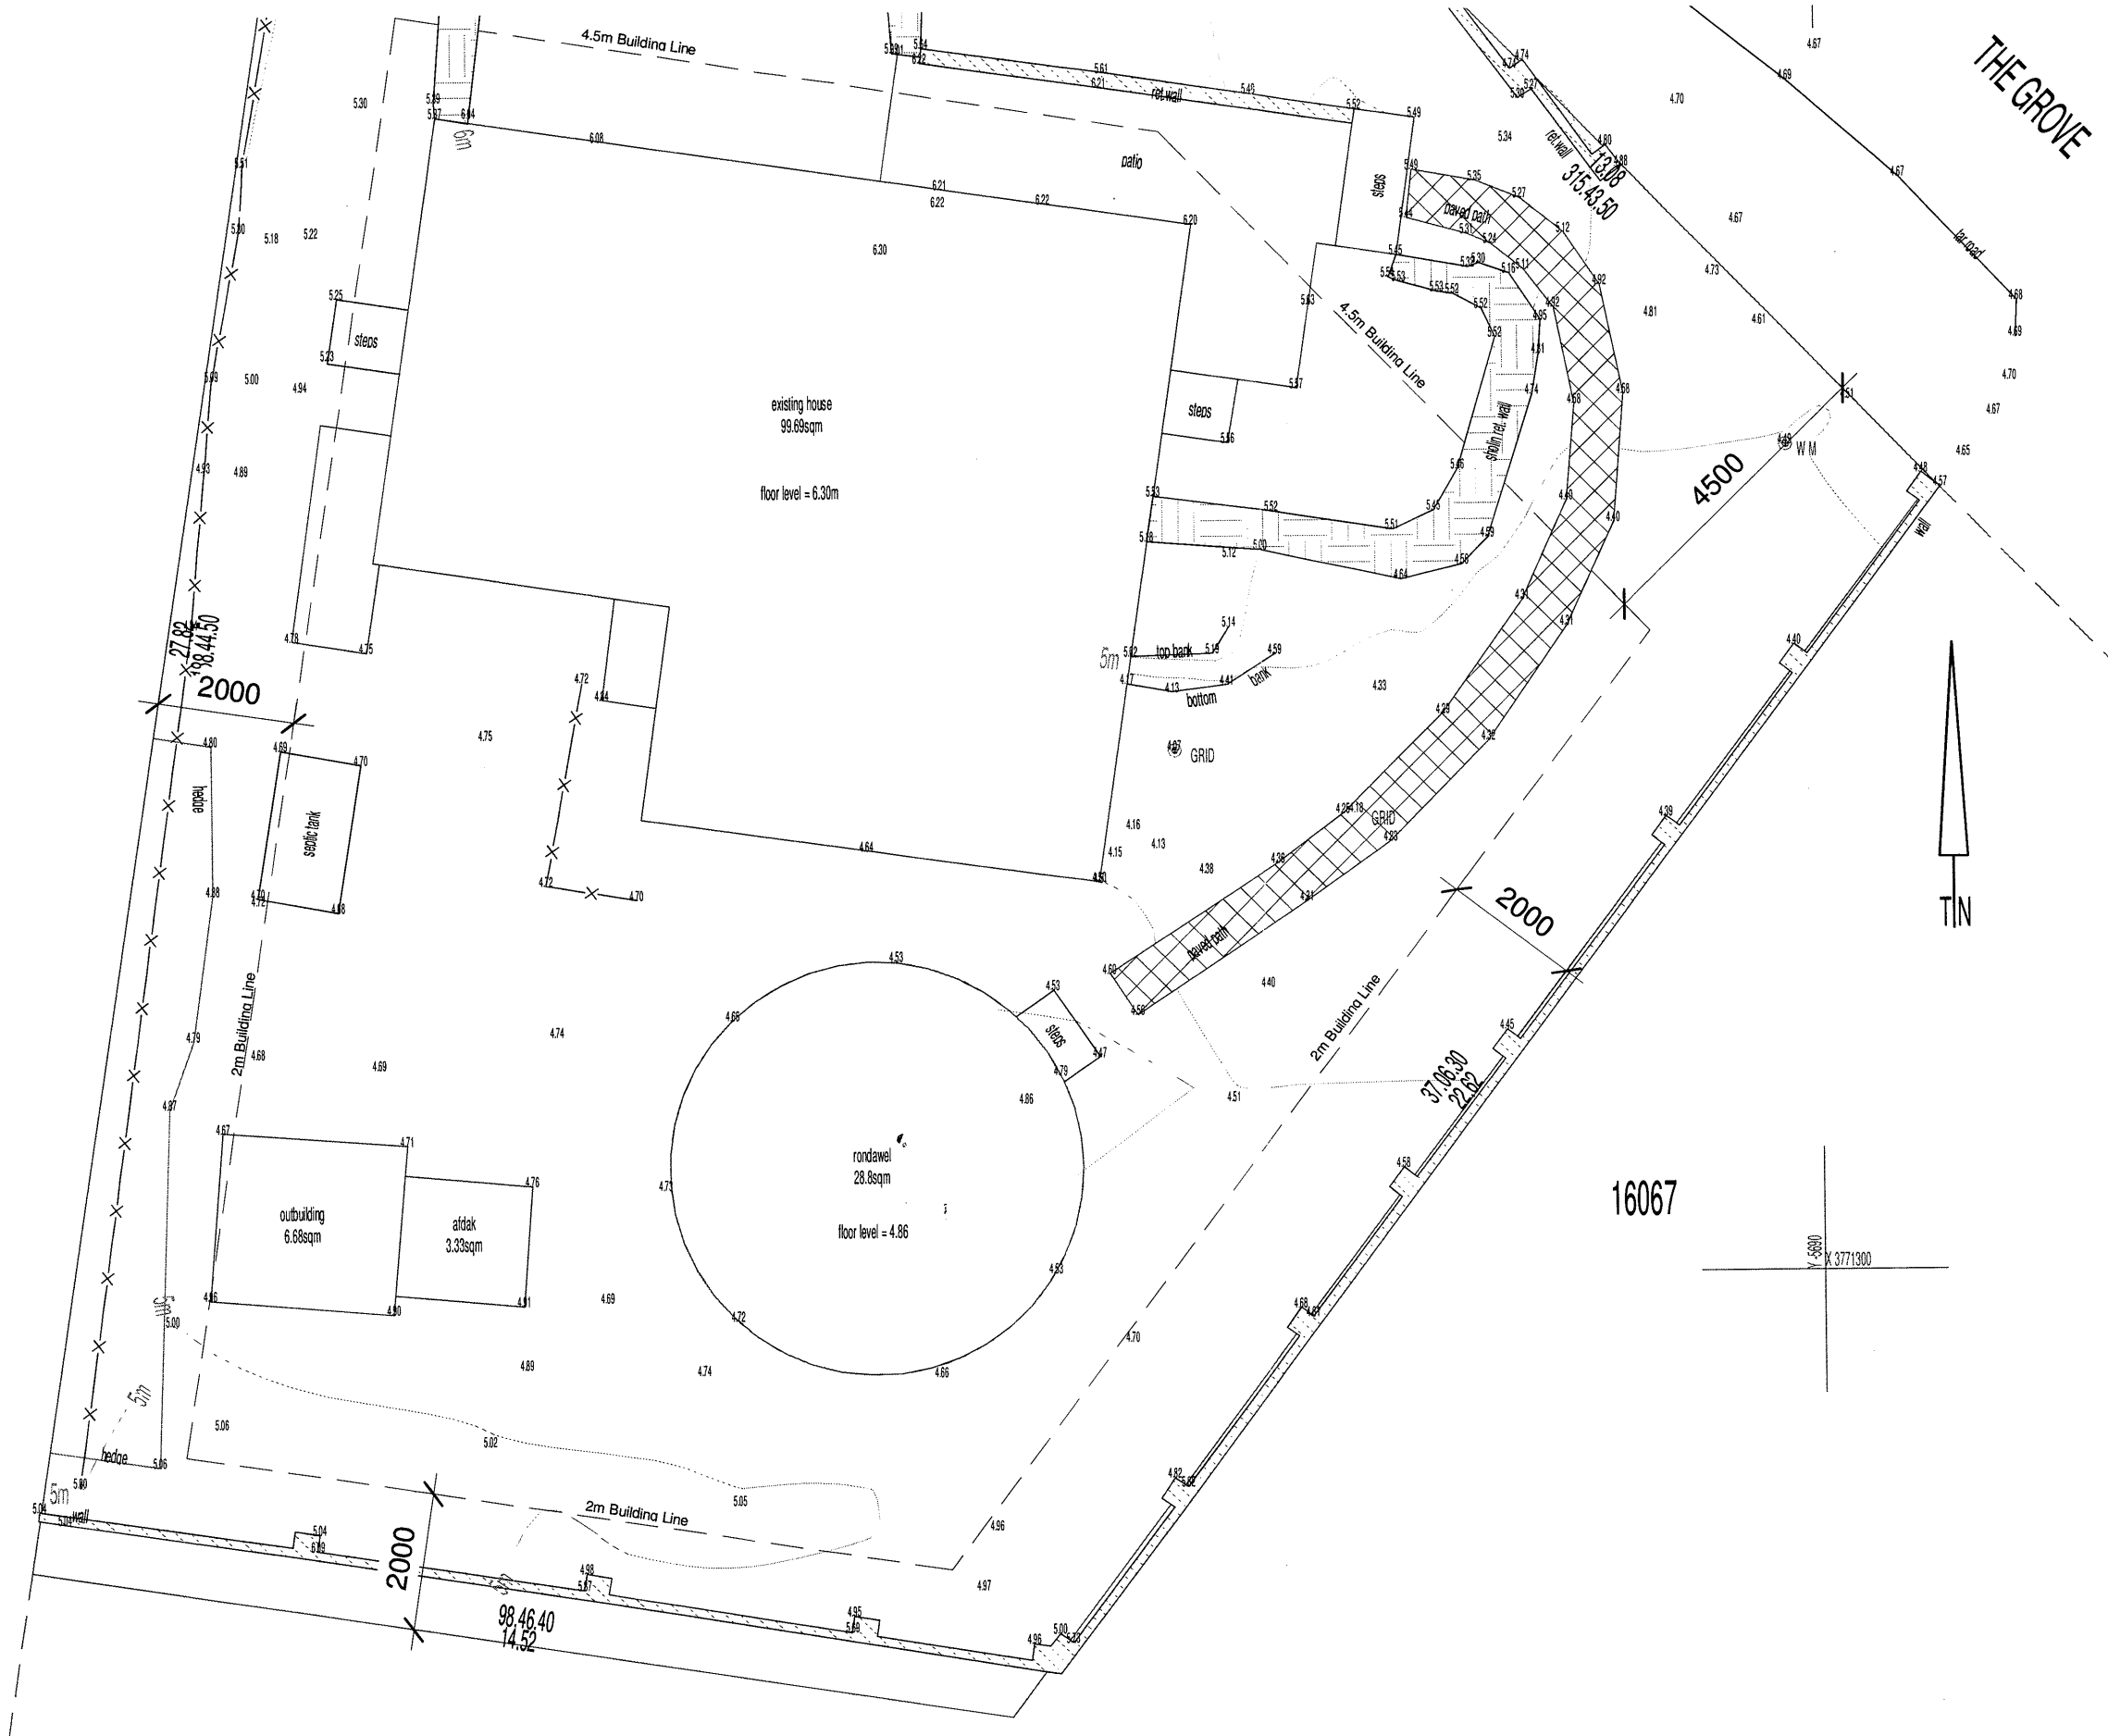

Areas:

Erf	554.0sqm
Existing Builings	138.5sqm
Coverage	25%
Allowed Coverage	35%

Project

Additions

FOR

Mr. Vogel

in

Erf 2854
Leisure Isle
Knysna

Sheet Name: Site Layout

Project number 2018/01

Date 23/10/2018

Drawn by Author

Checked by Checker

2018/01- P100.1-

Scale 1 : 100

1

Site Layout

1 : 100