



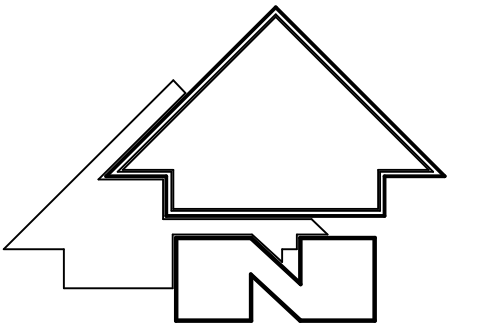

SCALE 1:100
Lo.23

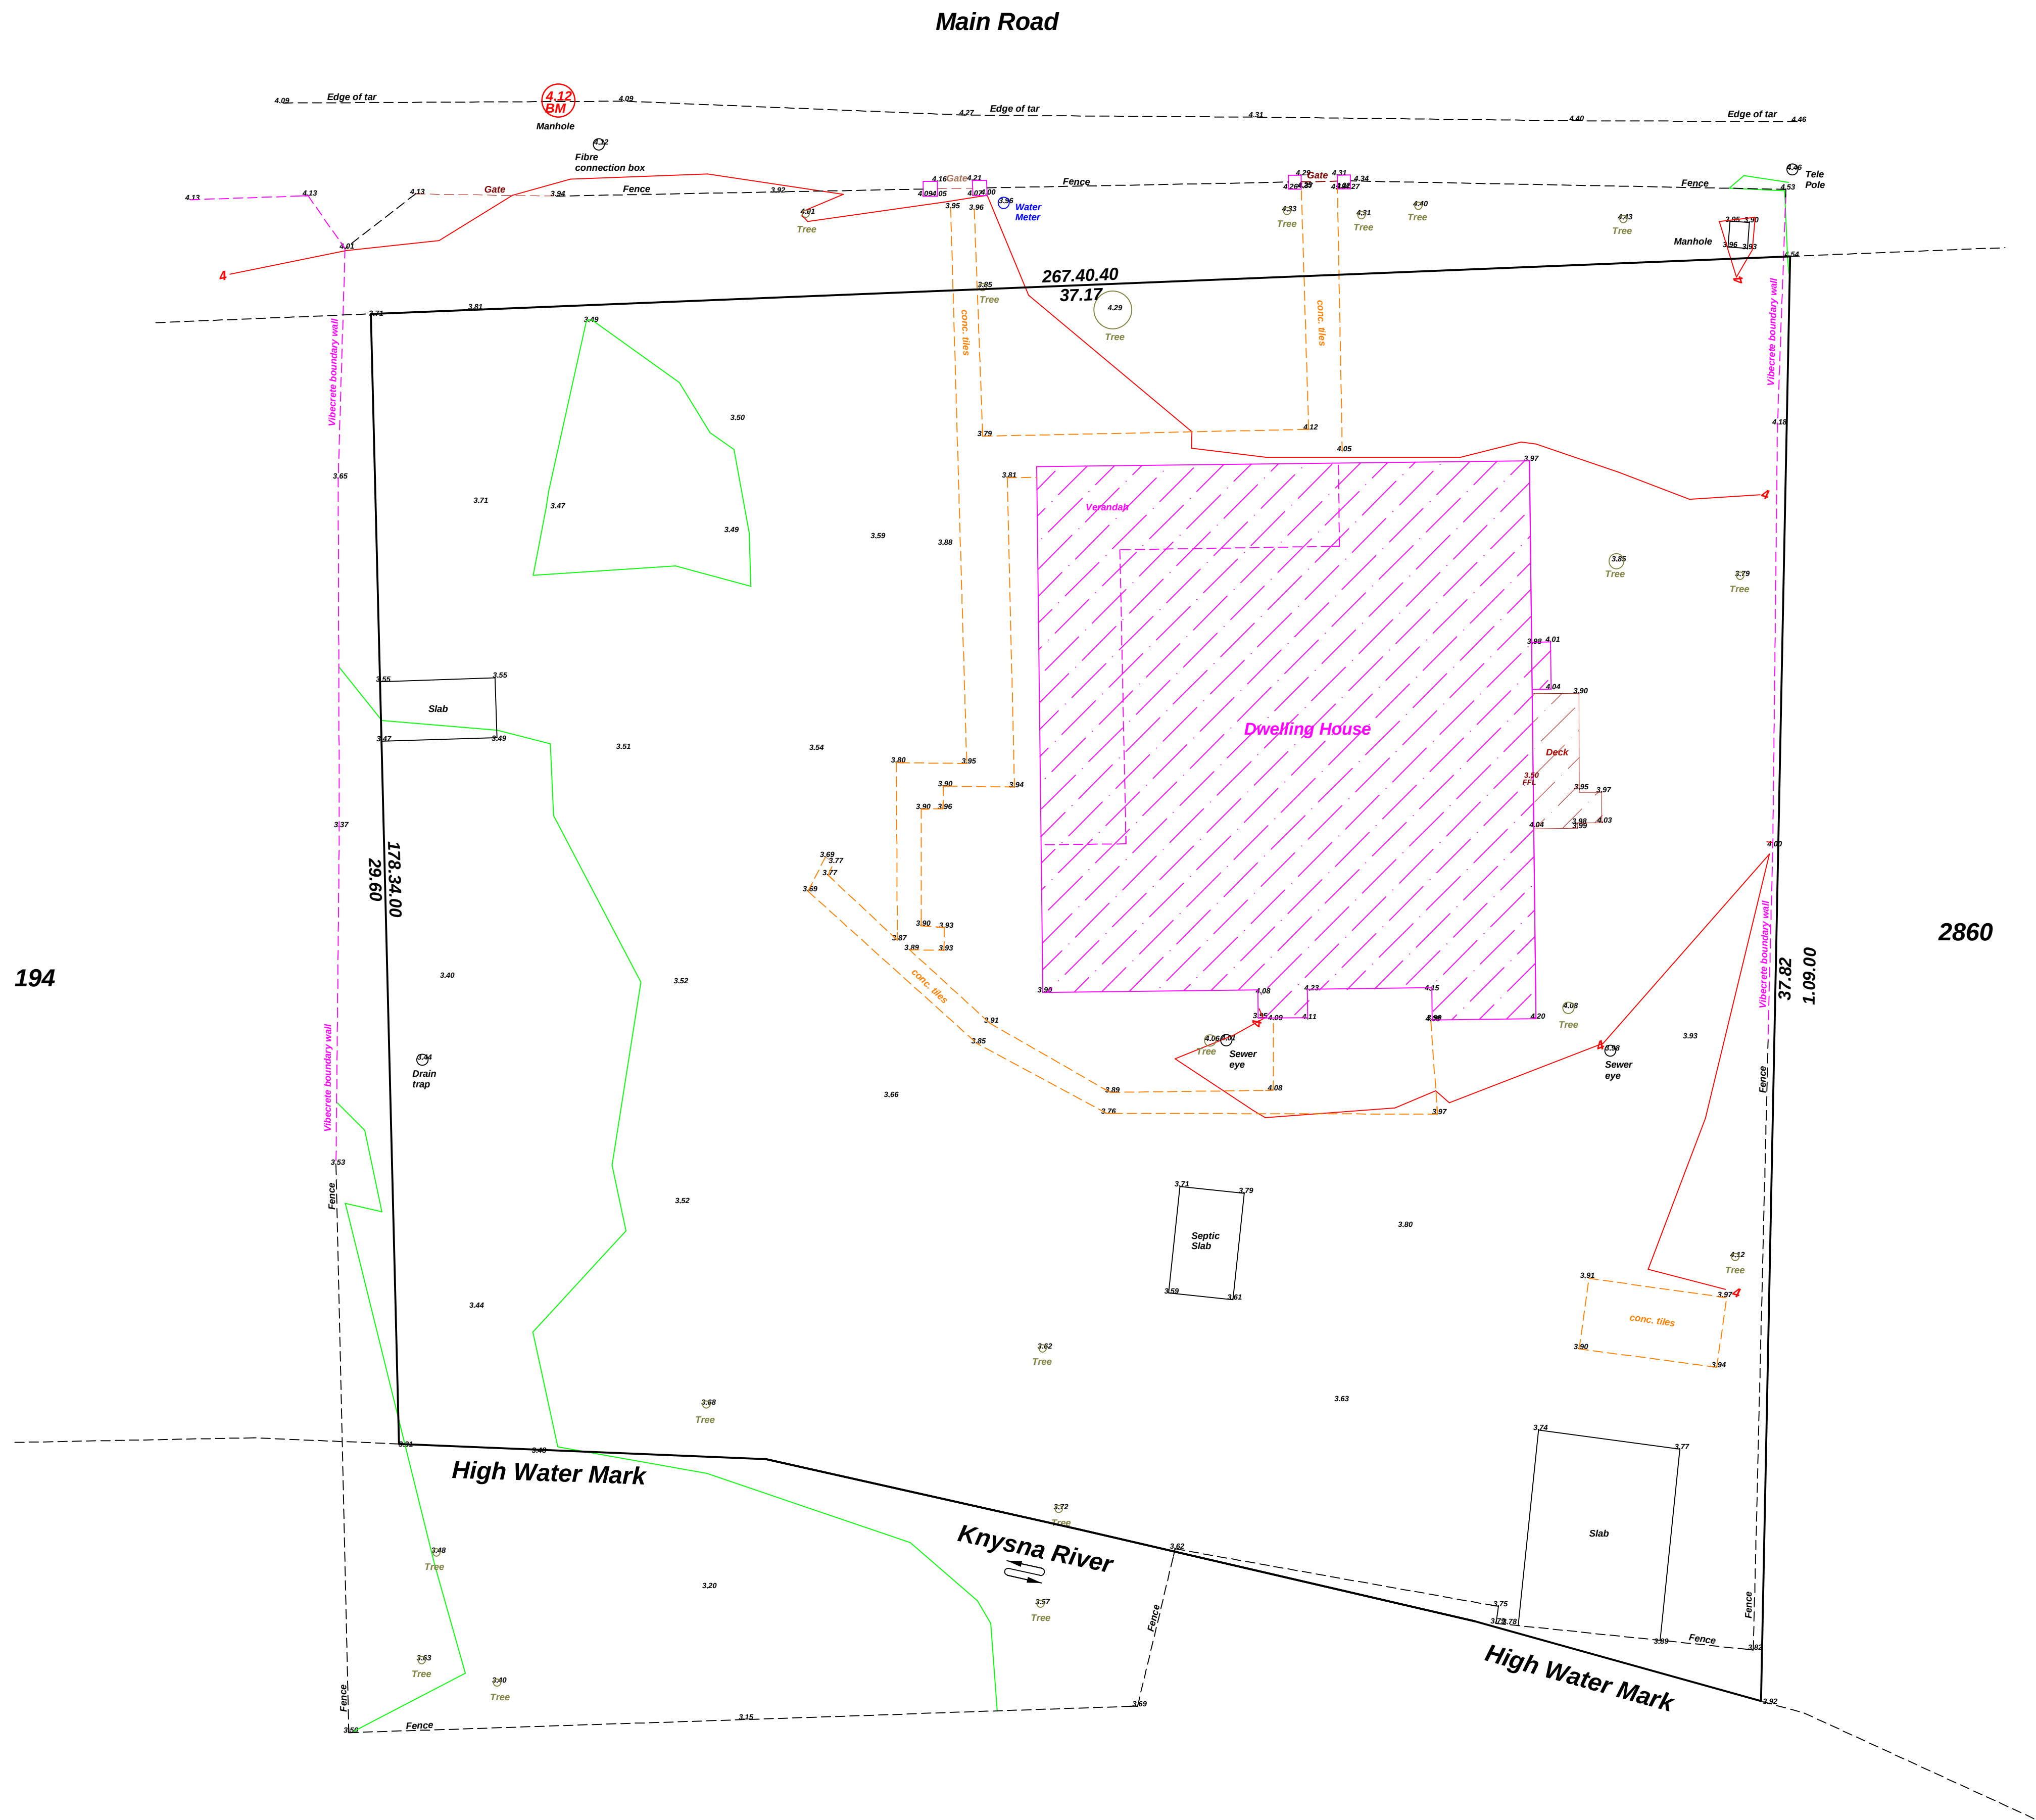

NOTES :
1) HEIGHTS ARE ABOVE AN ARBITRARY DATUM.
2) BENCHMARK "BM" = CENTRE OF MANHOLE COVER
HEIGHT = 4,12M.

C		
B		
A		
NO		DESCRIPTION
REVISIONS		
DATE	August 2025	SCALE 1:100
SURVEYED	P.G. Trigin	APPROVED
THIS DRAWING STORED IN FILE F:\PLETTENBERG\KNYSNA\KN193DP.DWG		

Beacon Survey
Professional Land Surveyors
and Sectional Title Practitioners
103 Longships Drive P.O.Box 350 Plettenberg Bay
Tel: (044) 533 2230 Fax: (044) 533 0264
e-mail: beaconsurvey@mweb.co.za

CLIENT
NANINI 109 CC

PROJECT
ERF 193 KNYSNA

TITLE
DETAIL PLAN

DRG NO **KN193DP-1** REV