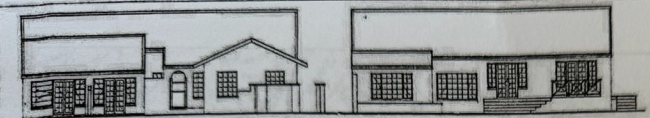

S.W. ELEV. 1:100

N.E. ELEV. 1:100

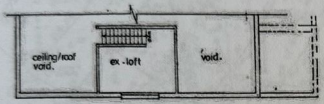

UPPER FLOOR 1:100

N.W. ELEV. 1:100

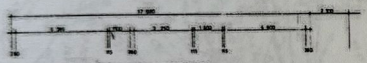

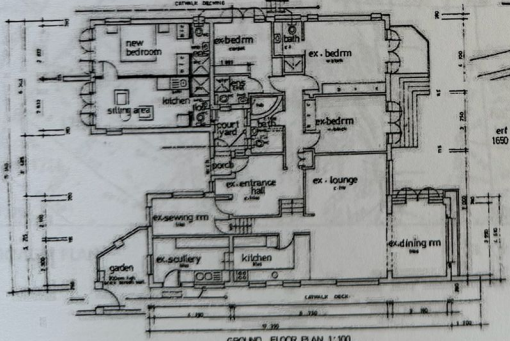

GROUND FLOOR PLAN 1:100

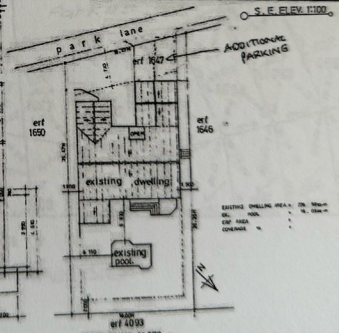

S.E. ELEV. 1:100

SITE PLAN 1:250

ARCH-IMAGES ARTS STUDIO 07

PROF. CONVERSION OF GARAGE TO SECOND DWELLING ON ERF N° 1647 LEISURE ISLE KNYSNA FOR ROLAND & PAULA MUNRO