




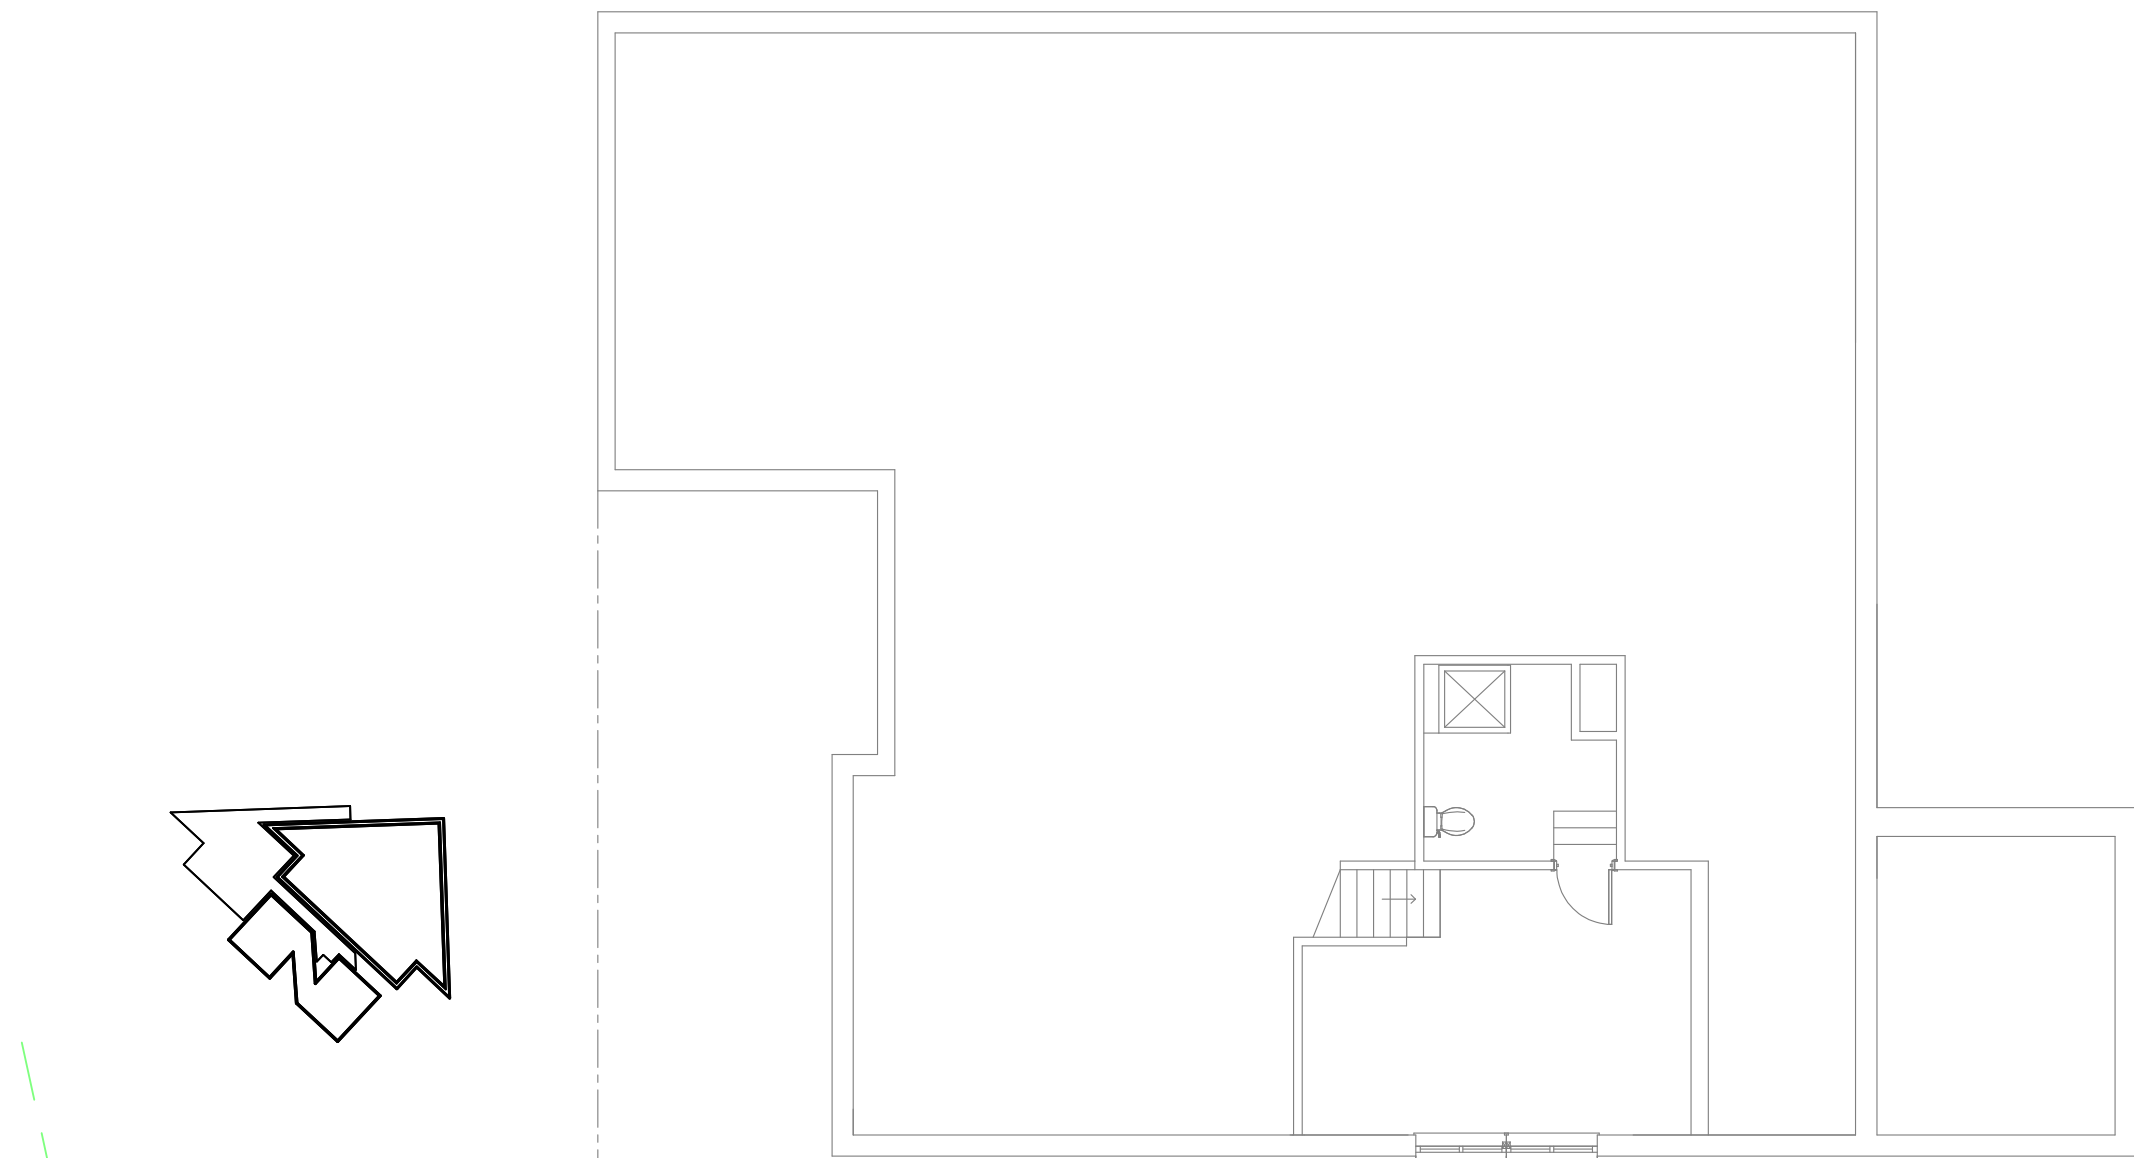

FIRST FLOOR PLAN

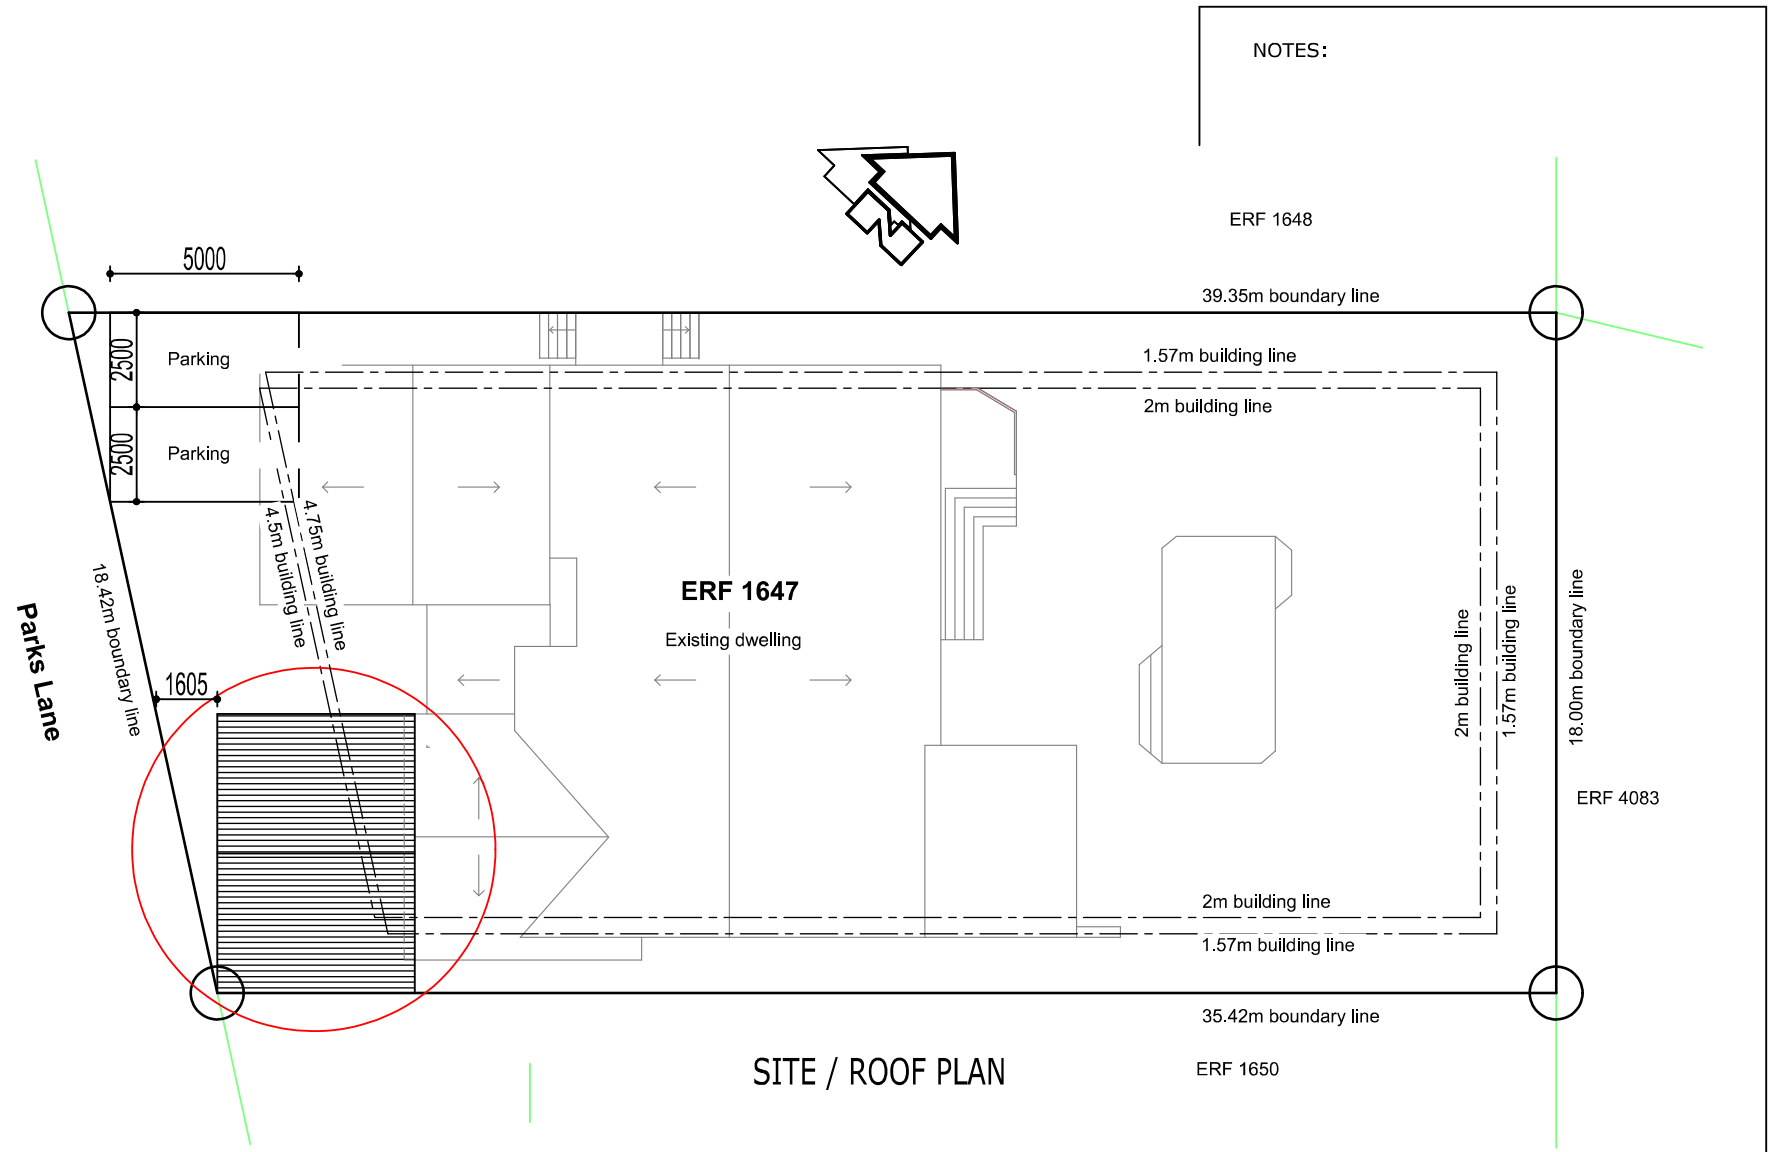

SITE / ROOF PLAN

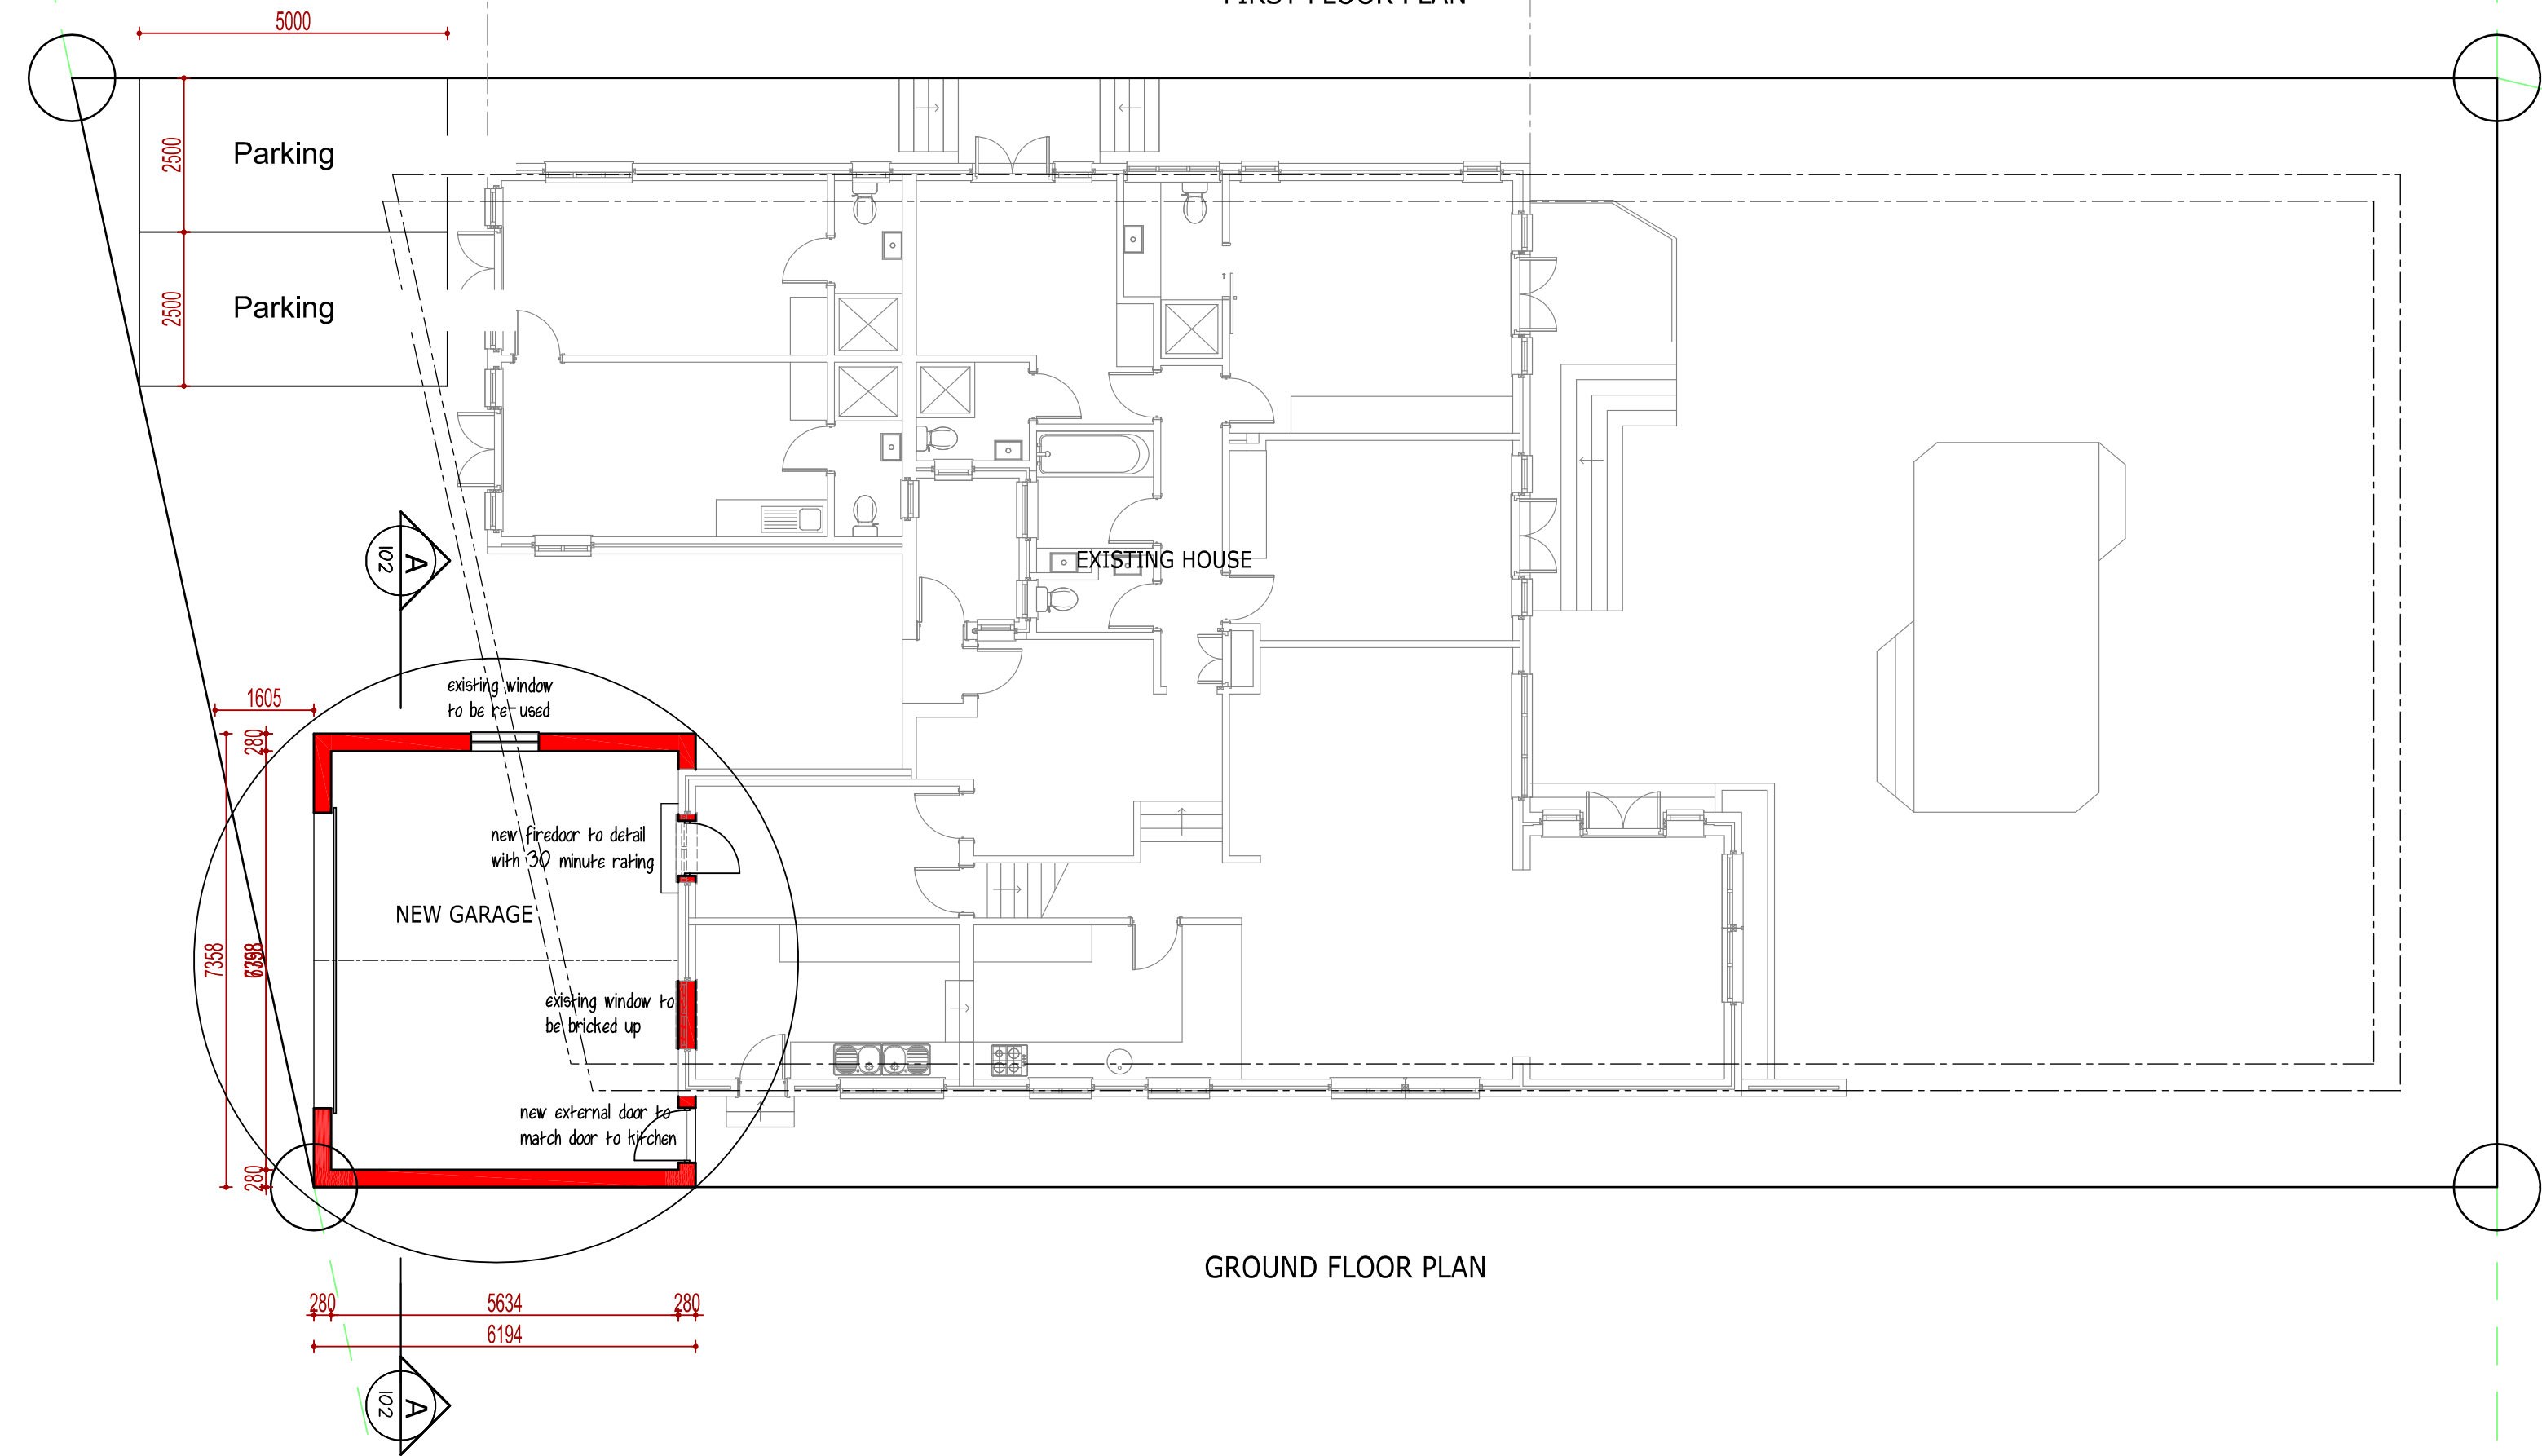

GROUND FLOOR PLAN

	Existing floor area under roof (sq m)	New floor area under roof (sq m)	Total floor area under roof (sq m)	Coverage Actual vs. Permissible areas (sq m)	Area of site (sq m)
Loft	27	-	27	Permissible = 337 (50% of site area)	674
Ground Floor	243	44	287	287	
Totals	270	39	314	Actual = 287 (43% of site area)	


Frankenfeld & King
ARCHITECTS

The Art Centre Montagu St PO Box 3472 Knysna 6570
tel/fax: 044 382 7905 cell: 082 338 9210
email: andrew@fkarchitects.co.za

HOUSE MUNRO
ERF 1647 LEISURE ISLE
KNYSNA

PROJECT No.: 2628 REVISION
DWG No.: 101
SCALE: 1: 200 1:100
DATE: MAY 2026

This drawing and design is copyright and must not be reproduced in part or in whole without prior written consent. Contractors must verify all dimensions on site before commencing work or preparing shop drawings.

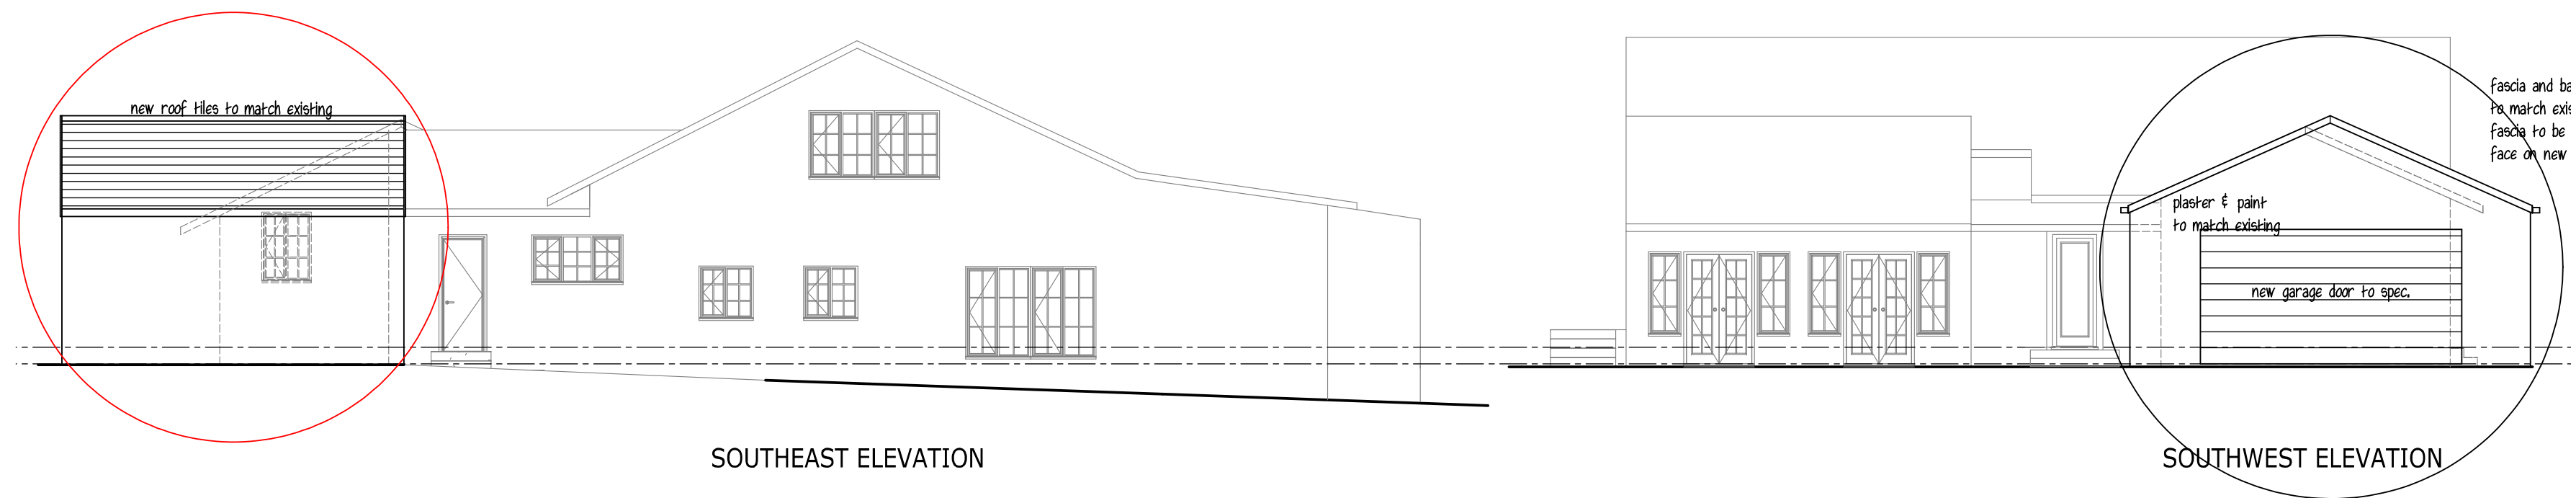

NOTES:



Frankenfeld & King
ARCHITECTS

The Art Centre Montagu St. PO Box 3472 Knysna 6570
tel/fax: 044 382 7905 cell: 082 338 9210
email: andrew@fkarchitects.co.za

HOUSE MUNRO

ERF 1647 LEISURE ISLE

KNYSNA

PROJECT No.: 2628

REVISION

DWG No.: 102

SCALE: 1:100

DATE: MAY 2026

This drawing and design is copyright and must not be reproduced in part or in whole without prior written consent. Contractors must verify all dimensions on site before commencing work or preparing shop drawings.