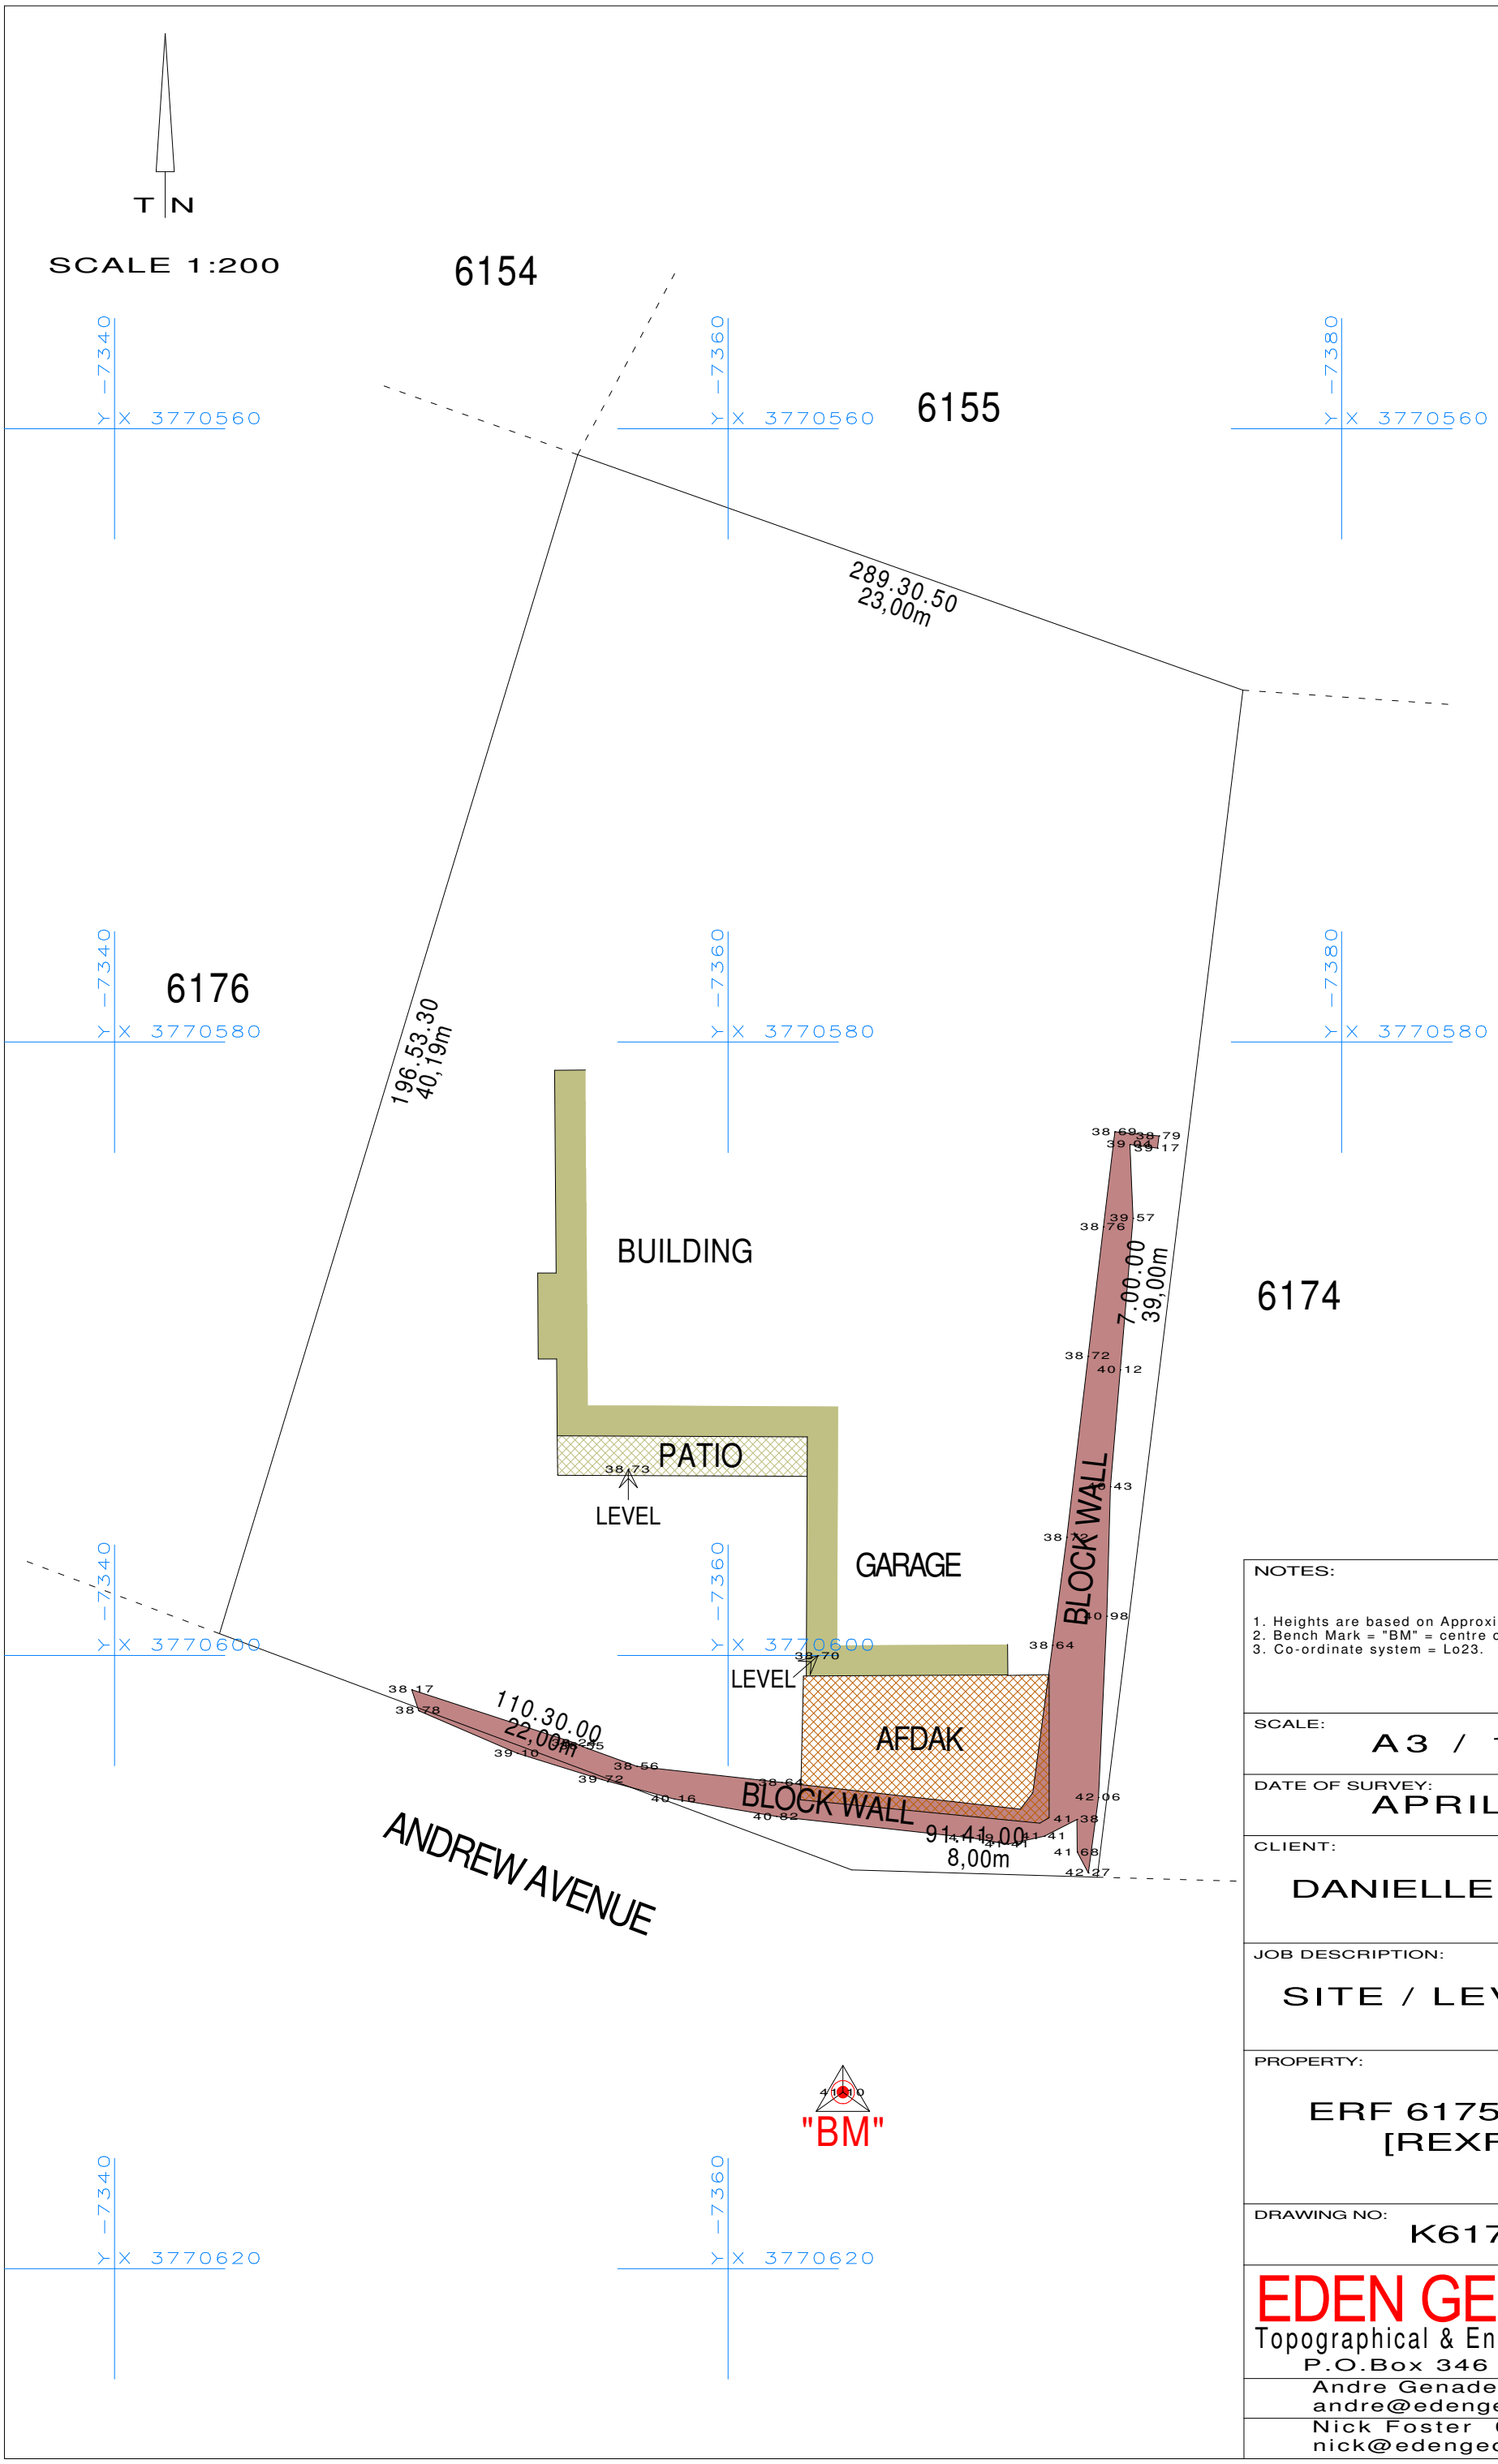

NOTES:

1. Heights are based on Approximate Mean Sea Level.
2. Bench Mark = "BM" = centre of manhole cover = 41,10m.
3. Co-ordinate system = Lo23.

SCALE:
A3 / 1:200

DATE OF SURVEY:
APRIL 2026

CLIENT:
DANIELLE POULTER

JOB DESCRIPTION:
SITE / LEVEL PLAN

PROPERTY:
ERF 6175 KNYSNA
[REXFORD]

DRAWING NO:
K6175SP

EDEN GEOMATICS
Topographical & Engineering Surveyors
P.O.Box 346 Knysna 6570
Andre Genade 072 993 8665
andre@edengeomatics.co.za
Nick Foster 071 621 2409
nick@edengeomatics.co.za