



Professional Land Surveyors

Township Planners, GIS & GPS Consultants
Topographic, Sectional Title & Engineering Surveys

16 Green Street P.o. Box 173 Knysna 6570
Tel: (044) 302 2300/ 382 7161 Fax: (086) 689 8908
E-mail: info@vpmsa.co.za

6 June 2024

BEACON CERTIFICATE

Erf 412 Brenton


I, M. Bantom, Professional Land Surveyor, hereby certify that Erf 412 Brenton has this day been inspected under my personal supervision, in extent 958 square metres, situate in the Municipality and Administrative District of Knysna, Province of the Western Cape and that the beacons found conform to the data recorded on General Plan No. TP.7122 as illustrated in the sketch below.

.....
Professional Land Surveyor PLS 1559

I, here by certify that the beacons of Erf 412 Brenton, has been indicated to me, as illustrated in the sketch hereunder.

.....
Owner or Representative

.....
Date

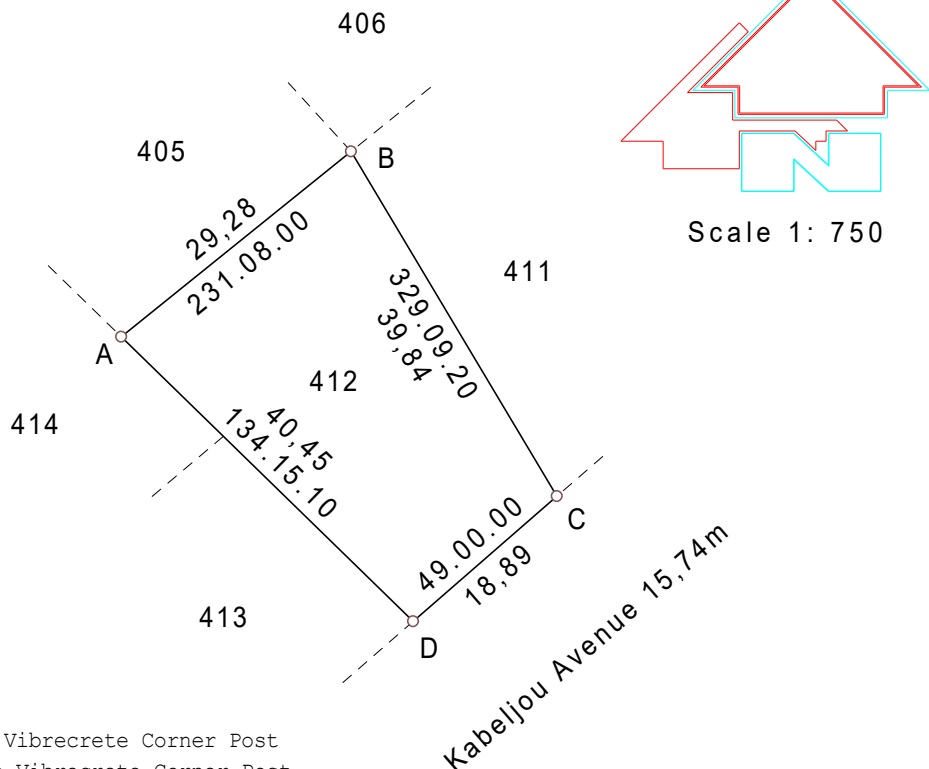



Beacon Descriptions:

A,B : Drill Hole on top of Vibrecrete Corner Post
C,D : 12mm Iron Peg Next to Vibrecrete Corner Post

VPM SURVEYS

Partner: RJ Kohler B.Sc(Land Sur)Pr.L(SA)

Assisted by: CJ Kohler B.Sc(Geomatics)Pr.L(SA) , N Kyriacos B.Sc(Geomatics)Pr.L(SA),
M Bantom B.Sc(Geomatics)Pr.L(SA)

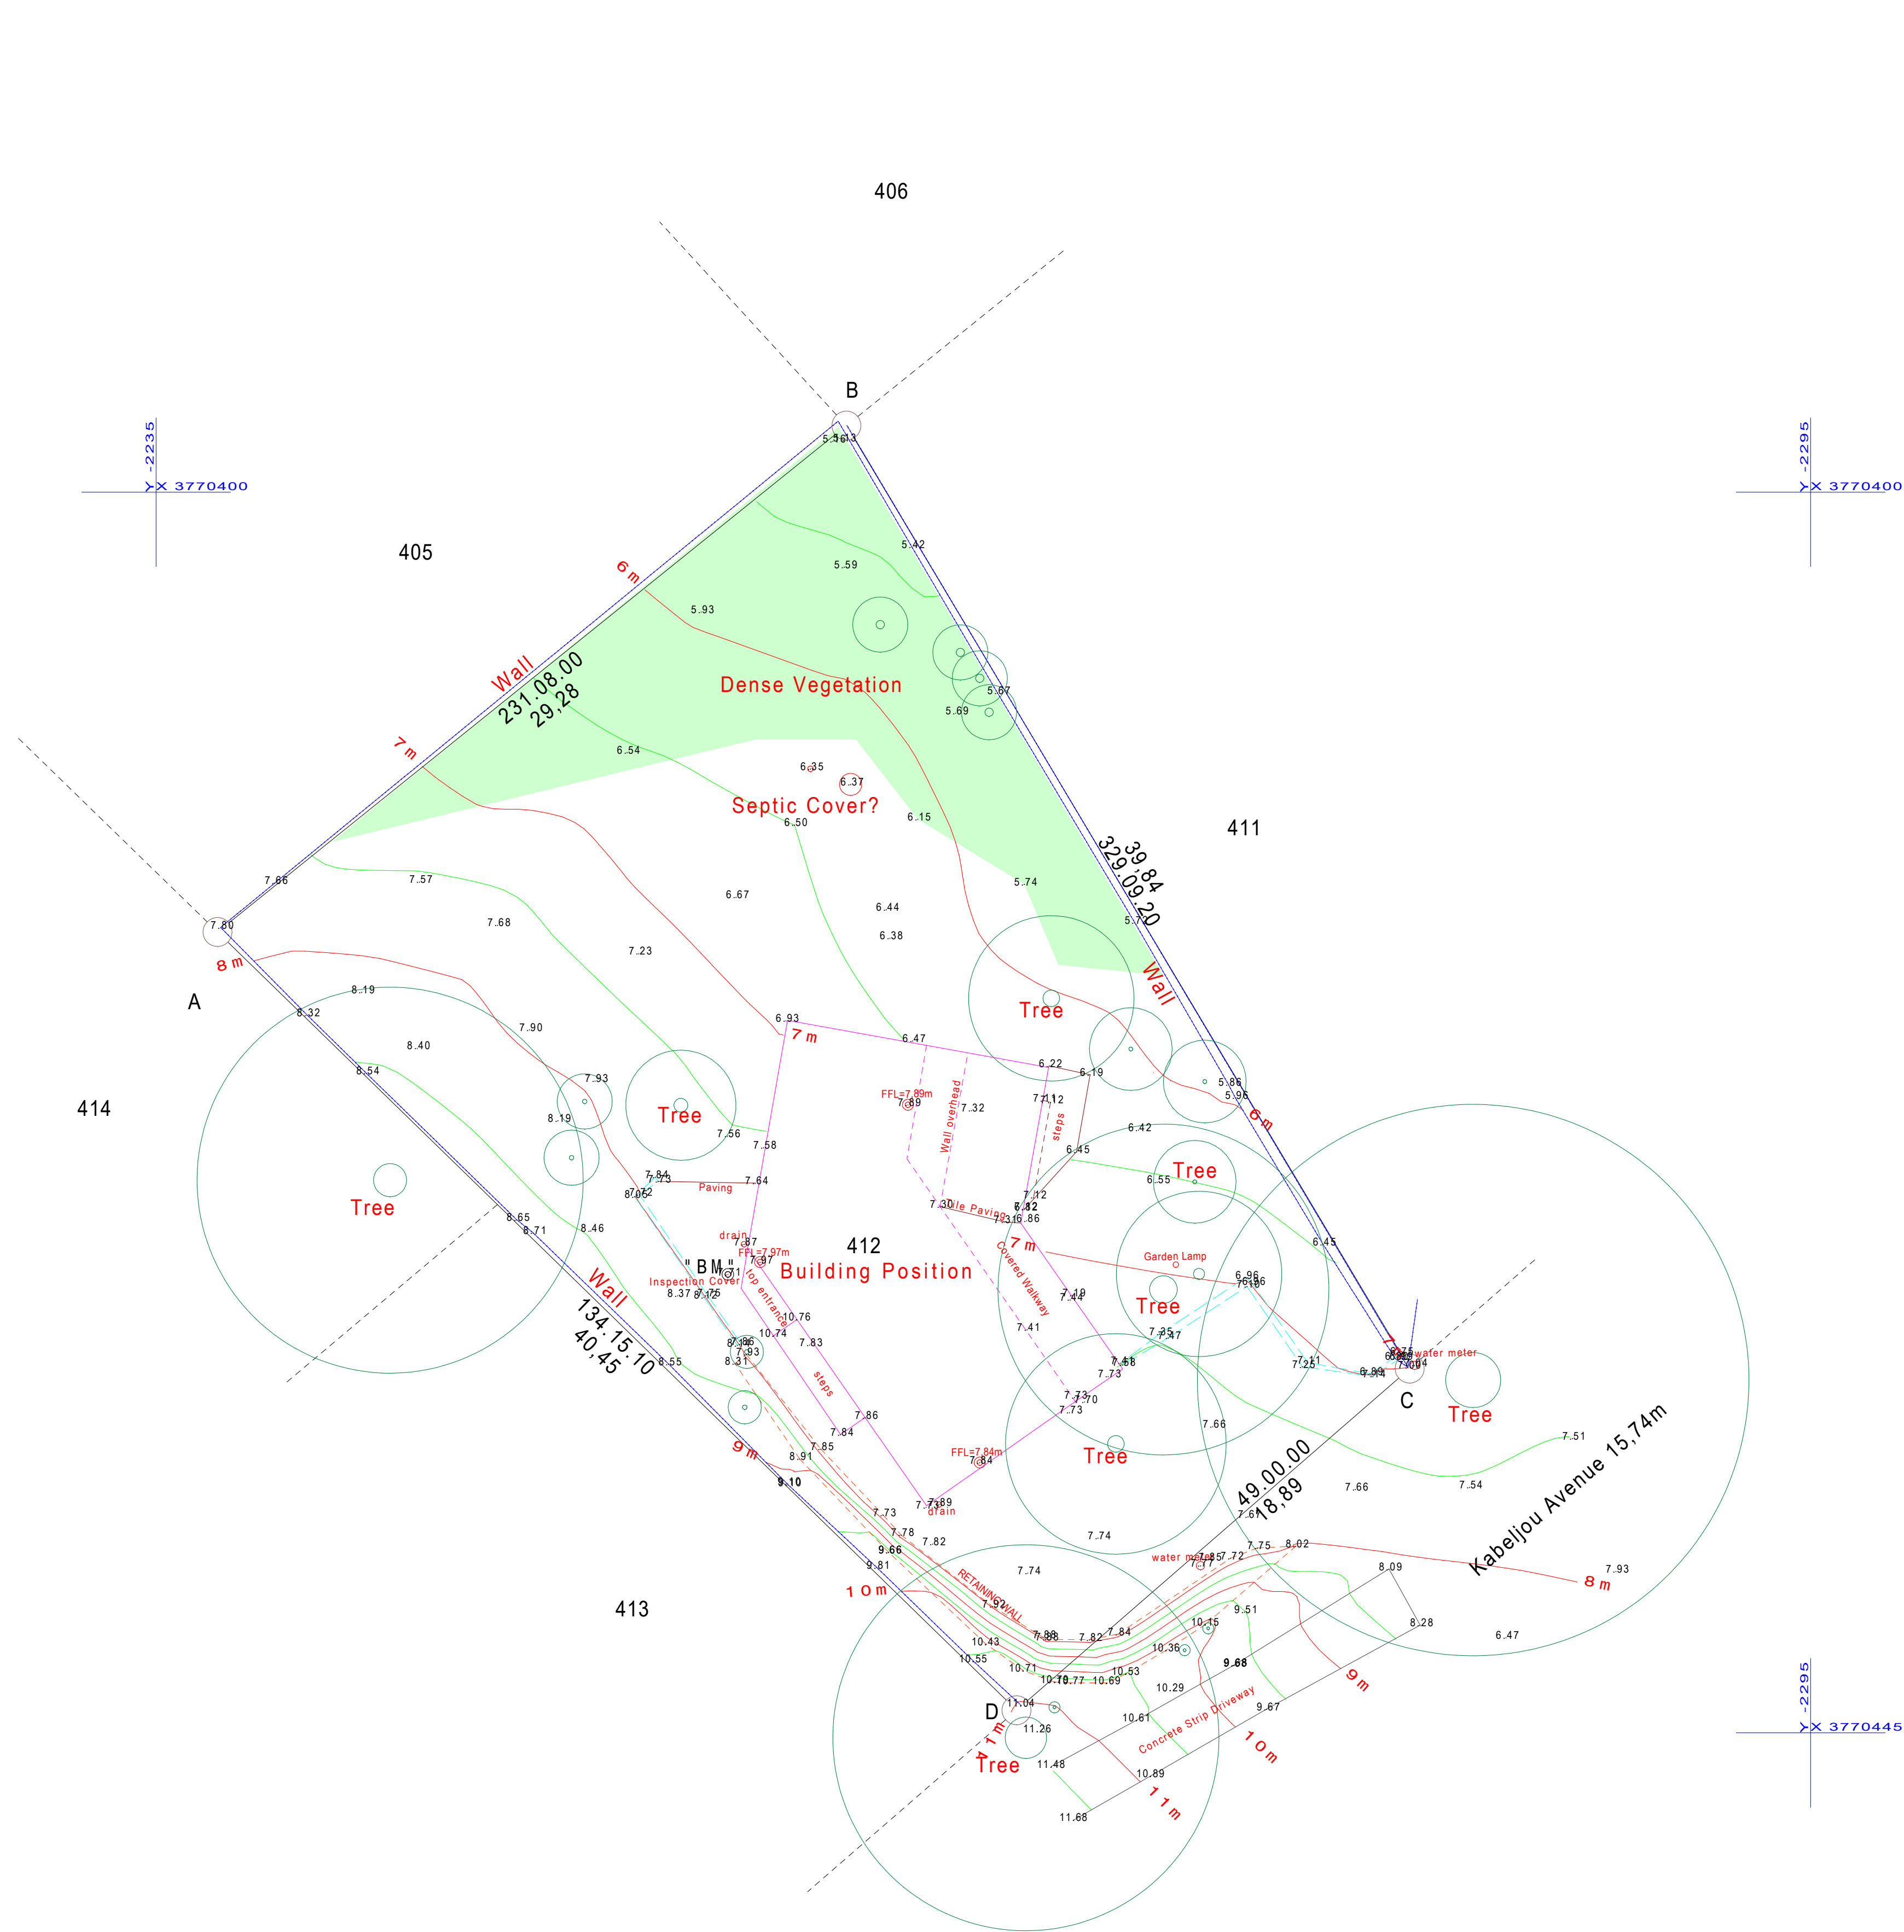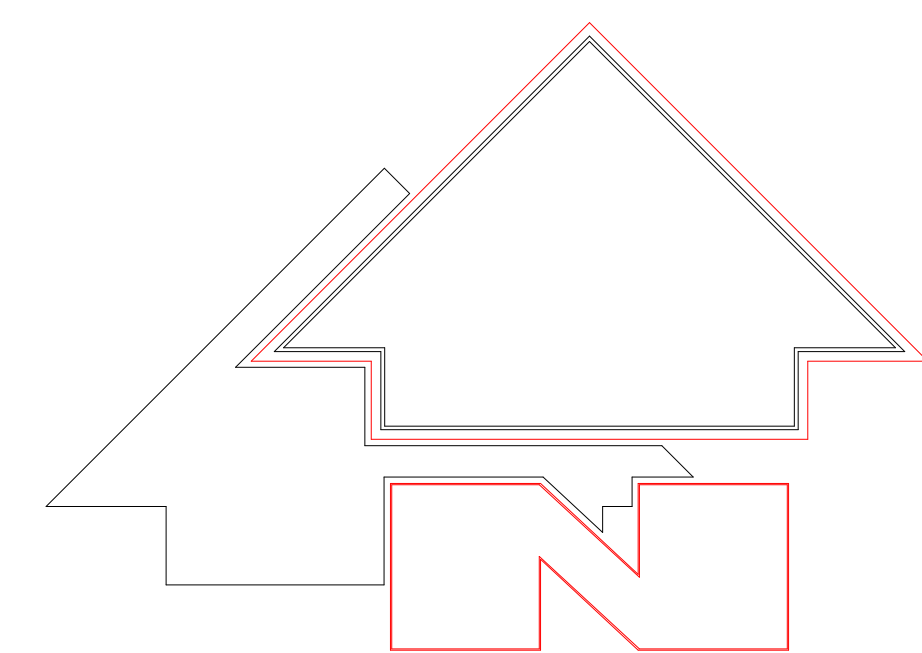

WG23
Scale 1:150, A1


- Notes :
- 1.Beacons verified as per GP T.P.7122
(see Beacon Certificate)
 - 2.Bench Mark = "BM" = Top Of Inspection Cover
HEIGHT = 7,71m above approximate Mean Sea Level
 - 3.Survey based on Control Station KN1 via Trignet Fix
Name Y = -3709.93 X = 3767688.50 Height = 4,16
= Town Survey Mark
 - 4.Beacon Descriptions
A,B.....Drill Hole on Top of Vibrecrete Post
C,D.....12mm Iron Pegs Next to Vibrecrete Post

This Plan may not be copied
or amended without the written
consent of VPM Surveys.

© 2016 VPM Surveys all rights Reserved

NO	DATE	DESCRIPTION
C		
B		
A		

REVISIONS	
DATE: 18/06/24	SCALE: 1:150, A1
SURVEYED ON: 10 & 13/06/24	SURVEYOR: W. BANTON (GPR LS 1559)
DRAWING FILE: SERVER://ALLYDATA/Brenton On Lake/ BL412BC CP	

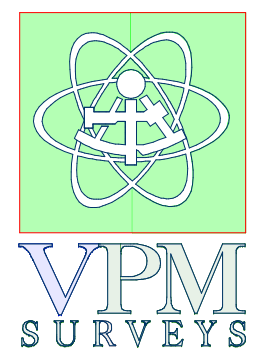

Professional Land Surveyors
Township Planners,
GIS & GPS consultants
Topographic, Sectional Title
& Engineering Surveys
16 Green Street P.O.Box 173
Knysna 6570
Tel: 044 3022300 Fax: 0866898908
e-mail: info@vpmsa.co.za

CLIENT
Dr I.S. Retief

PROJECT
Contour / Site Plan

TITLE
ERF 412
BRENTON ON LAKE
KNYSNA

DRG NO	REV
BL412CP	