

Annexure 7

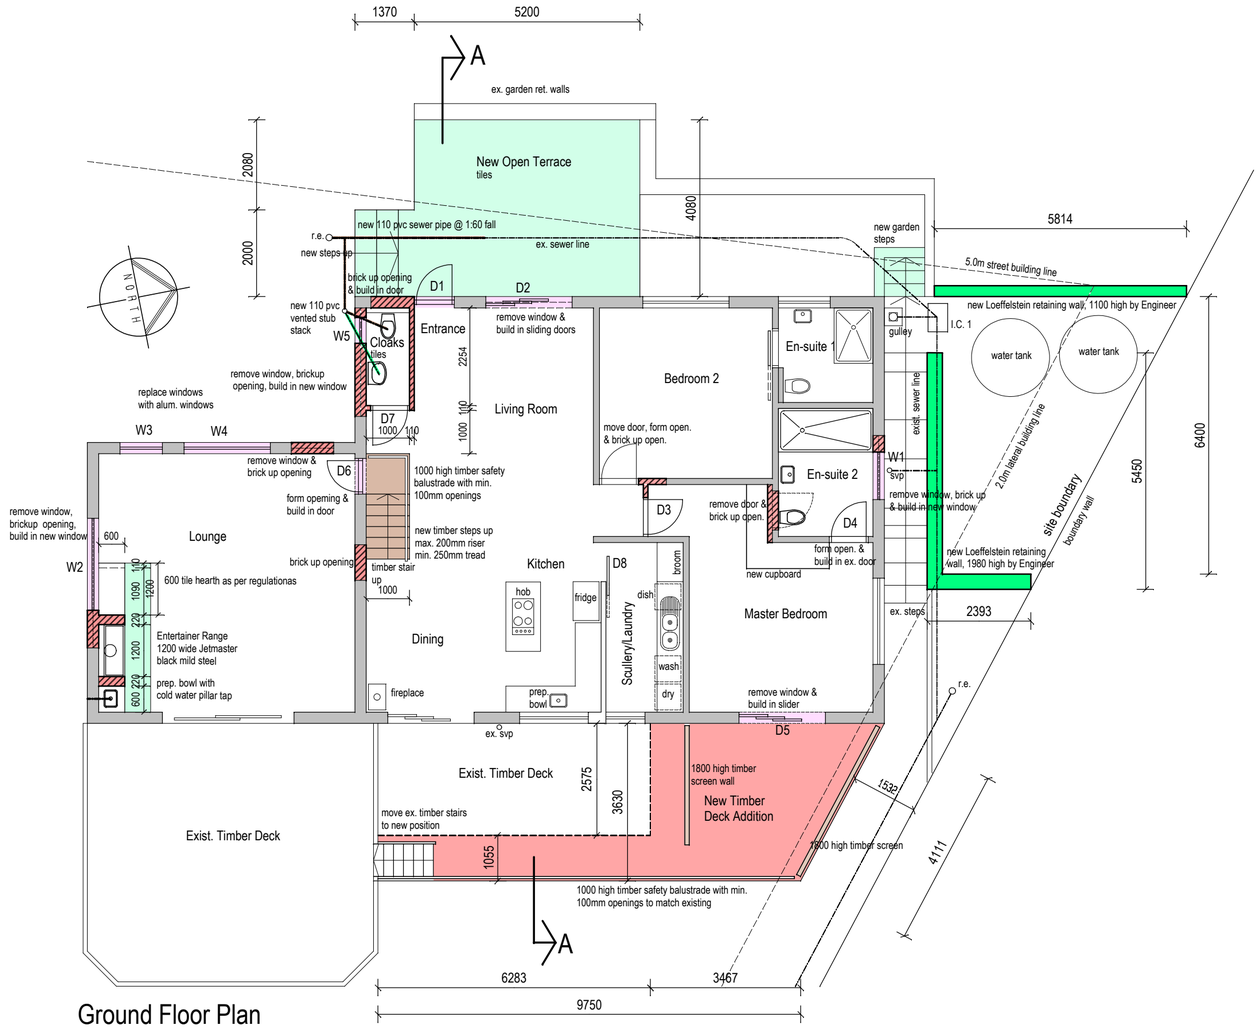


Ground Floor Plan
scale 1:100

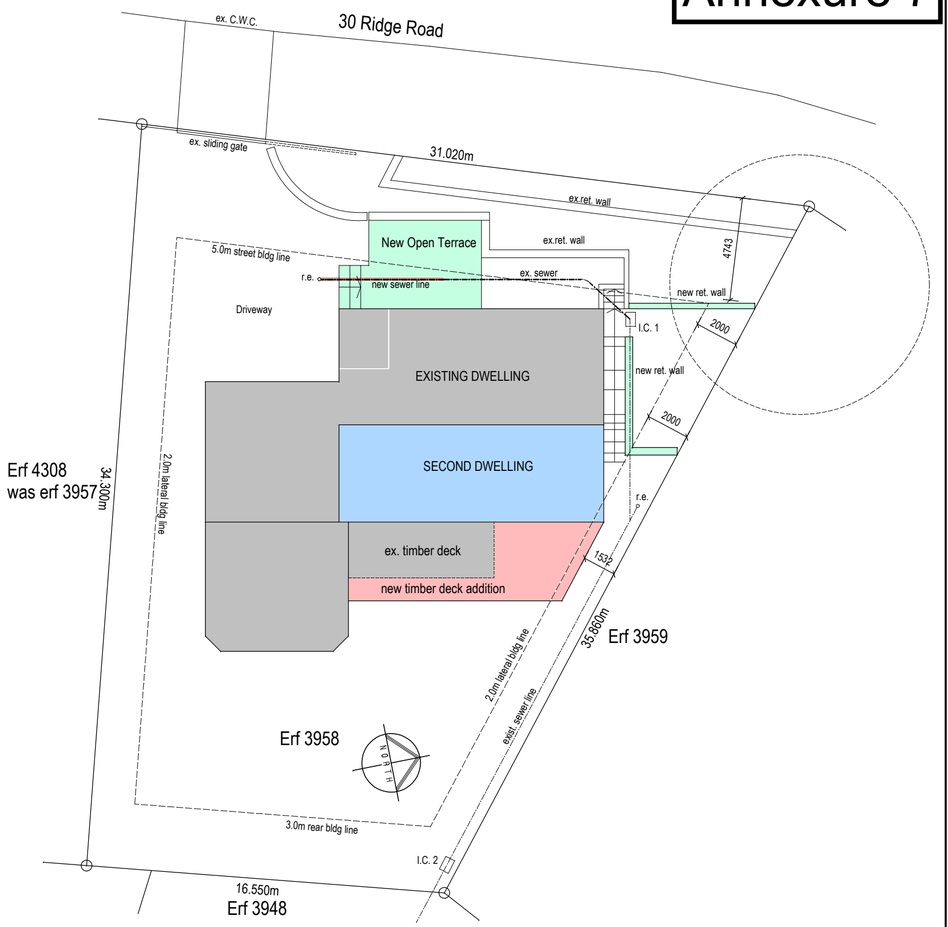


Site and Locality Plan
scale 1:200

RIDER TO PLAN No. 2025/44683
APPROVED 2025/04/08

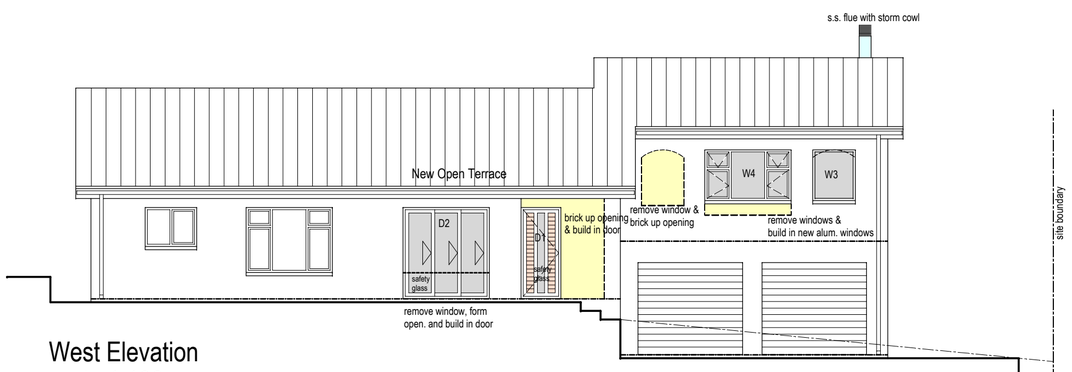

West Elevation
scale 1:100

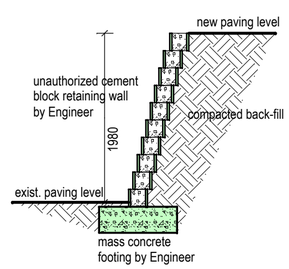

Typical Section thru.Block Retaining Wall
scale 1:50

Professional Senior Architectural Technologist
Signature:

Owners Signature:

BAUHAUS ARCHITEKTUR
Gunther M. A. Toll
Professional Senior Architectural Technologist (SACAP ST2203, SAIAT 32965)
Office: 062 6252 096 - Email: gunthertoll52@gmail.com - P.O. Box 1190
George, 6530 - 22 Swartberg Circle - Mont Fleur Mountain Estate - Blanco

Project: As-built Plans for Erf 3958, 60 Ridge Road, Knysna for Mr. Angus Young

Drawing Title: RIDER PLAN

Scale @ A2	Plot Date:	E.D.no.
as shown	13 may 2026	erf 3958 young rider plan
Project no. 2025/019	Drawing Number M002	Revision: