
S. G. Dgm. No. 2738/1861.

The numerical data of this diagram are sufficiently consistent.
Ded. Plan. 2601 JJ. (Sgd.) L. Marquard,
Examiner.

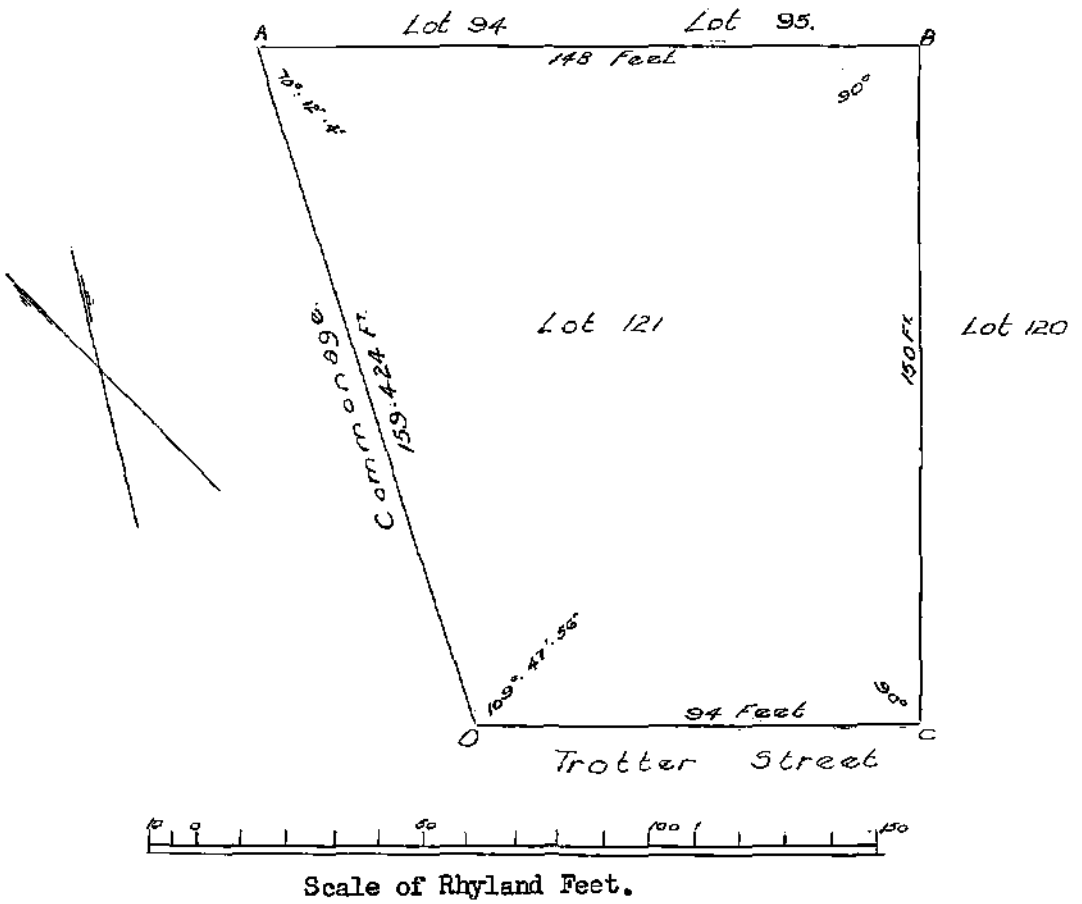

Scale of Rhyland Feet.

*NOW ERF 564 KNYSNA.

The above diagram A to D represents 126 Square Roods 6 Feet of ground, being portion of the part of the Farm, East Ford which was ceded by the late George Rex Esqr. to the Admiralty, and marked on the general plan of building allotments No. 121 as subdivided and marked on the ground by me, and situated in the Division of Knysna.

(Sgd.) R. M. Sparks,
Govt. Surveyor.

CANCELLED
VIDE Substituted dgm 4668/2002
SURVEYOR-GENERAL
2003. 01.28.

Copied from the diagram relating to
Quitrent. Kn.Q.10-18.
dated 24/9/1907. in favour of
J. J. Ferreira.
for
4/12/1957

AM-IAA/X.24.

M 3330

M 3328

564


DATA CHECKED MP 29.9.60.

G.M./C.F.L.

B/ BA1/2000

S. G. Dgm. No. 2738/1861.

The numerical data of this diagram are sufficiently consistent.
Ded. Plan. 2601 JJ. (Sgd.) L. Marquard,
Examiner.

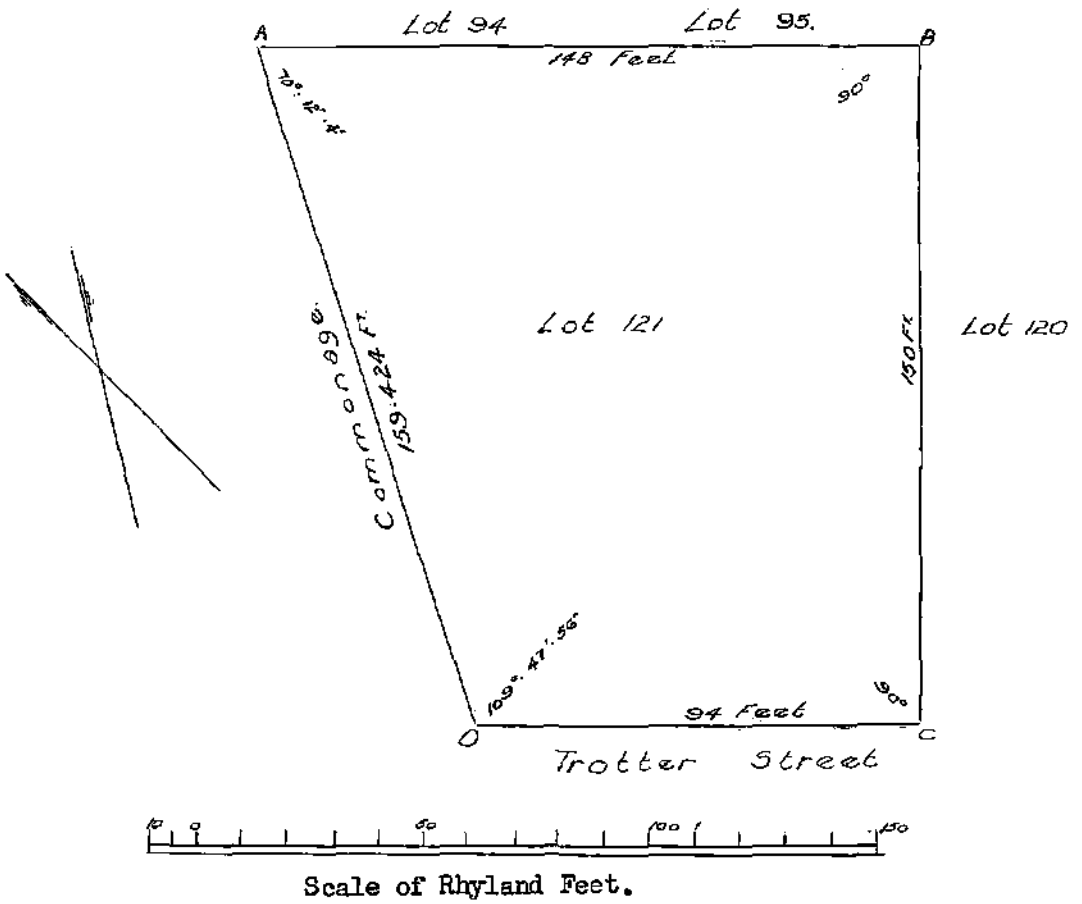

Scale of Rhyland Feet.

*NOW ERF 564 KNYSNA.

The above diagram A to D represents 126 Square Roods 6 Feet of ground, being portion of the part of the Farm, East Ford which was ceded by the late George Rex Esqr. to the Admiralty, and marked on the general plan of building allotments No. 121 as subdivided and marked on the ground by me, and situated in the Division of Knysna.

(Sgd.) R. M. Sparks,
Govt. Surveyor.

CANCELLED
VIDE Substituted dgm 4668/2002
SURVEYOR-GENERAL
2003. 01.28.

Copied from the diagram relating to
Quitrent. Kn.Q.10-18.
dated 24/9/1907. in favour of
J. J. Ferreira.
for
4/12/1957

AM-IAA/X.24.

M 3330

M 3328

564

DATA CHECKED MP 29.9.60.

G.M./C.F.L.

B/ BA1/2000

OFFICE COPY

	SIDES Metres	ANGLES OF DIRECTION		CO-ORDINATES Y System WG23° X	
		CONSTANT:		+ 0,00	+3760000,00
A B	50,08	282 18 20	A	- 4 025,48	+ 7 790,57
B C	46,99	12 04 30	B	- 4 074,41	+ 7 801,24
C D	32,78	102 23 40	C	- 4 064,58	+ 7 847,19
D A	50,09	171 52 40	D	- 4 032,56	+ 7 840,16
		KN 25	⊕	- 4 013,35	+ 7 743,59
		KN 26	⊕	- 4 027,45	+ 7 844,75

S.G. No.

4684/2002


Approved

for Surveyor-General

5-11-2002

Description of Beacons:

A C ..... 12mm iron peg
B ..... hole in concrete northwest of rail section
D ..... base of wooden fence post in concrete

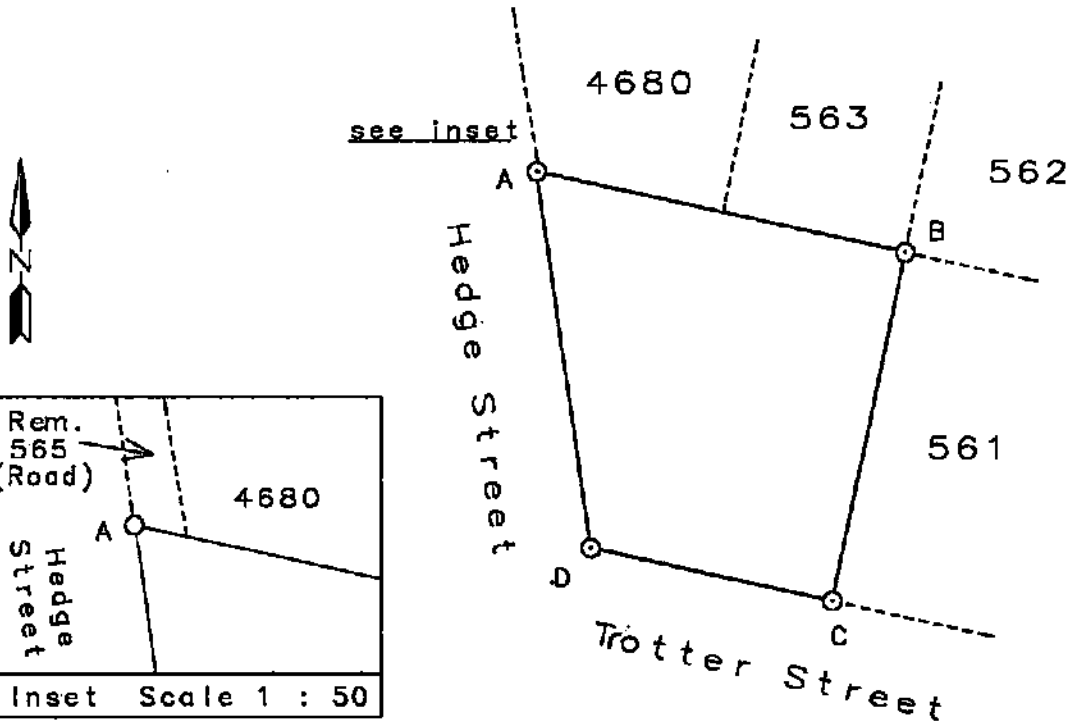

Scale 1 :1 000

The figure A B C D
represents **1 946 square metres** of land being
ERF 564 KNYSNA

situate in the Municipality and Administrative District of Knysna, Province of the Western Cape.

Surveyed in November 1999,
by me,

Professional Land Surveyor
M.D. de BruynPLS 0134

This diagram is annexed to No. T 1542/2003 dated i.f.o. Registrar of Deeds	The original diagram Is S.G. No. 2738/1861 Annexed to Title Deed No. Kn. Q.10-18	File No. S/4587/26/10 S.R. No.e E 2125/2002 Comp. AMNA-1362 (M3328) AMNA-1364 (M3330) Beacons C and D and Boundary CD acknowledged BA 001/2000

BEACONS B;D (i.t.o. Reg 1862)
REPLACED, VIDE E 2125/2002. See S/4587/26/10 pages 166 - 168