


WG23
Scale 1:100

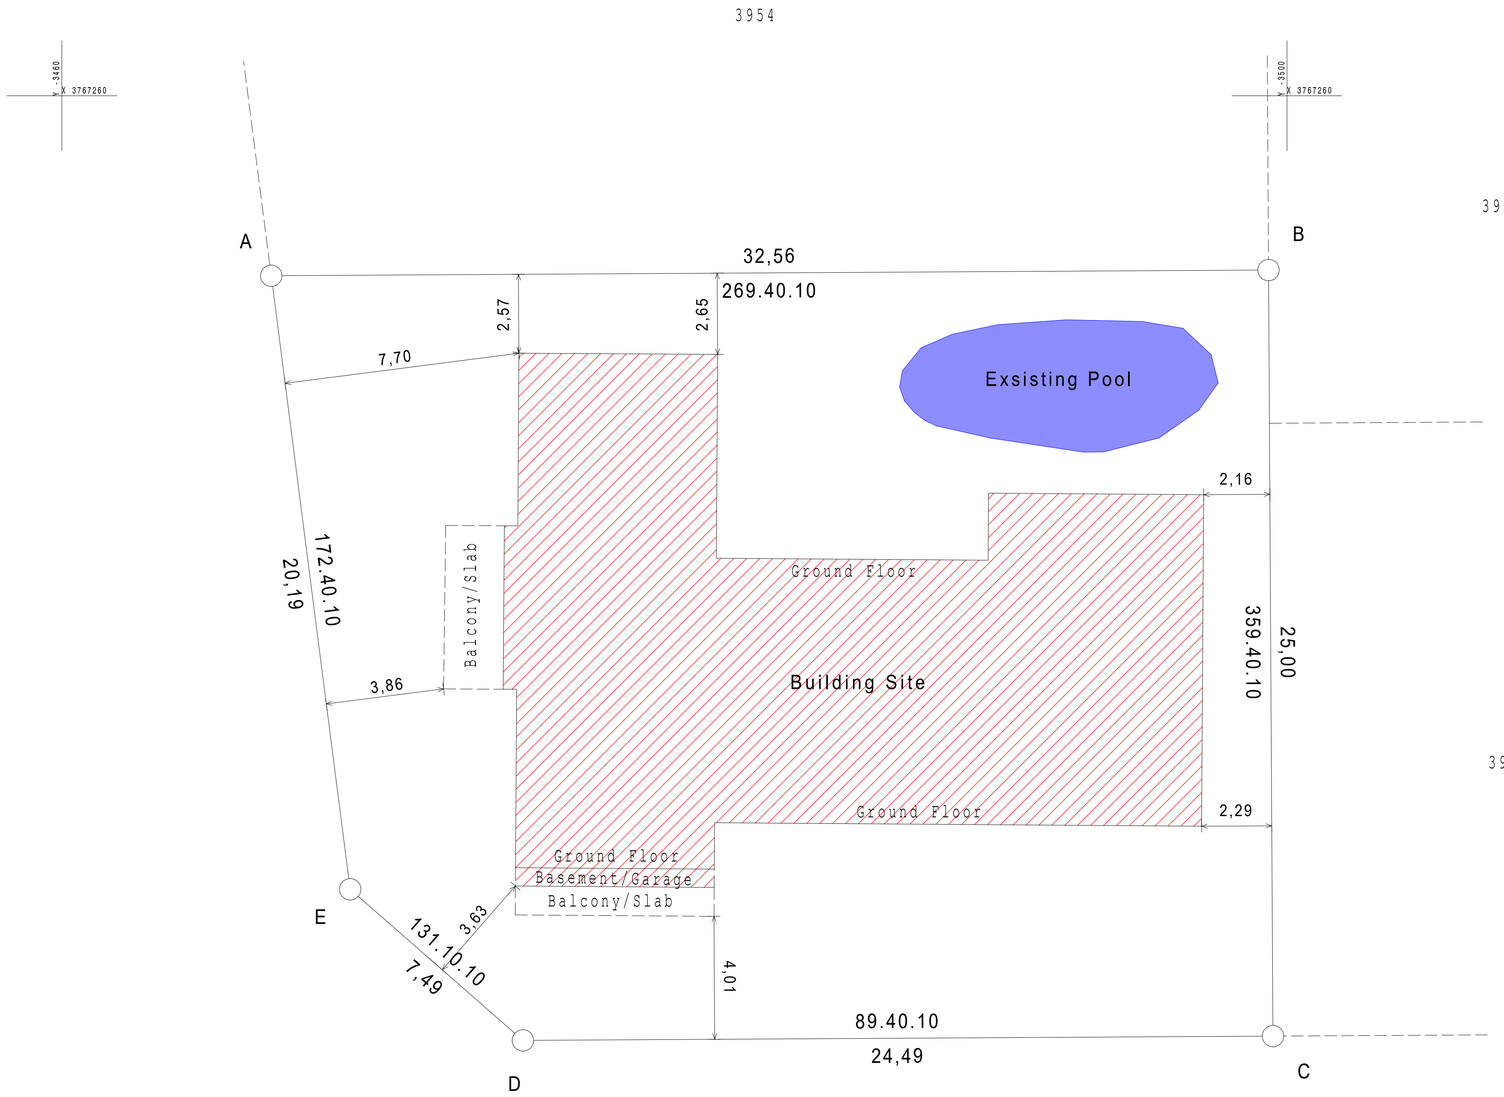

Notes :
1.Beacons verified as per General Plan TP No 8265
(see Beacon Certificate)

2.Beacon Descriptions
A.....Nail on Top of Wall
B.....North Eastern Corner of Lower Vibercrete Fence Post
C.....12mm Iron Peg in Concrete next to vibercrete Fence Post
D,E.....12mm Iron Pegs

3. The Building is still under construction at time of survey.

This Plan may not be copied
or amended without the written
consent of VPM Surveys.

© 2019 VPM Surveys all rights Reserved

NO	DATE	DESCRIPTION
C		
B		
A		

REVISIONS

DATE: 11/08/2019	SCALE: 1:100
SURVEYED ON: 08/02/2019	SURVEYOR: N. Kyriacos PLS1393
DRAWING FILE: SERVER://ALLYDAT3/Knysna/K3500-3999/K3953SP	

VPM SURVEYS
Professional Land Surveyors
Township Planners,
GIS & GPS consultants
Topographic, Sectional Title
& Engineering Surveys
16 Green Street P.O.Box 173
Knysna 6570
Tel: 044 3022300 Fax: 0866898908
e-mail: info@vpmsa.co.za

CLIENT
Brett Wiehahn

PROJECT
Contour / Site Plan

TITLE
ERF 3953
Knysna Heights
Knysna

DRG NO	REV
K3953SP	A