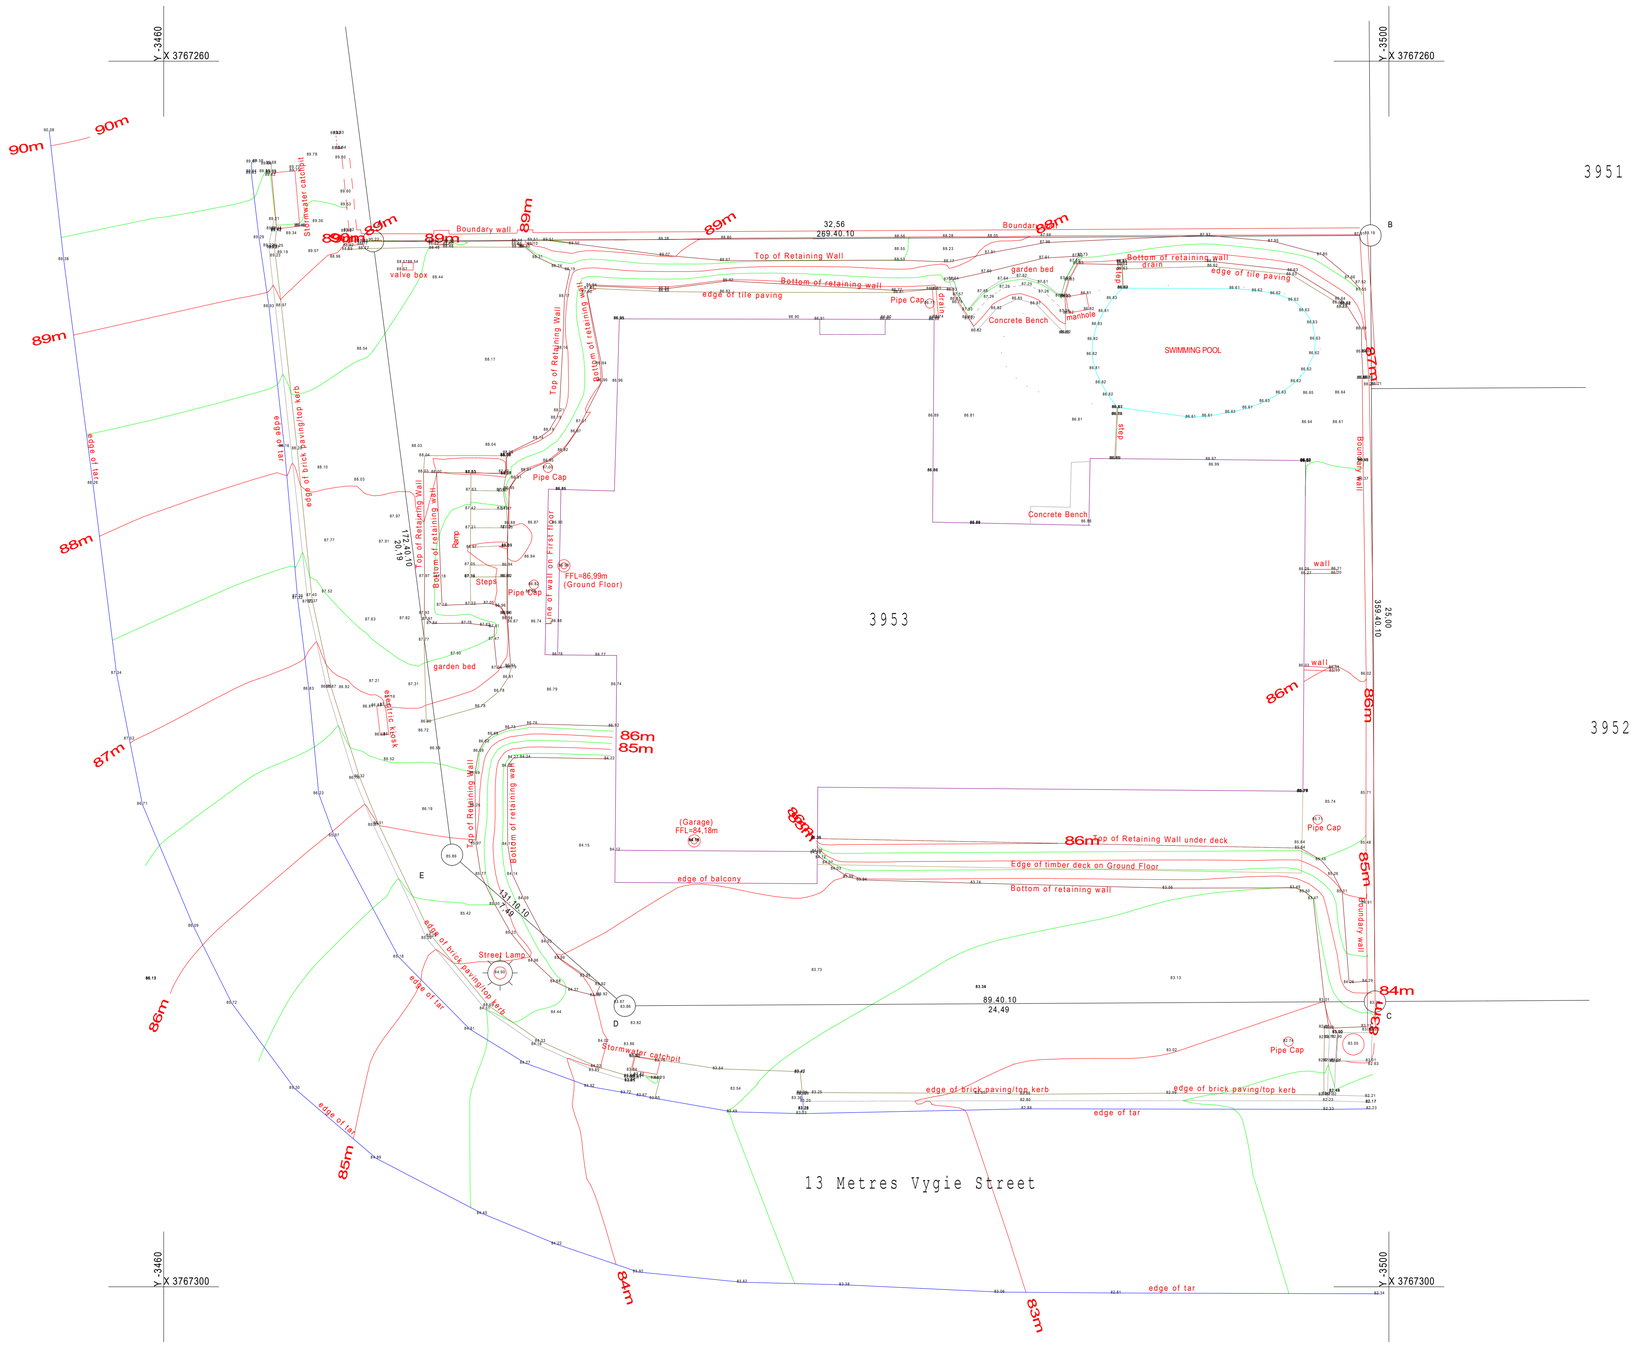


WG23

Scale 1:100, A1

Notes :

1.Beacons verified as per General Plan TP No 8265
(see Beacon Certificate)

2.Beacon Descriptions

A.....Nail on Top of Wall
B.....South Western Corner of Vibercrete Fence Post
C.....Nail in Concrete Next to Wall
D,E.....12mm Iron Pegs in Paving

This Plan may not be copied
or amended without the written
consent of VPM Surveys.

© 2025 VPM Surveys all rights Reserved

NO	DATE	DESCRIPTION
C		
B		
A		

REVISIONS

DATE: 07/04/2025 | SCALE: 1:100, A1

SURVEYED ON: 03/04/2025 | SURVEYOR: M. BANTOM (GPrLS 1559)

DRAWING FILE: SERVER://ALLYDAT4/Knysna/K1-10000/K3953BC CP REV A

Professional Land Surveyors

Township Planners,
GIS & GPS consultants
Topographic, Sectional Title
& Engineering Surveys

VPM SURVEYS

16 Green Street P.O.Box 173
Knysna 6570
Tel: 044 3022300 Fax: 0866898908
e-mail: info@vpmsa.co.za

CLIENT

Evelyn Pepler

PROJECT

Contour / Site Plan

TITLE

ERF 3953
Knysna Heights
Knysna

DRG NO	REV
K3953CP	A