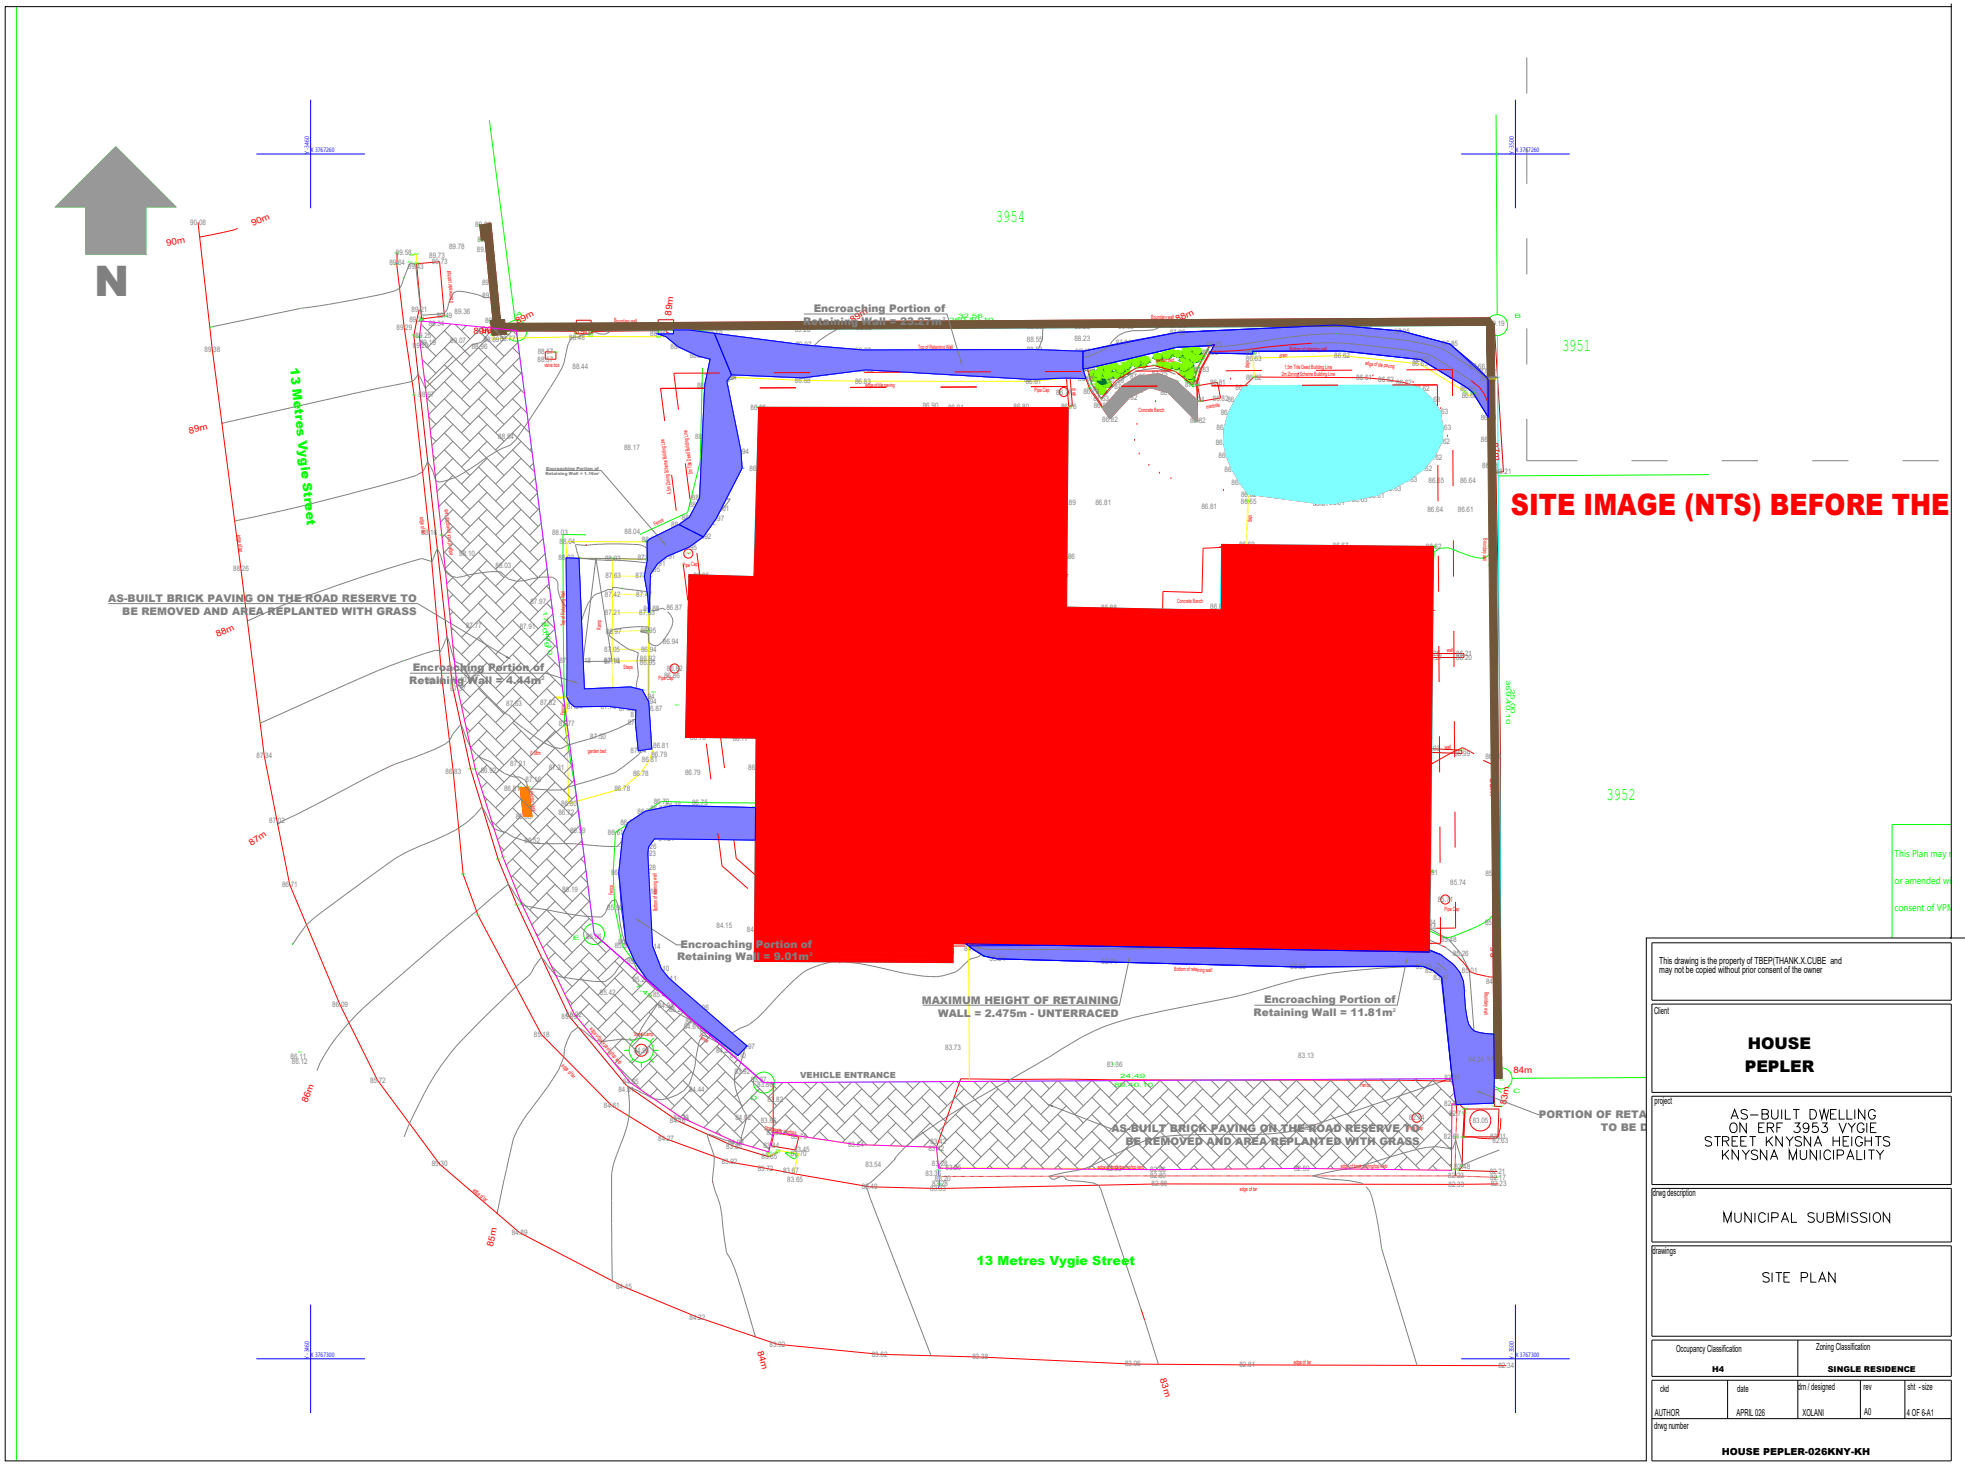


This drawing is the property of TREPTHANK.X.CUBE and may not be copied without prior consent of the owner

Client

HOUSE PEPLER

project

AS-BUILT DWELLING
ON ERF 3953 VYGIE
STREET KNYSNA HEIGHTS
KNYSNA MUNICIPALITY

dwg description

MUNICIPAL SUBMISSION

drawings

SITE PLAN

Occupancy Classification	Zoning Classification
H4	SINGLE RESIDENCE

ckd	date	drn / designed	rev	sht - size
AUTHOR	APRIL 026	XOLANI	A0	4 OF 6-A1

dwg number

HOUSE PEPLER-026KNY-KH