
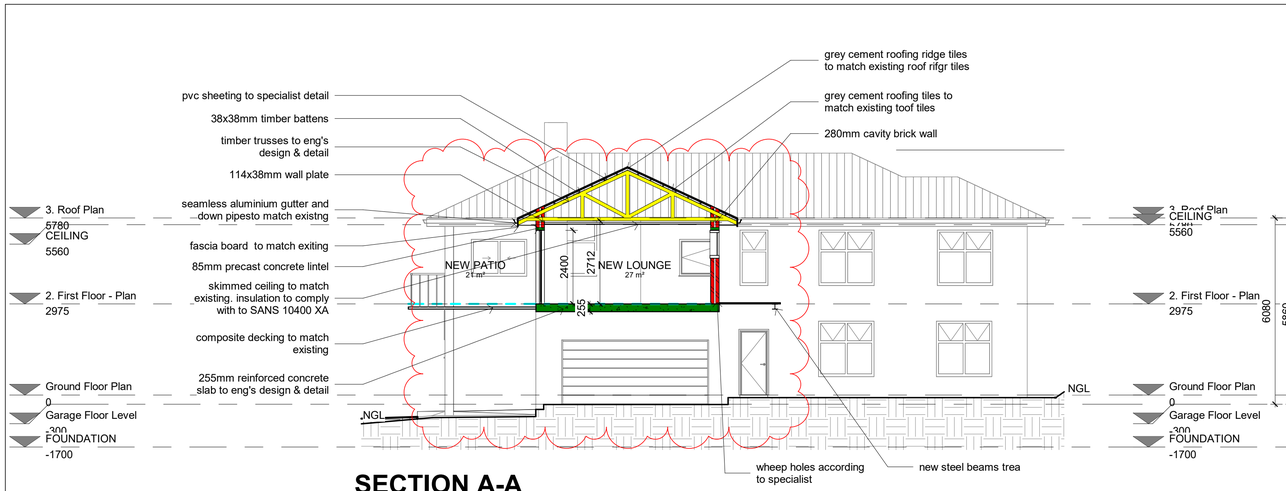



SECTION A-A

1 : 100

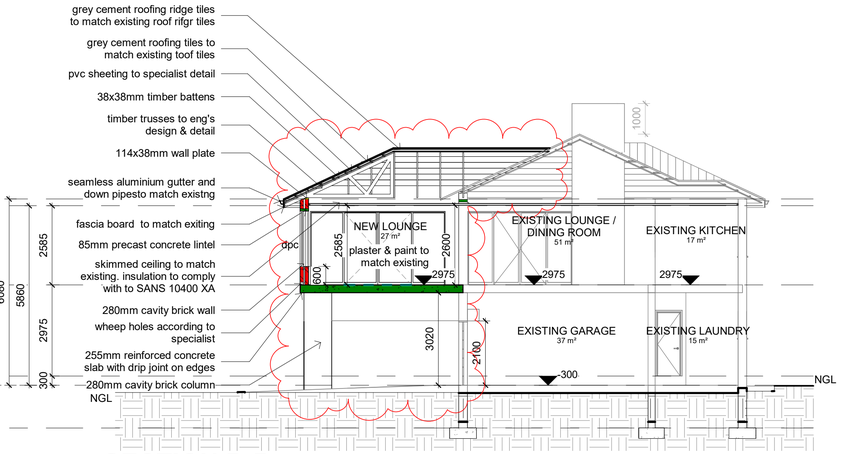


SECTION B-B

1 : 100

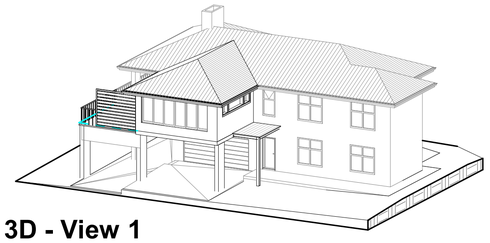


3D - View 1

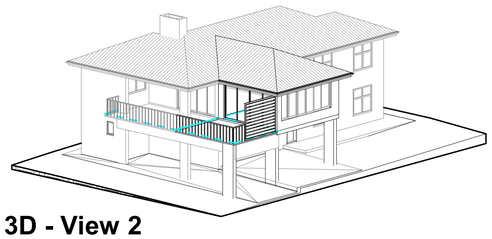


3D - View 2

NOTE:
All openings to be measured on site by manufacturer to ensure windows and doors fit properly to the opening.

Window Number	W.01
Window Description	Aluminium window window with two top hung windows on the sides
Frame Materials	Aluminium window frame as per manufacturer to match existing window frames
Frame Finish	Aluminium window frame powder coated to match existing window frames
Glazing	Glazing to match existing window gazing
Ironmongery	As per manufacturer

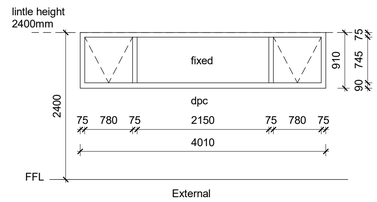

Door Number	D.01
Door Description	2400 x 4400mm Folding and stacking aluminium door
Frame Materials	Aluminium window frame as per manufacturer to match existing window frames
Frame Finish	Aluminium window frame powder coated to match existing window frames
Glazing	Glazing to match existing window gazing
Ironmongery	As per manufacturer

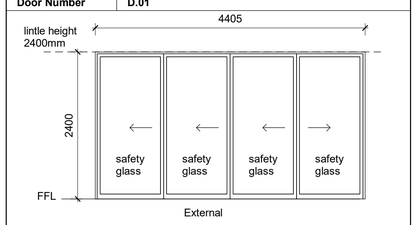

Door & Window Schedule

1 : 50

4. Site Plan

1 : 100

PROJECT

1 Adriatic Close

TITLE

SITE & ROOF PLAN

CLIENT


Mr. & Mrs. Ras


DRAWN BY	CHECKED BY	DATE
RR	.	2026/05/25


SCALE (@ A1)	PROJECT NUMBER
As indicated	002


DRAWING NUMBER	REV
A100	1


2026/09/07 20:19:27

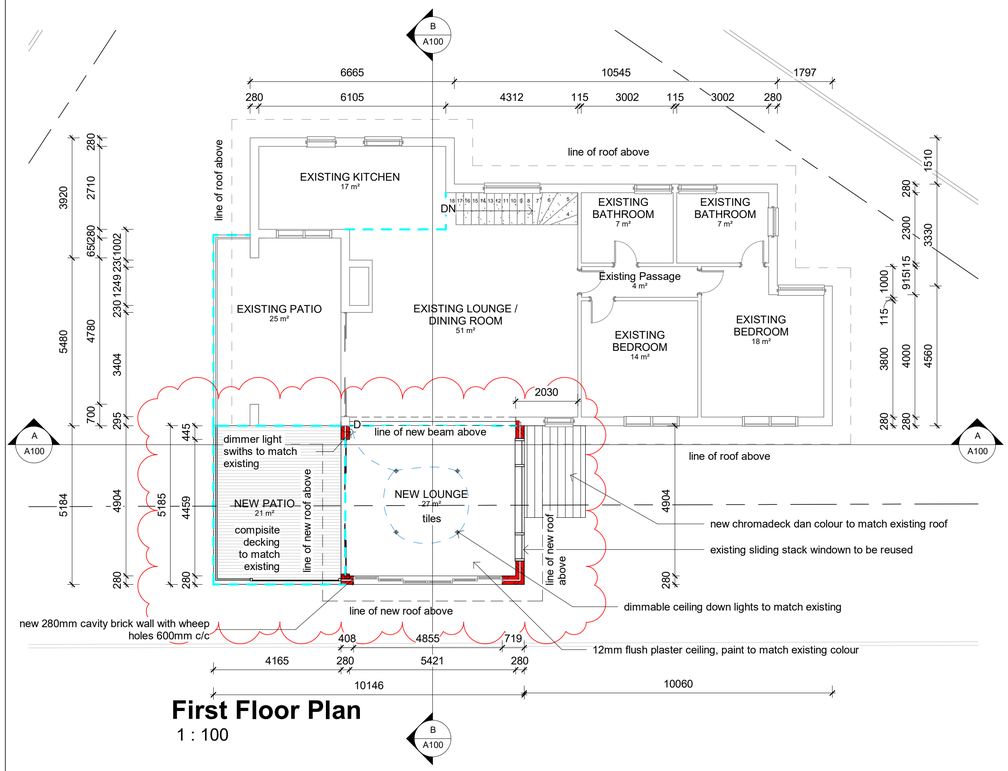

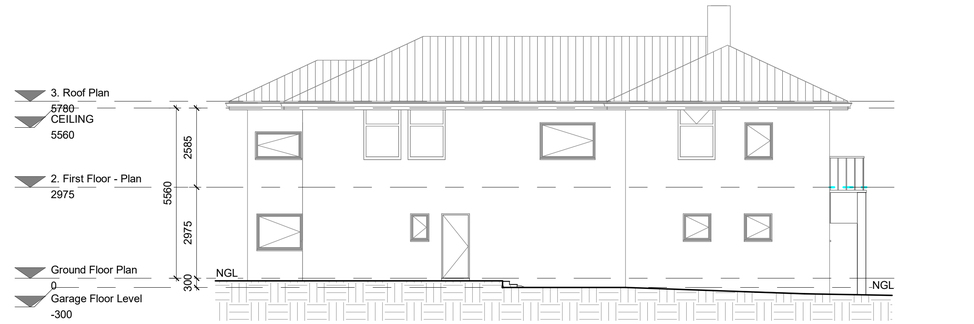

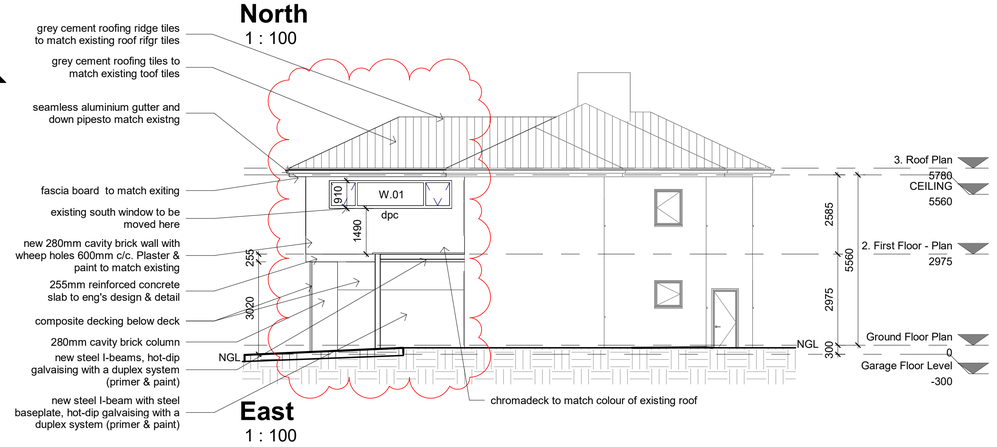

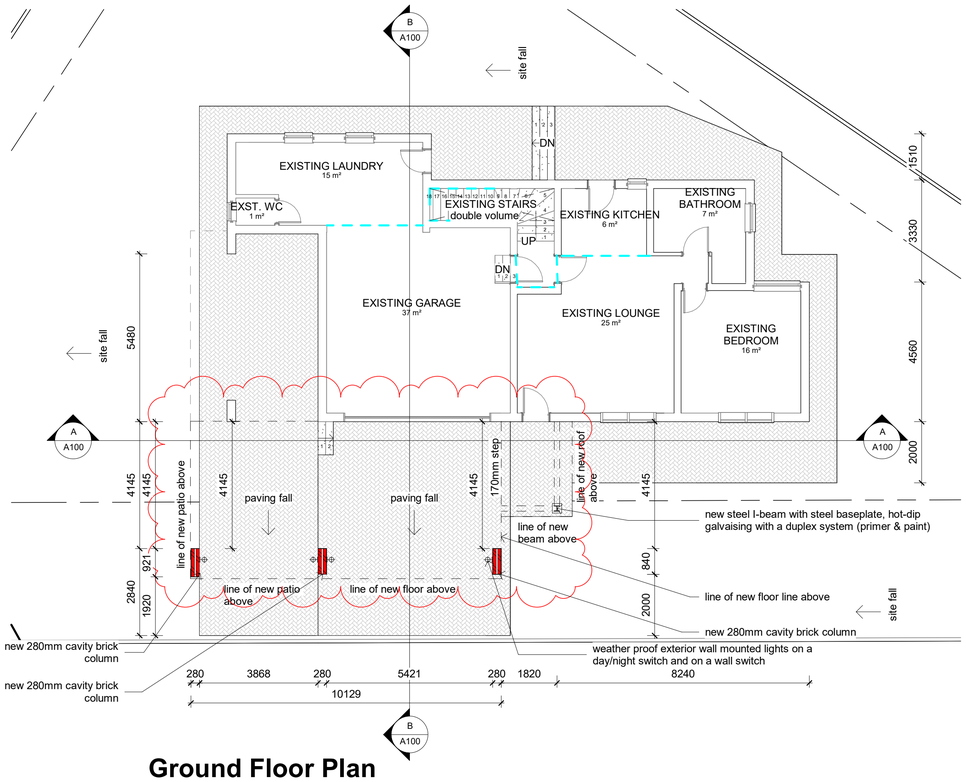

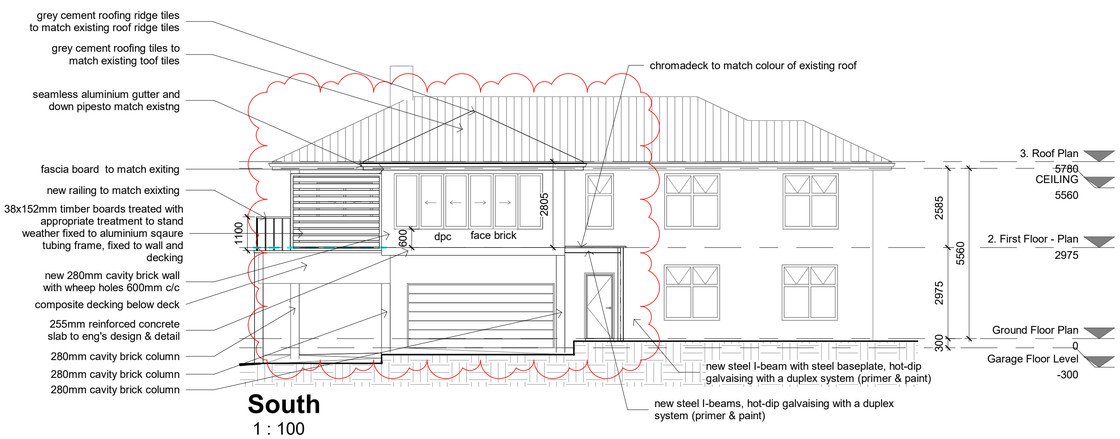



PROJECT

1 Adriatic Close

TITLE

GROUND ,FIRST FLOOR & ELEVATIONS

CLIENT

Mr. & Mrs. Ras

DRAWN BY	CHECKED BY	DATE
RR	.	2026/05/25

SCALE (@ A1)	PROJECT NUMBER
1 : 100	002

DRAWING NUMBER	PAGE
A101	1